

Reference Document 1


**Hazardous Waste Storage Facility
Anchorage Landfill as Built**

221-34


HAZARDOUS WASTE STORAGE FACILITY

ANCHORAGE REGIONAL LANDFILL SITE

ANCHORAGE, ALASKA

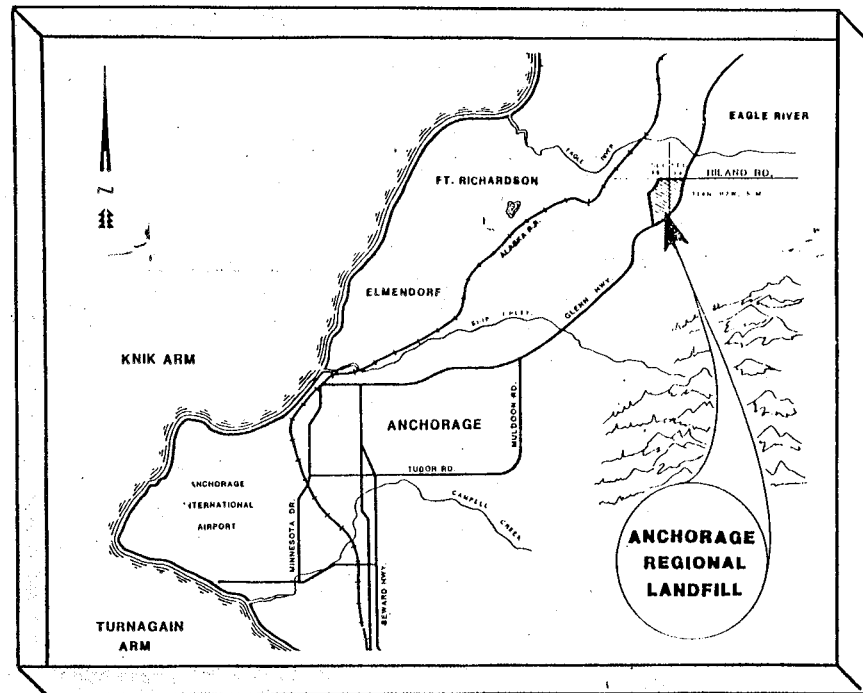

LOCATION MAP

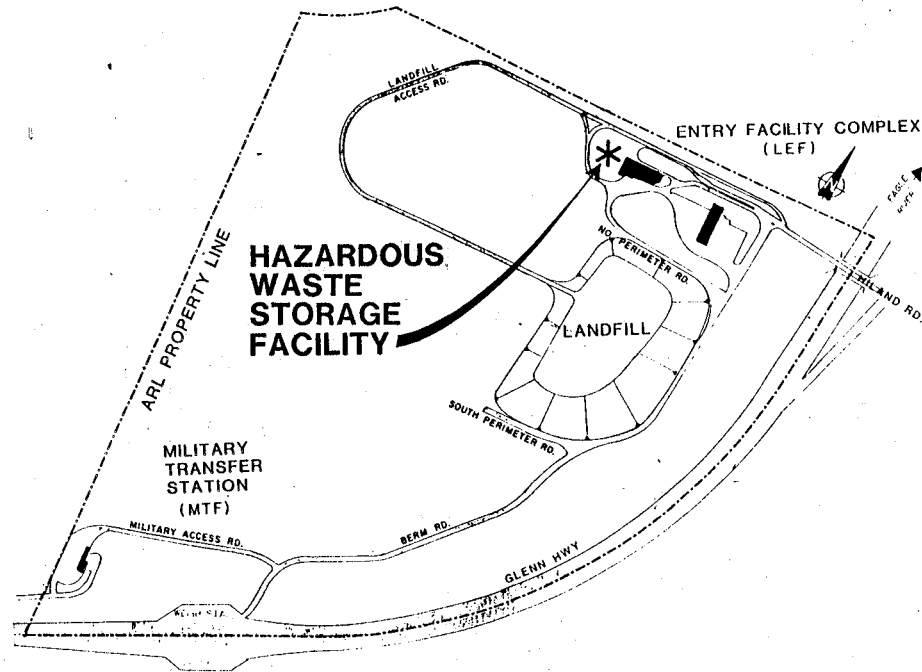

PROPERTY MAP

INDEX

SHT. NO.	DWG. NO.	DESCRIPTION
1	T-1	TITLE SHEET
		<u>GENERAL</u>
2	G-1	GENERAL LEGENDS AND ARCHITECTURAL AND STRUCTURAL ABBREVIATIONS AND SYMBOLS
3	G-2	PLB. AND HVAC ABBREVIATIONS AND SYMBOLS
4	G-3	ELECTRICAL SYMBOLS AND ABBREVIATIONS
		<u>CIVIL</u>
5	C-1	OVERALL SITE LOCATION PLAN
6	C-2	FACILITIES PLAN
7	C-3	LANDSCAPE PLAN
7A	C-3A	LANDSCAPE DETAILS
8	C-4	GRADING PLAN
9	C-5	ON-SITE SEWAGE DISPOSAL PLAN
9A	C-6	UTILITIES PLAN
9B	C-7	DETAILS
		<u>ARCHITECTURAL/STRUCTURAL</u>
10	AS-1	FOUNDATION PLAN
11	AS-2	FIRST FLOOR PLAN
12	AS-3	BUILDING ELEVATIONS
13	AS-4	BUILDING SECTIONS AND WALL SECTION
14	AS-5	DOOR AND ROOM FINISH SCHEDULES
15	AS-6	ARCHITECTURAL DETAILS
16	AS-7	ARCHITECTURAL DETAILS
17	AS-8	STRUCTURAL DETAILS
18	AS-9	STRUCTURAL DETAILS
19	AS-10	STRUCTURAL DETAILS
		<u>PLUMBING/FIRE PROTECTION</u>
20	P/FP-1	PLB./FIRE PROTECTION FLOOR PLAN
21	P/FP-2	PLB./FIRE PROTECTION STANDARDS DTLS.
22	P/FP-3	PLB. SCHEMATICS
		<u>HVAC</u>
23	H-1	HVAC FLOOR PLAN
24	H-2	HVAC SCHEDULES
25	H-3	HVAC STANDARD DETAILS
26	H-4	HVAC STANDARD DETAILS
27	H-5	HVAC SECTIONS AND STANDARD DETAILS
		<u>ELECTRICAL</u>
28	E-1	LIGHTING FLOOR PLAN
29	E-2	POWER FLOOR PLAN
30	E-3	SCHEDULES AND DIAGRAMS
31	E-4	RISERS AND SCHEDULES



TITLE SHEET

Scale	AS NOTED	Date	2/5/88	Designer	RLK	Drafter	RLK	Checker	RLK	Approver	KEH	No.	Revisions	By	Date

Donohue
Engineers & Architects
COMPUTER AIDED DESIGN/DRAFTING
REGISTERED PROFESSIONAL ENGINEERS
ANCHORAGE, ALASKA

CONTRACT DRAWINGS
HAZARDOUS WASTE STORAGE FACILITY
ANCHORAGE REGIONAL LANDFILL SITE
ANCHORAGE, ALASKA

Sheet No. 1
File No. A-50885
Project No. 15286

T-1
Drawing No.

221-33


8 7 6 5 4 3 2 1

GENERAL LEGENDS

DISCIPLINE DESIGNATION


DISCIPLINE	DISCIPLINE IDENTIFIER	DISCIPLINE STANDARD DETAIL NUMBERS
GENERAL	G	00-99
CIVIL	C	900-999
ELECTRICAL-SITE PLAN	CE	900-999
ARCHITECTURAL	A	100-299
STRUCTURAL	S	300-399
PLUMBING	P	600-699
HVAC	H	700-799
ELECTRICAL	E	900-999

DRAWING NUMBER DESIGNATION

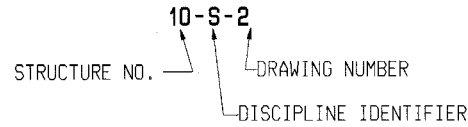


DETAIL AND SECTION DESIGNATION

ON DRAWING WHERE SECTION OR DETAIL IS TAKEN: ON DRAWING WHERE SECTION OR DETAIL IS SHOWN:

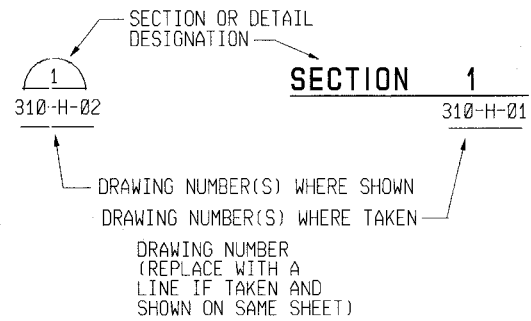

STANDARD DETAIL DESIGNATION

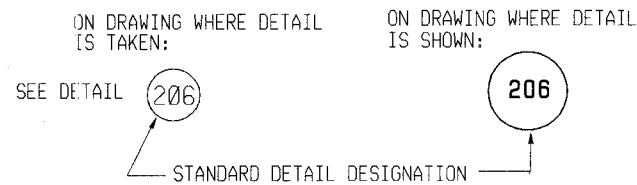

NOTE:

- 1) ANY ABBREVIATIONS USED IN THE CONTRACT DRAWINGS BUT NOT INCLUDED IN THE LIST OF ABBREVIATIONS SHOWN ARE TAKEN FROM THE 1976 CONSTRUCTION SPECIFICATIONS INSTITUTE (CSI) ABBREVIATION LISTING PUBLICATION MP-8
- 2) THE LIST OF SYMBOLS AND ABBREVIATIONS SHOWN IS A STANDARD LIST. NOT ALL SYMBOLS AND ABBREVIATIONS ARE USED IN THESE CONTRACT DRAWINGS.

TAG NUMBER DESIGNATION

EQUIPMENT PART OF AN INSTRUMENTATION CONTROL LOOP

[D-W-X-Y] - SEE PROCESS AND INSTRUMENTATION DIAGRAM LEGEND FOR EXPLANATION

INSTRUMENTATION IDENTIFICATION

FIC - SEE PROCESS AND INSTRUMENTATION DIAGRAM LEGEND FOR EXPLANATION

ARCHITECTURAL AND STRUCTURAL

ABBREVIATIONS

ADDL	ADDITIONAL
AL	ALUMINUM
ALT	ALTERNATE
B/	BOTTOM OF
BLK	BLOCK
BOT	BOTTOM
Ⓞ	CENTERLINE
CC	CONSTRUCTION CASTING
CONTR JT	CONTRACTION JOINT
CJT	CONTROL JOINT
CONT	CONTINUOUS
CONC	CONCRETE
CMU	CONCRETE MASONRY UNIT
DBL	DOUBLE
DWL	DOWEL
DIA	DIAMETER
DWG.	DRAWING
EA	EACH
EXT	EXTERIOR
EQUIP	EQUIPMENT
EWC	ELECTRIC WATER COOLER
EXP	EXPANSION
EL	ELEVATION
EXP JT	EXPANSION JOINT
EW	EACH WAY
EF	EACH FACE
FE	FIRE EXTINGUISHER
FTG	FOOTING
FD	FLOOR DRAIN
GA	GAUGE
GALV	GALVANIZED
HORIZ	HORIZONTAL
HP	HIGH POINT
INSUL	INSULATION
INT	INTERIOR
L	LINTEL
LP	LOW POINT
LLV	LONG LEG VERTICAL
LLH	LONG LEG HORIZONTAL
MFR	MANUFACTURER
MH	MANHOLE
MIN	MINIMUM
OC	ON CENTER
P	PLATE
PJF	PREFORMED JOINT FILLER
REINF	REINFORCING
RAD	RADIUS
REQD	REQUIRED
R	RISER
RD	ROOF DRAIN
SP	SPACE
SS	STAINLESS STEEL
STC	SOUND TRANSMISSION CLASS
STL	STEEL
SH	SHEET
SQ	SQUARE
T	TREAD
T/	TOP OF
T&B	TOP AND BOTTOM
TYP	TYPICAL
VERT	VERTICAL
WD	WOOD
WS	WATER STOP
W/	WITH

SYMBOLS

	INSULATION:NON-RIGID
	INSULATION RIGID
	INSULATING LIGHTWEIGHT CONCRETE
	SAND OR FILL
	GRAVEL FILL
	ROUGH CARPENTRY (NOMINAL SIZE INDICATED)
	FINISHED WOOD
	ACCOUSTICAL CONCRETE BLOCK
	CONCRETE BLOCK
	FACE BRICK
	PRECAST CONCRETE PLANK
	CAST-IN-PLACE CONCRETE
	EARTH OR BACKFILL
	CUT STONE (LARGE SCALE DETAILS)
	ELEVATION NUMBER
	SHOWN ON DRAWING NUMBER
	DENOTES LINTEL OVER LOUVER OR MISC. OPENING
	DENOTES LINTEL NUMBER
	BUILDING NUMBER
	DOOR NUMBER
	FIRE EXTINGUISHER

Scale	Date	Designer	Drafter	Checker	Approver	No.	Revisions	By	Date
NONE	2/9/88	A.B	VEN	DLS	P.E				

Donohue
Engineers & Architects
COMPUTER AIDED DESIGN/DRAFTING
REGISTERED PROFESSIONAL ENGINEERS
ANCHORAGE, ALASKA

CONTRACT DRAWINGS
HAZARDOUS WASTE STORAGE FACILITY
ANCHORAGE REGIONAL LANDFILL SITE
ANCHORAGE, ALASKA



GENERAL LEGENDS AND ARCHITECTURAL AND STRUCTURAL ABBREVIATIONS AND SYMBOLS

Sheet No.	2
File No.	A-50884
Project No.	15286
Drawing No.	G-1

REFERENCE FILES
B1-DWG 11
R2=11-20
R3=

NO. PLOT SCALE- PLOT (NAME) (FULL SIZE)

221-32

ABBREVIATIONS

Table of abbreviations including A (AIR), AC (AIR COMPRESSOR), BJD (BACK DRAFT DAMPER), B-P (BACKFLOW PREVENTER), CAL (COMBUSTION AIR LOUVER), CD (CEILING DIFFUSER), CF (CEILING FAN), CJH (CABINET HEATER), CP (CONDENSATE PUMP), DS (DOOR GRILLE), DV (DRAIN VALVE), EAL (EXHAUST AIR LOUVER), EG (EXHAUST GRILLE), EH (EXHAUST HOOD), ER (EXHAUST REGISTER), ESP (EXTERNAL STATIC PRESSURE), EWC (ELECTRIC WATER COOLER), FCU (FAN COIL UNIT), HRU (HEAT RECOVERY UNIT), HYU (HEATING & VENTILATING UNIT), HWA (HIGH WATER ALARM), HVL (HIGH WATER LEVEL), IH (INTAKE HOOD), LD (LINEAR DIFFUSER), LG (LINEAR GRILLE), LWA (LOW WATER ALARM), LNL (LOW WATER LEVEL), MAU (MAKE-UP AIR UNIT), MB (MOP BASIN), MOD (MOTOR OPERATED DAMPER), OAL (OUTDOOR AIR LOUVER), OP (OIL PUMP), P (PUMP), PRS (PRESSURE REDUCING STATION), RA (RETURN AIR), RG (RETURN GRILLE), RH (RELIEF HOOD), RTU (ROOF TOP UNIT), SD (SMOKE DAMPER), SG (SUPPLY GRILLE), SP (SUMP PUMP), SPD (SUMP PUMP DISCHARGE), SR (SUPPLY REGISTER), SS (SAMPLE SINK), TSP (TEMPERATURE CONTROL PANEL), TG (TRANSFER GRILLE), TSP (TOTAL STATIC PRESSURE), U (URINAL), VD (VOLUME DAMPER (MANUAL)), YP (YARD HYDRANT).

PIPE SYMBOLS

Table of pipe symbols for various water types and services, including ABOVE GRADE COLD WATER (W1), BELOW GRADE COLD WATER (W1), ABOVE GRADE HOT WATER (W1), ABOVE GRADE HOT WATER RETURN (W1), ABOVE GRADE COLD SOFT WATER (W1), ABOVE GRADE HOT SOFT WATER (W1), ABOVE GRADE SERVICE WATER-COLD (W2), BELOW GRADE SERVICE WATER-COLD (W2), ABOVE GRADE FLUSHING WATER (W3), BELOW GRADE FLUSHING WATER (W3), ABOVE GRADE STORM WATER, BELOW GRADE STORM WATER, ABOVE GRADE SANITARY SEWER, BELOW GRADE SANITARY SEWER, ABOVE GRADE VENT, BELOW GRADE VENT, ABOVE GRADE SANITARY SEWER (ACID RESISTANT), BELOW GRADE SANITARY SEWER (ACID RESISTANT), ABOVE GRADE VENT (ACID RESISTANT), BELOW GRADE VENT (ACID RESISTANT), SUMP PUMP DISCHARGE, VACUUM, NATURAL GAS, COMPRESSED AIR, HOT WATER HEATING SUPPLY, HOT WATER HEATING RETURN, REFRIGERANT GAS, SUCTION GAS REFRIGERANT, LIQUID REFRIGERANT, FUEL OIL DISCHARGE, FUEL OIL SUCTION, FUEL OIL RETURN, FUEL OIL VENT, DRAIN, EXPANSION TANK LINE.

PIPE SYMBOLS (CONT.)

Table of pipe symbols for steam and return lines, including BOILER BLOW DOWN, CONDENSATE PUMP DISCHARGE, HIGH PRESSURE STEAM, MEDIUM PRESSURE STEAM, LOW PRESSURE STEAM, HIGH PRESSURE RETURN, MEDIUM PRESSURE RETURN, LOW PRESSURE RETURN.

PIPE SPECIALTIES (GENERAL)

Table of pipe specialties for general use, including ELBOW, TEE, ELBOW UP, ELBOW DOWN, CONNECTION TOP, CONNECTION BOTTOM, UNION, PITCH ARROW-DOWN, FLOW DIRECTION, ECCENTRIC REDUCER, CONCENTRIC REDUCER, PIPE CAP, BLIND FLANGE, PLUG.

PIPE SPECIALTIES (PLUMBING)

Table of pipe specialties for plumbing, including FIRE HYDRANT, FLOOR DRAIN, ROOF DRAIN, GUTTER DRAIN, FLOOR CLEANOUT, SANITARY VENT, SANITARY VENT (ACID).

TEMPERATURE CONTROL SYMBOLS

Table of temperature control symbols, including TEMPERATURE CONTROL PANEL, THERMOSTAT, HUMIDISTAT.

PIPE SPECIALTIES (HVAC)

Table of pipe specialties for HVAC, including GUIDE, ANCHOR, FLOW MEASURING DEVICE, THERMOSTATIC TRAP, FLOAT & THERMOSTATIC TRAP, BUCKET TRAP, EXPANSION COMPENSATOR, FLEXIBLE CONNECTOR, HOT WATER CIRCULATION PUMP, FLOW SWITCH, PRESSURE SWITCH, AIR VENT, THERMOMETER, PRESSURE GAUGE.

VALVE SYMBOLS

Table of valve symbols, including WATER MAIN VALVE, WALL HYDRANT (NON-FREEZE), BOX HYDRANT (FROST PROOF), HOSE BIBB, GAS COCK, GAUGE COCK, PRESSURE REGULATING VALVE, BACKWATER VALVE, BALL VALVE, GATE VALVE, CHECK VALVE, BUTTERFLY VALVE, PLUG VALVE, CALIBRATED BALANCE VALVE, MODULATING 3-WAY VALVE, SOLENOID VALVE, MODULATING 2-WAY VALVE, GLOBE VALVE, STRAINER, PRESSURE REDUCING STATION (ASSEMBLY), RELIEF VALVE (PRESSURE OR VACUUM), UNCLASSIFIED.

DUCTWORK SYMBOLS

Table of ductwork symbols, including POSITIVE PRESSURE AIR DUCT RISE, POSITIVE PRESSURE AIR DUCT DROP, NEGATIVE PRESSURE AIR DUCT RISE, NEGATIVE PRESSURE AIR DUCT DROP, FLEXIBLE CONNECTION, MOTOR OPERATED DAMPER, MANUAL VOLUME DAMPER, SMOKE DAMPER, FIRE DAMPER (HORI. POSITION) CLASS A (FA), CLASS B (FB), FIRE DAMPER (VERT. POSITION) CLASS A (FA), CLASS B (FB), INTERNAL ACOUSTICAL INSULATION, EXTERNAL INSULATION, TURNING VANES, AIR EXTRACTOR, SPLITTER DAMPER, DOOR GRILLE OF TYPE, SIZE, AND CAPACITY INDICATED, SIDEWALL GRILLE OF TYPE, SIZE, AND CAPACITY INDICATED, CEILING GRILLE OF TYPE, SIZE, AND CAPACITY INDICATED, RECTANGULAR CEILING DIFFUSER OF TYPE, SIZE, AND CAPACITY INDICATED, ROUND CEILING DIFFUSER OF TYPE, SIZE, AND CAPACITY INDICATED, CHANGE OF ELEVATION RISE (R), DROP (D).

LISTED ABBREVIATIONS ARE SUPPLEMENTAL TO THE STANDARD ABBREVIATIONS LIST PUBLISHED BY THE CONSTRUCTION SPECIFICATIONS INSTITUTE, MOST RECENT EDITION.


Table for Scale, Date, Designer, Drafter, Checker, Approver, Revisions, No., By, Date.

Donohue Engineers & Architects, COMPUTER AIDED DESIGN/DRAFTING, ENGINEERS.

CONTRACT DRAWINGS, HAZARDOUS WASTE STORAGE FACILITY, ANCHORAGE REGIONAL LANDFILL SITE, ANCHORAGE, ALASKA.

Table with Sheet No. 3, File No. A-50883, Project No. 15286, Drawing No. G-2.

PLUMBING AND HVAC ABBREVIATIONS AND SYMBOLS

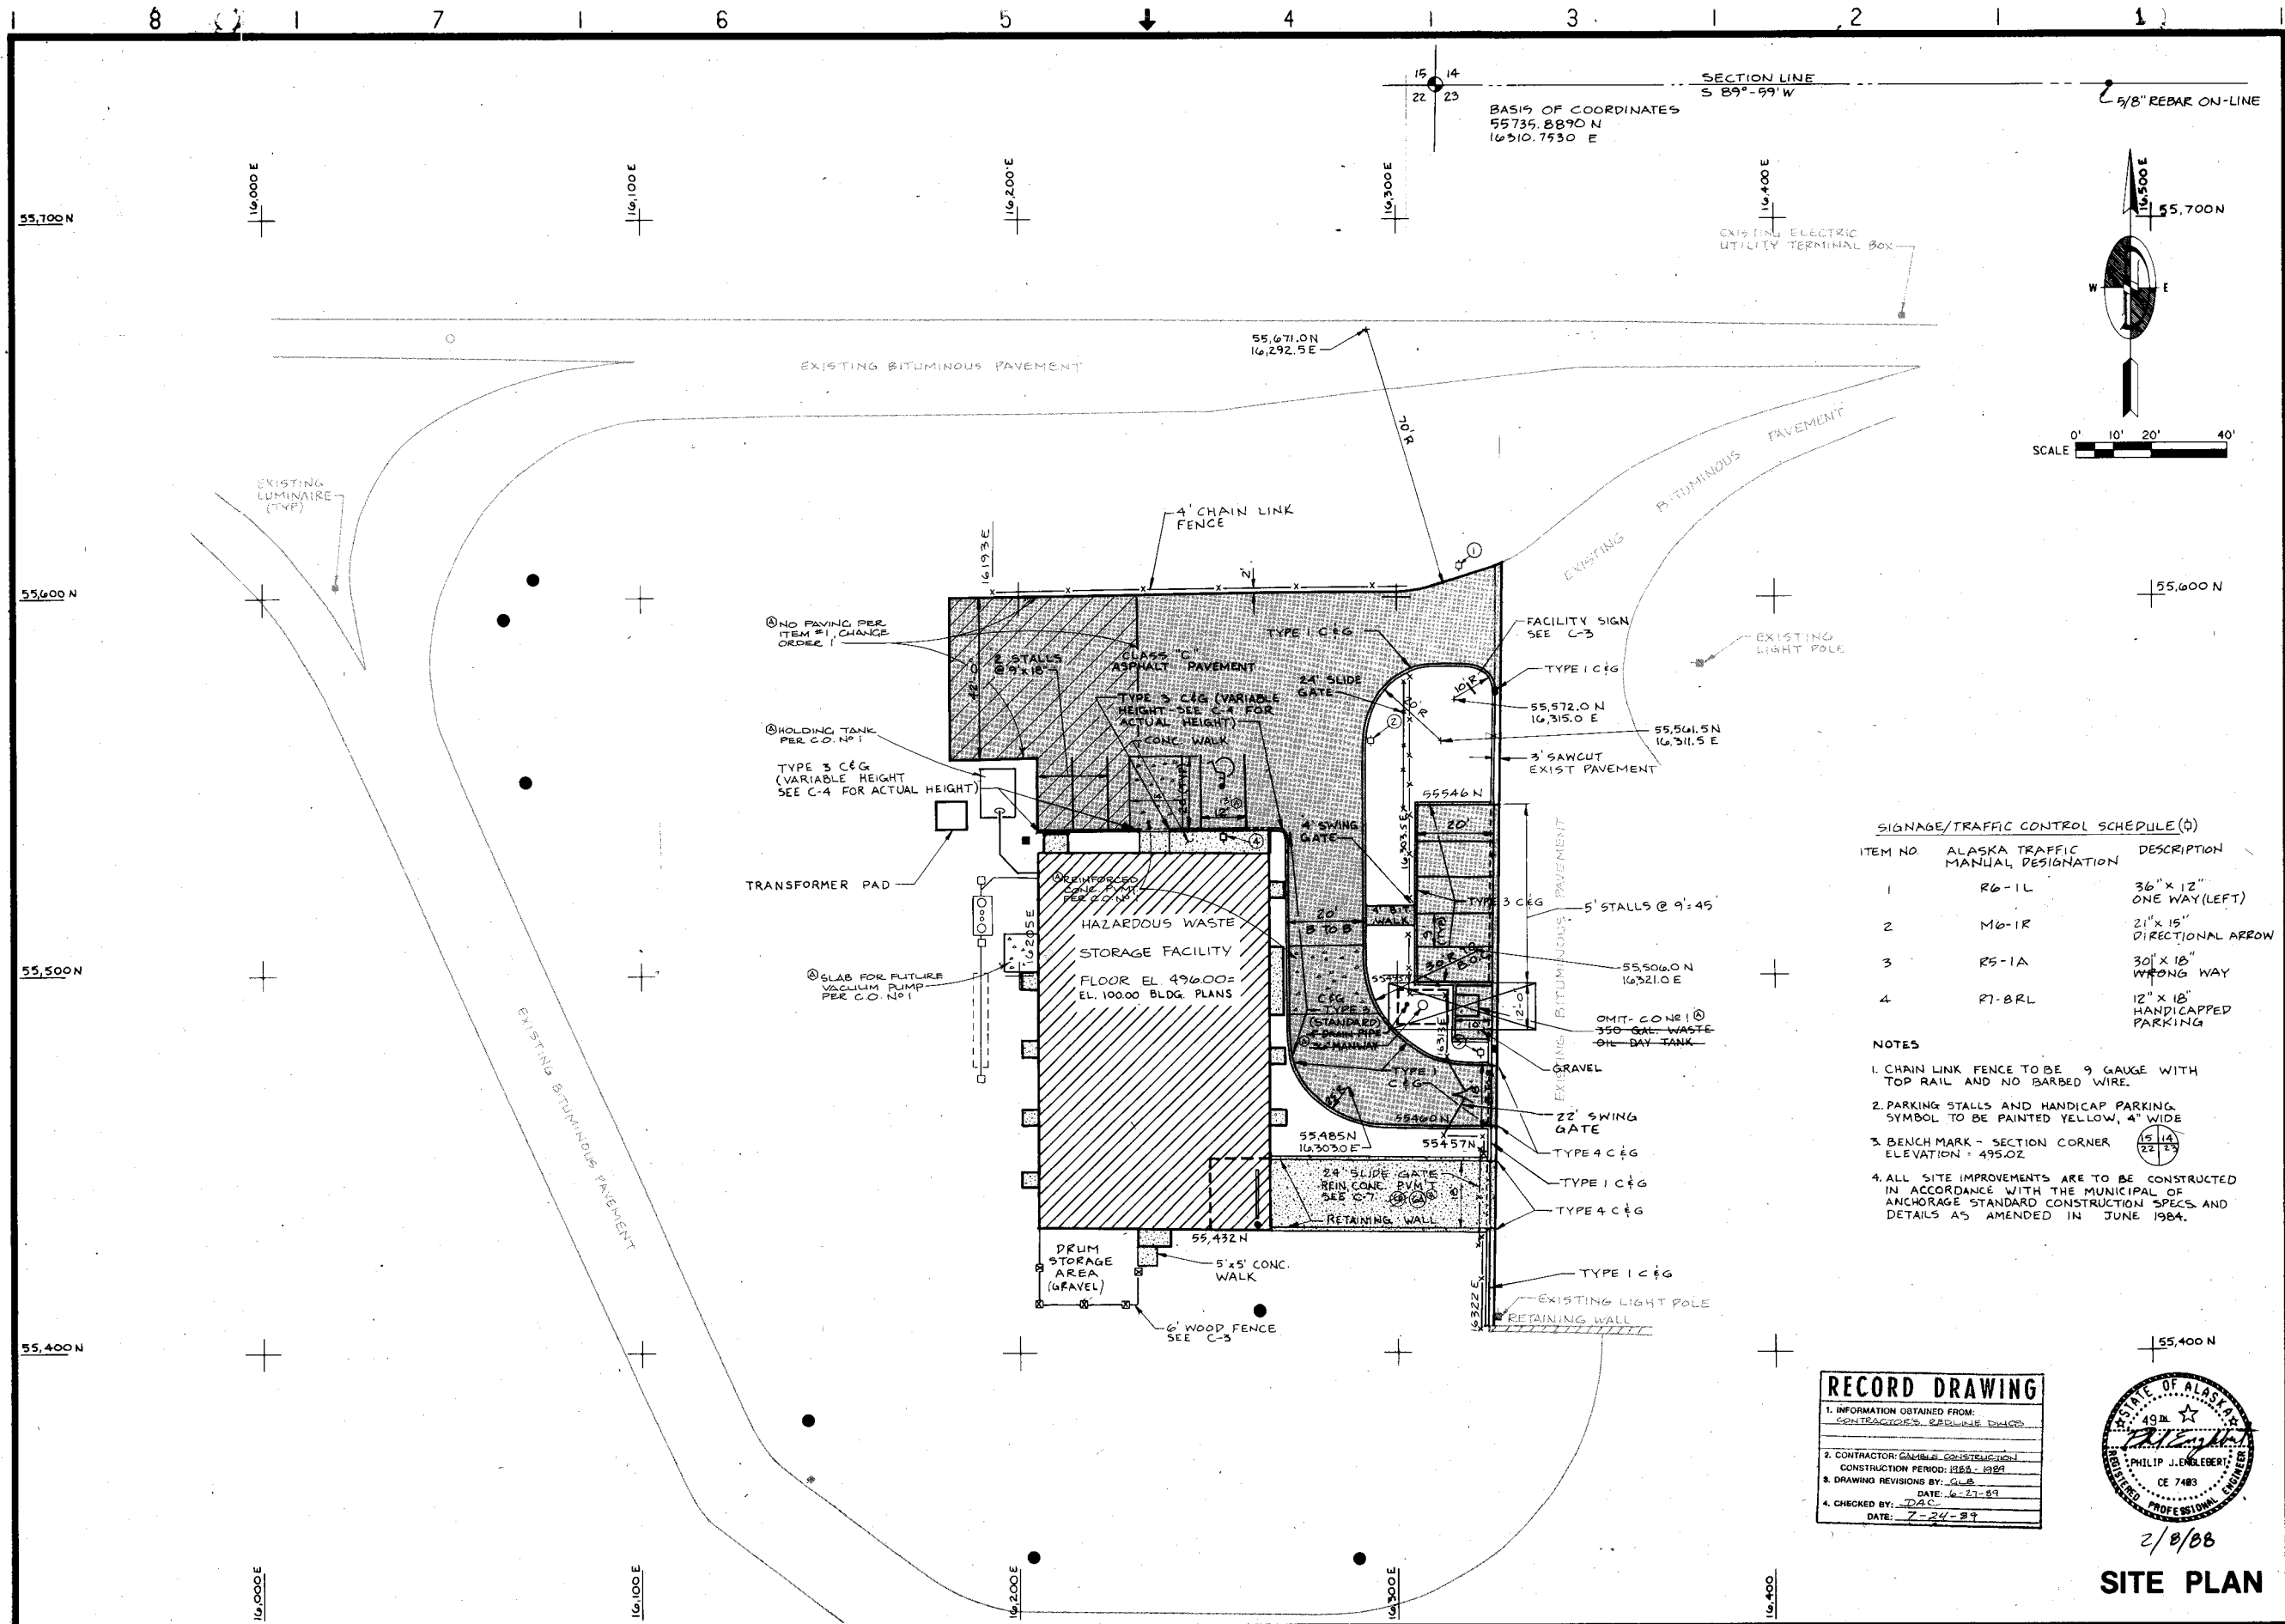

SIGNAGE/TRAFFIC CONTROL SCHEDULE (D)

ITEM NO.	ALASKA TRAFFIC MANUAL DESIGNATION	DESCRIPTION
1	R6-1L	36" x 12" ONE WAY (LEFT)
2	M6-1R	21" x 15" DIRECTIONAL ARROW
3	R5-1A	30" x 18" WRONG WAY
4	R7-BRL	12" x 18" HANDICAPPED PARKING

- NOTES**
- CHAIN LINK FENCE TO BE 9 GAUGE WITH TOP RAIL AND NO BARBED WIRE.
 - PARKING STALLS AND HANDICAP PARKING SYMBOL TO BE PAINTED YELLOW, 4" WIDE
 - BENCH MARK - SECTION CORNER ELEVATION = 495.02
 - ALL SITE IMPROVEMENTS ARE TO BE CONSTRUCTED IN ACCORDANCE WITH THE MUNICIPAL OF ANCHORAGE STANDARD CONSTRUCTION SPECS AND DETAILS AS AMENDED IN JUNE 1984.


RECORD DRAWING

1. INFORMATION OBTAINED FROM:
CONTRACTOR'S, SUPPLIER'S, OTHER

2. CONTRACTOR: GAMBLE CONSTRUCTION
CONSTRUCTION PERIOD: 1985-1989

3. DRAWING REVISIONS BY: GJB
DATE: 6-27-89

4. CHECKED BY: D.A.C.
DATE: 7-24-89

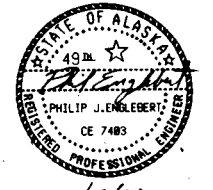

SITE PLAN

Donohue Engineers & Architects
COMPUTER AIDED DESIGN/DRAFTING
REGISTERED PROFESSIONAL ENGINEERS
ANCHORAGE, ALASKA


Scale	AS SHOWN	AS-BUILT PER CONTRACTOR'S REVISIONS	By	Date
Date	2-5-88			
Designer	SLP			
Drafter	JPW			
Checker	AWL			
Approver	TRJ			

CONTRACT DRAWINGS
HAZARDOUS WASTE STORAGE FACILITY
ANCHORAGE REGIONAL LANDFILL SITE
ANCHORAGE, ALASKA

Sheet No. 6
File No. A-50880
Project No.
Drawing No. **C-2**

REFERENCE FILES: RI-05 11 BORDER REF (1/8-11-88), R2, R3

W/PLOT SCALE: 1/8" = 1'-0" (FULL SIZE)
PLOT NAME: H
W/PLOT SCALE: 1/8" = 1'-0" (FULL SIZE)
PLOT NAME: H

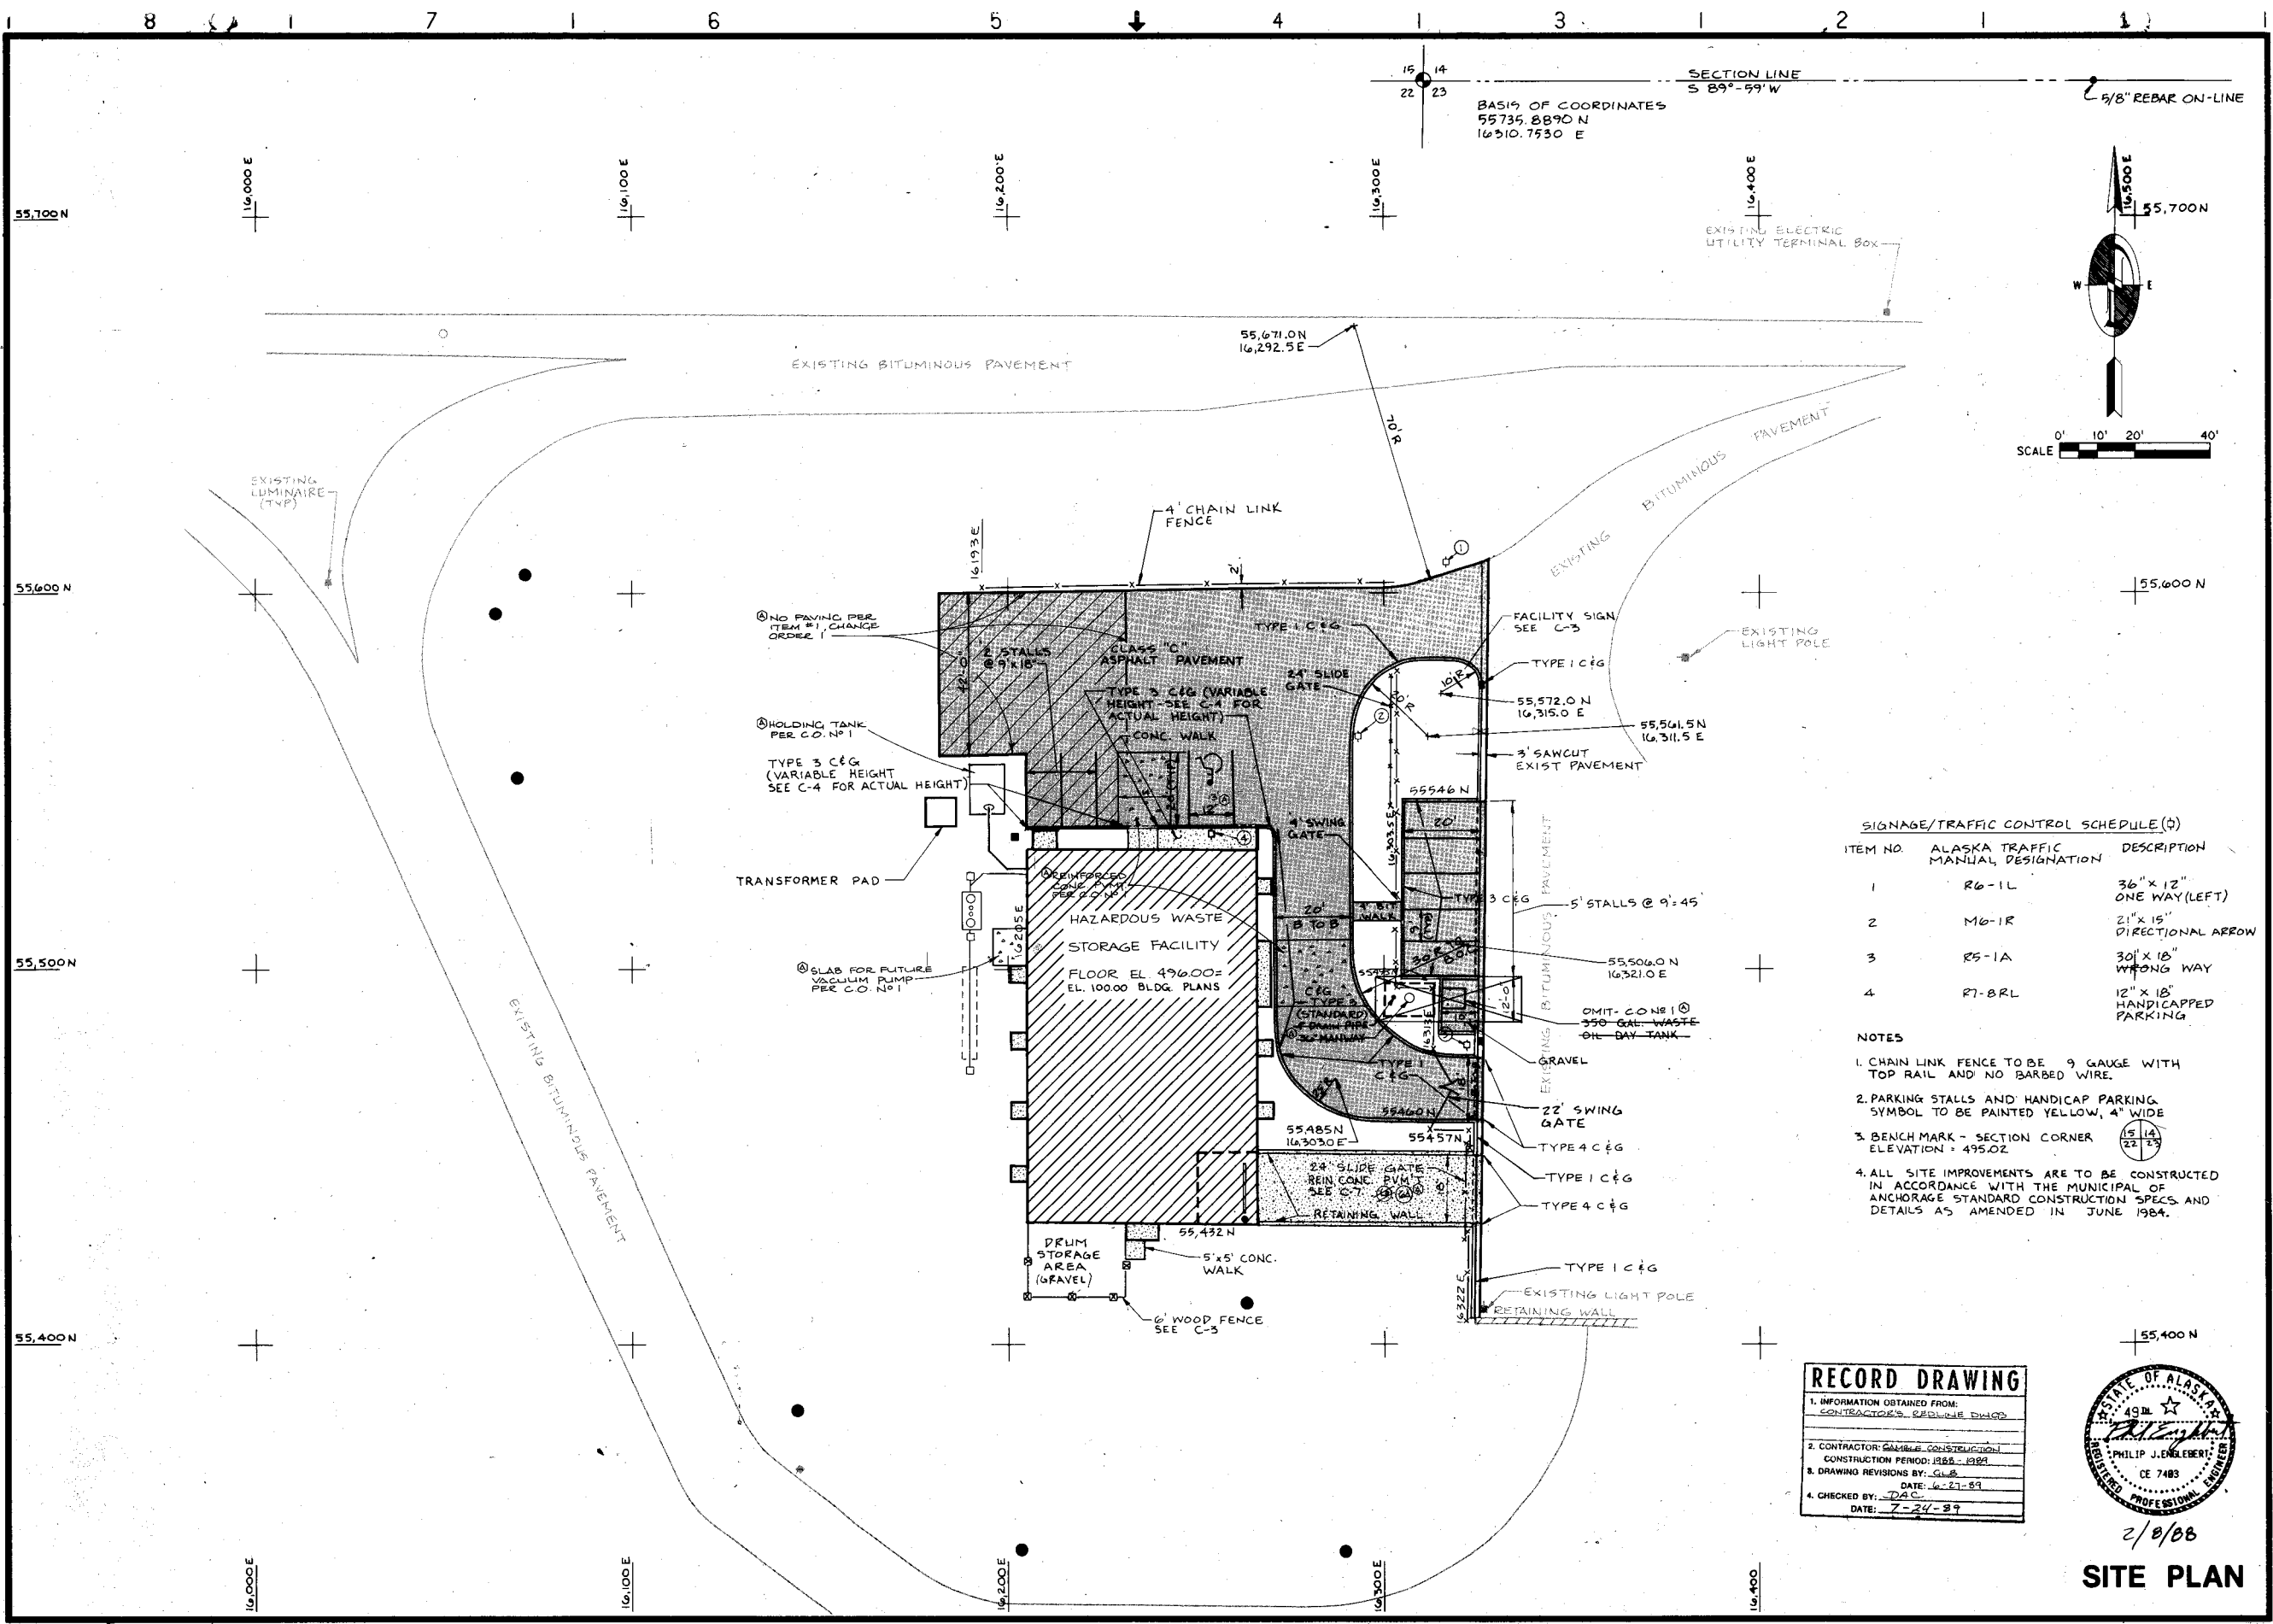

SIGNAGE/TRAFFIC CONTROL SCHEDULE (D)

ITEM NO.	ALASKA TRAFFIC MANUAL DESIGNATION	DESCRIPTION
1	R6-1L	36" x 12" ONE WAY (LEFT)
2	M6-1R	21" x 15" DIRECTIONAL ARROW
3	R5-1A	30" x 18" WRONG WAY
4	R7-8RL	12" x 18" HANDICAPPED PARKING

- NOTES**
- CHAIN LINK FENCE TO BE 9 GAUGE WITH TOP RAIL AND NO BARBED WIRE.
 - PARKING STALLS AND HANDICAP PARKING SYMBOL TO BE PAINTED YELLOW, 4" WIDE
 - BENCH MARK - SECTION CORNER ELEVATION = 495.02
 - ALL SITE IMPROVEMENTS ARE TO BE CONSTRUCTED IN ACCORDANCE WITH THE MUNICIPAL ANCHORAGE STANDARD CONSTRUCTION SPECS AND DETAILS AS AMENDED IN JUNE 1984.


RECORD DRAWING

1. INFORMATION OBTAINED FROM:
CONTRACTOR'S SPECULATIVE DRAWING

2. CONTRACTOR: GAMBRE CONSTRUCTION

3. CONSTRUCTION PERIOD: 1988 - 1989

4. CHECKED BY: DAC
DATE: 7-24-89

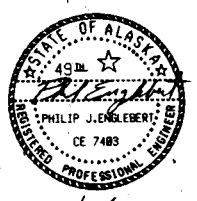

2/8/88
SITE PLAN

Donohue Engineers & Architects
Engineers & Architects
COMPUTER AIDED DESIGN/DRAFTING
DHW ENGINEERS


Scale	AS SHOWN
Date	2-5-88
Designer	SLP
Drafter	JPW
Checker	AWL
Approver	TRJ
No.	
Revisions	
By	
Date	

CONTRACT DRAWINGS
HAZARDOUS WASTE STORAGE FACILITY
ANCHORAGE REGIONAL LANDFILL SITE
ANCHORAGE, ALASKA

Sheet No. 6
File No. A-50880
Project No.
C-2
Drawing No.

DESIGN FILE 221-29

221-29

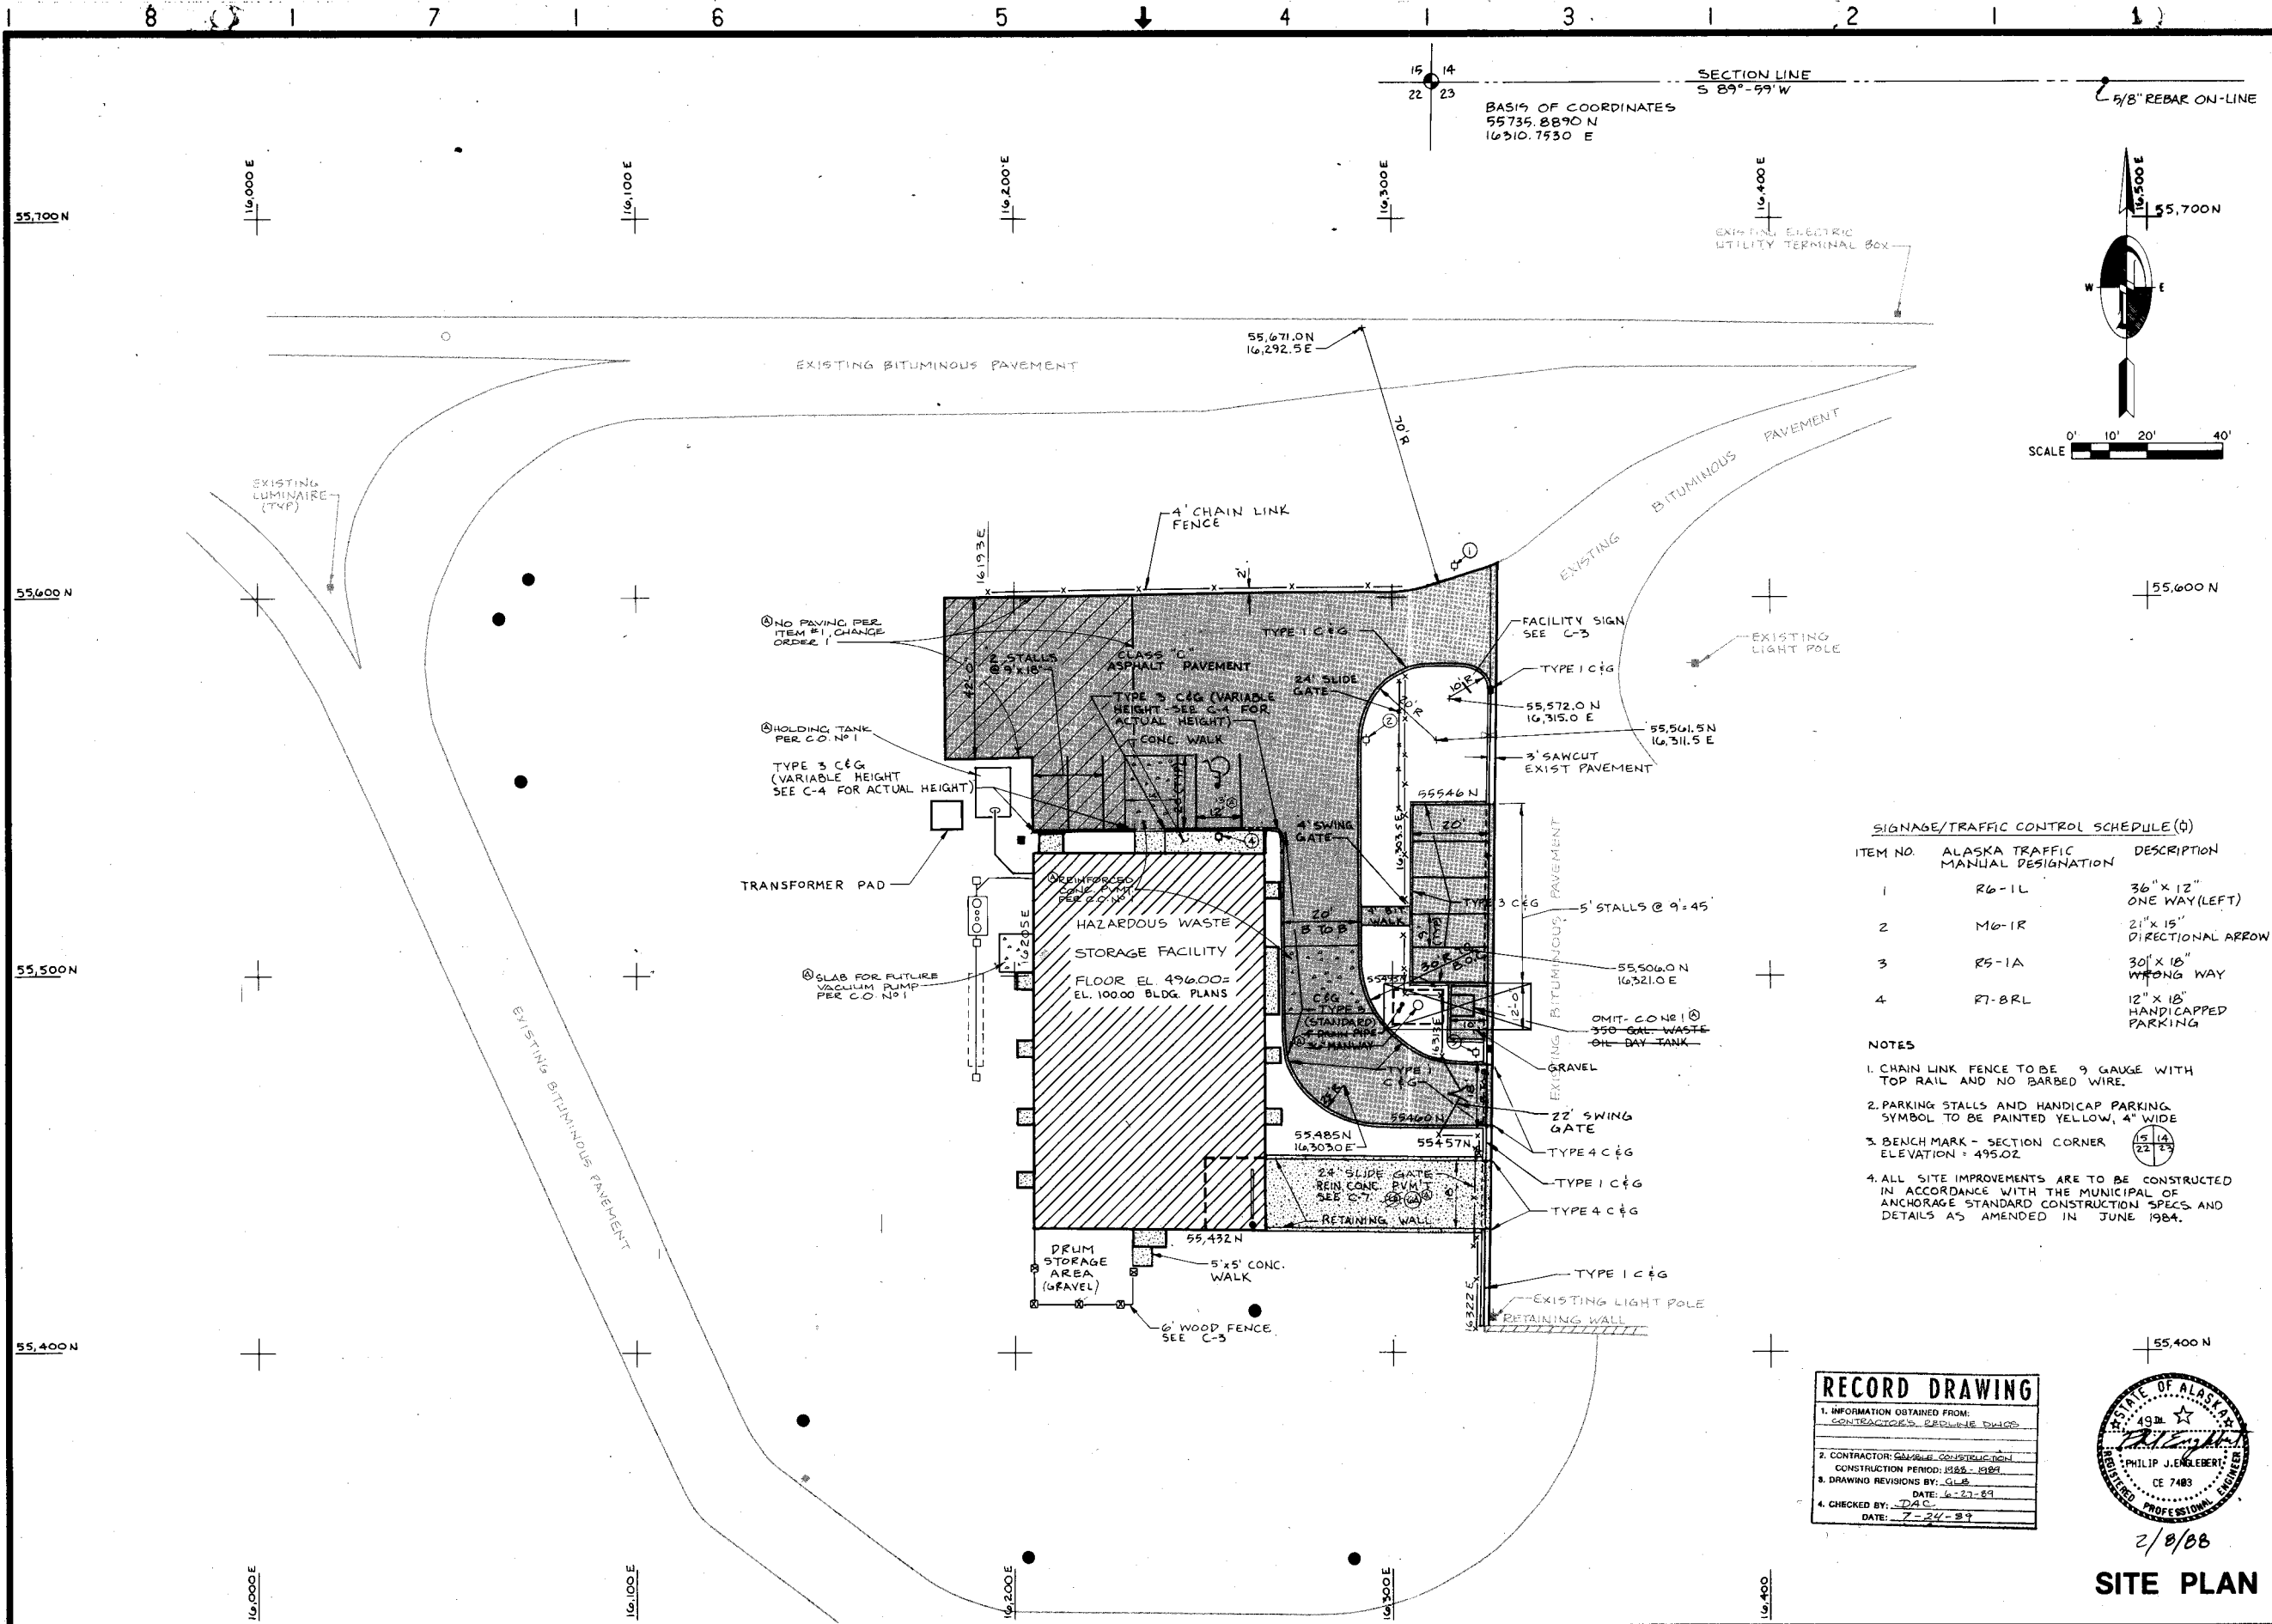

SIGNAGE/TRAFFIC CONTROL SCHEDULE (D)

ITEM NO.	ALASKA TRAFFIC MANUAL DESIGNATION	DESCRIPTION
1	R6-1L	36" x 12" ONE WAY (LEFT)
2	M6-1R	21" x 15" DIRECTIONAL ARROW
3	R5-1A	30" x 18" WRONG WAY
4	R7-BRL	12" x 18" HANDICAPPED PARKING

NOTES

- CHAIN LINK FENCE TO BE 9 GAUGE WITH TOP RAIL AND NO BARBED WIRE.
- PARKING STALLS AND HANDICAP PARKING SYMBOL TO BE PAINTED YELLOW, 4" WIDE
- BENCHMARK - SECTION CORNER ELEVATION = 495.02
- ALL SITE IMPROVEMENTS ARE TO BE CONSTRUCTED IN ACCORDANCE WITH THE MUNICIPAL OF ANCHORAGE STANDARD CONSTRUCTION SPECS. AND DETAILS AS AMENDED IN JUNE 1984.

RECORD DRAWING

1. INFORMATION OBTAINED FROM:
CONTRACTOR'S PRELIMINE DWG'S

2. CONTRACTOR: GAMALE CONSTRUCTION
CONSTRUCTION PERIOD: 1988-1989
DATE: 6-27-89

3. DRAWING REVISIONS BY: GLB
DATE: 6-27-89

4. CHECKED BY: DAC
DATE: 7-24-89



2/8/88
SITE PLAN

AS SHOWN	Scale	Date	Designer	Drafter	Checker	Approver	No.	Revisions	By	Date
2-5-88			SLP	JPW	AWL	TRJ				

Donohue
Engineers & Architects
COMPUTER AIDED DESIGN/DRAFTING
REGISTERED PROFESSIONAL ENGINEERS
ANCHORAGE, ALASKA


CONTRACT DRAWINGS
HAZARDOUS WASTE STORAGE FACILITY
ANCHORAGE REGIONAL LANDFILL SITE
ANCHORAGE, ALASKA

Sheet No.	6
File No.	A-50880
Project No.	
Drawing No.	C-2

REFERENCE FILES
R1-JOS-11
R2-
R3-
BORDER REF (LV-11-20)

W-
PLOT SCALE-
PLOT INCHES
(FULL SIZE)
H
PLOT SCALE-
PLOT INCHES
(FULL SIZE)

221-26

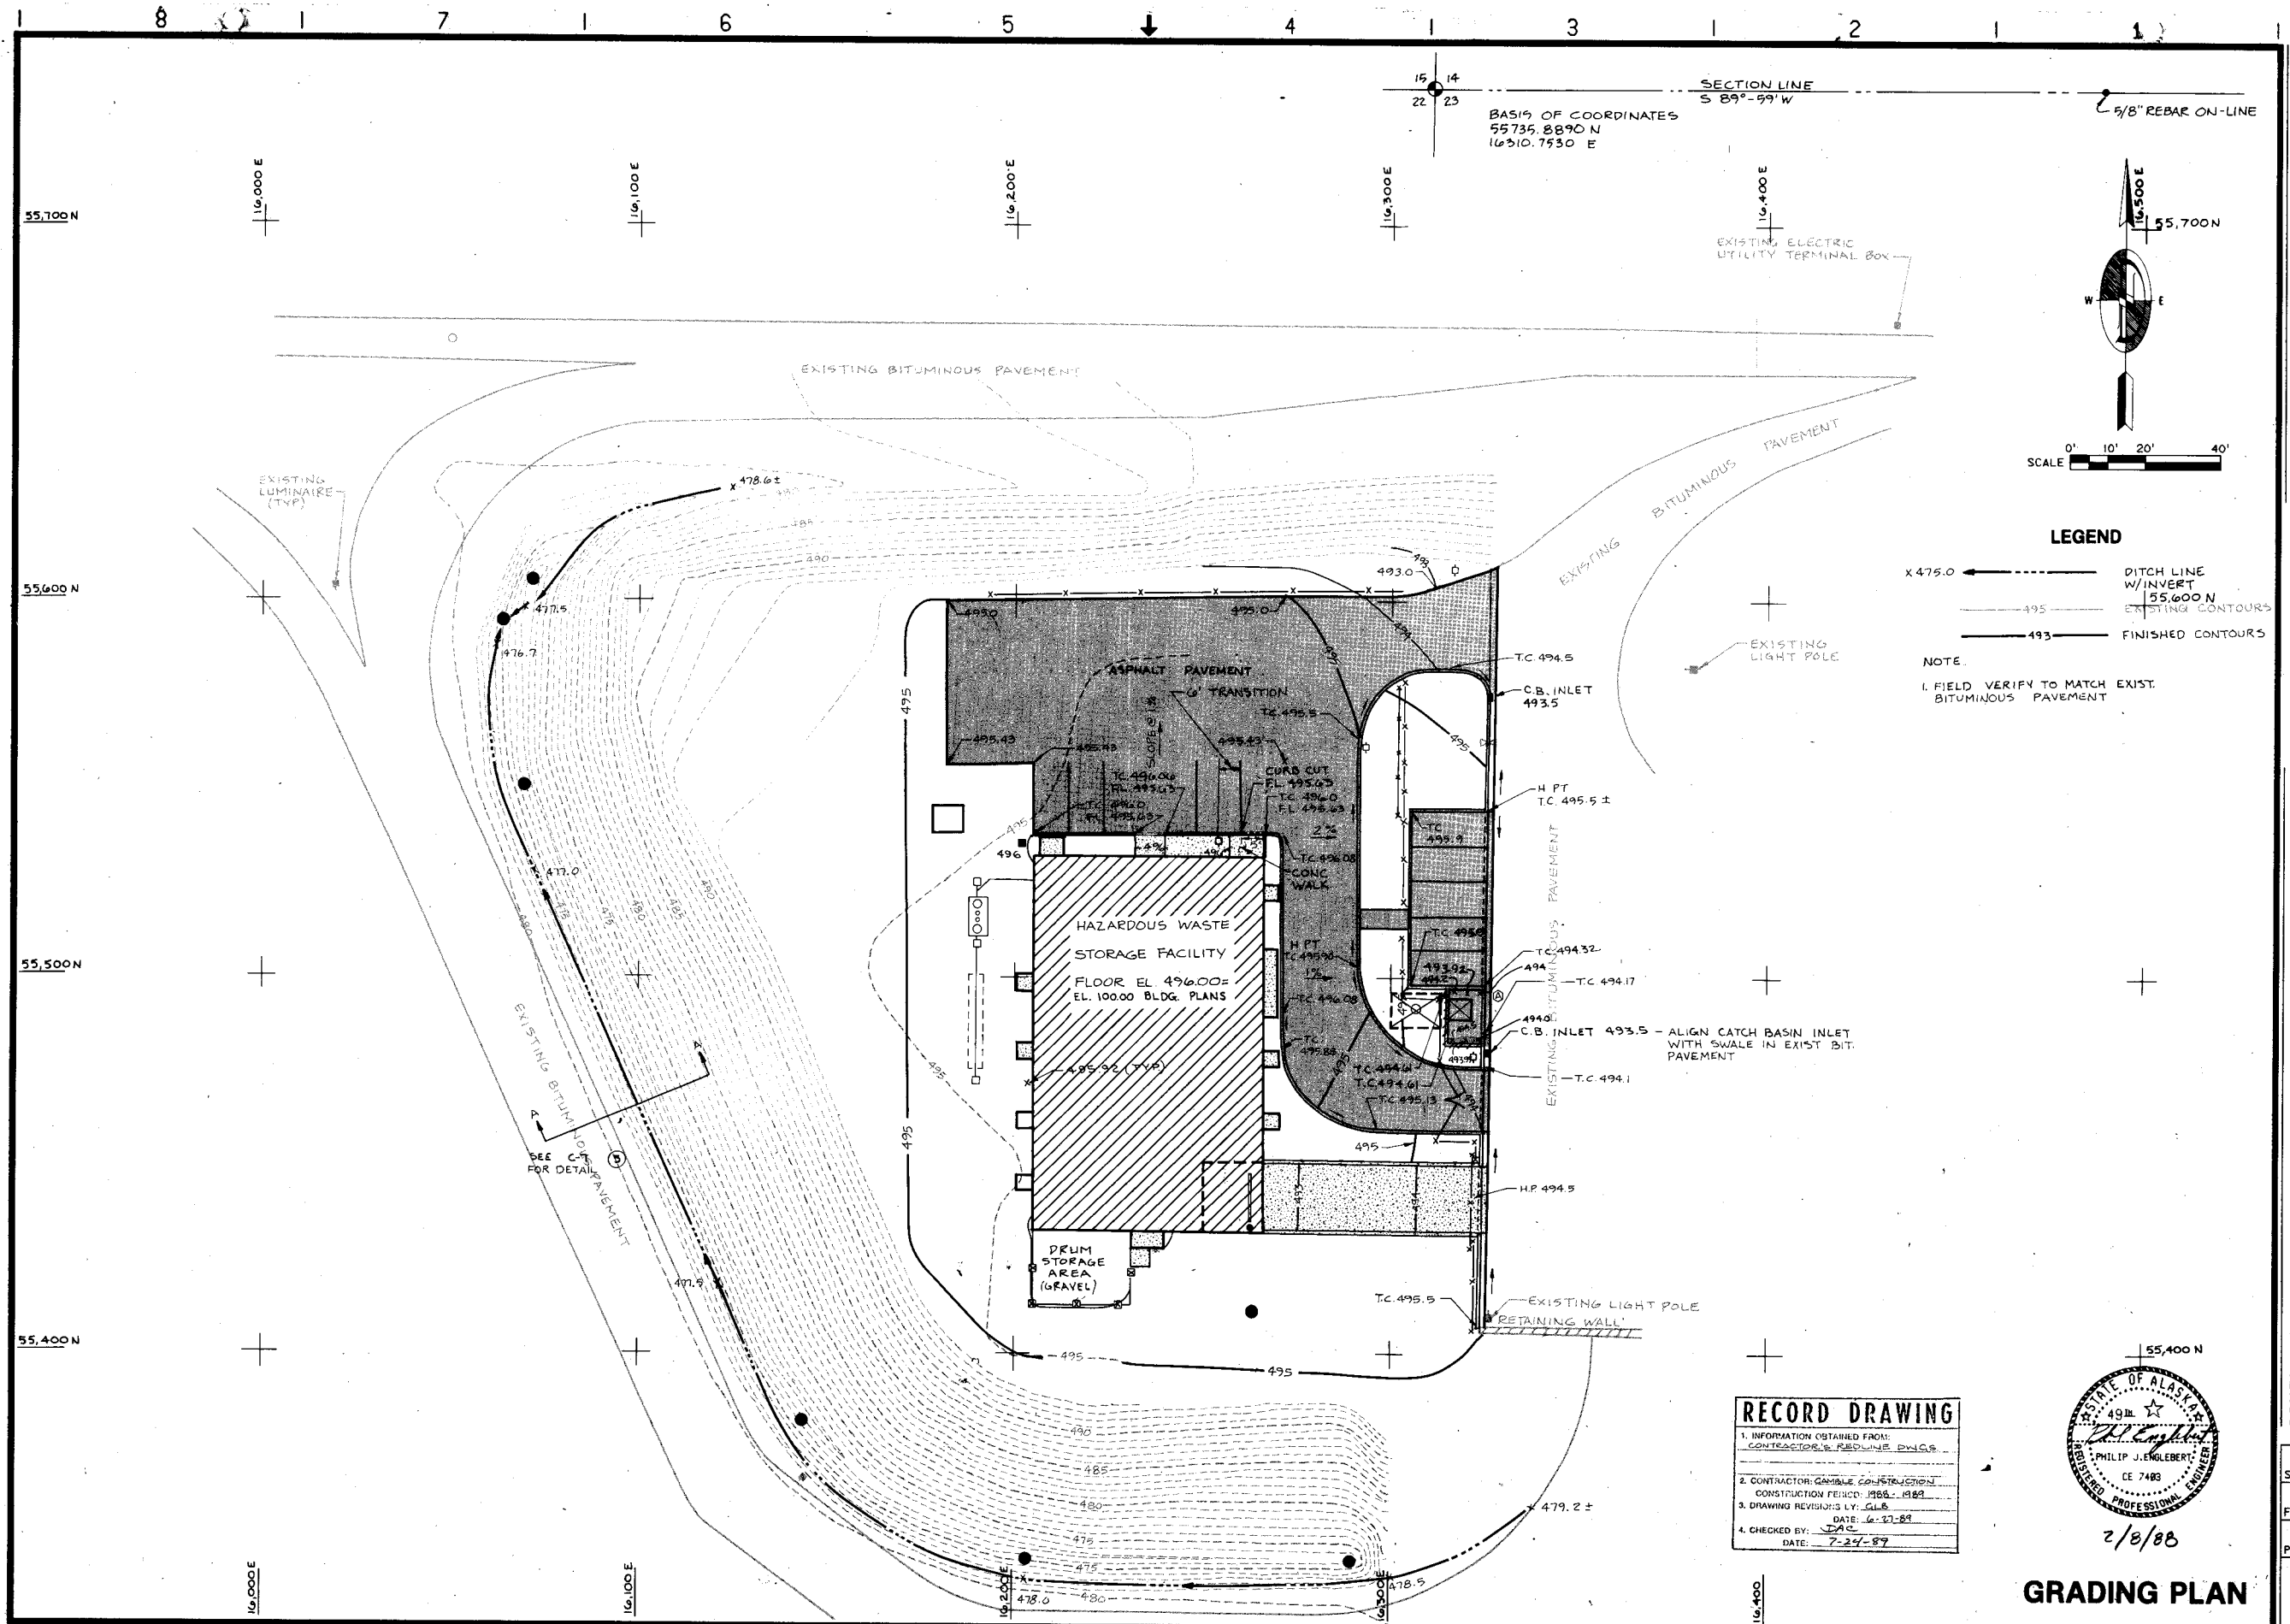

REFERENCE FILES
 R1:05 T1
 R2: R2
 R3: R3

10
 W1: PLOT SCALE -
 PLOT NAME -
 (FULL SIZE)

3
 2
 1
 W1: PLOT SCALE -
 PLOT NAME -
 (FULL SIZE)


RECORD DRAWING

1. INFORMATION OBTAINED FROM:
 CONTRACTOR'S REDLINE DWGS.

2. CONTRACTOR (GAMMA CONSTRUCTION)
 CONSTRUCTION PERIOD: 1988 - 1989

3. DRAWING REVISIONS BY: GLE
 DATE: 6-27-89

4. CHECKED BY: PAC
 DATE: 7-27-89

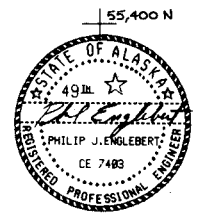

GRADING PLAN

AS SHOWN	Scale
2-5-88 <td></td>	
Date	
SLP <td>Designer</td>	Designer
JPW <td>Drafter</td>	Drafter
AWL <td>Checker</td>	Checker
TRJ <td>Approver</td>	Approver
No.	Revisions
By	Date


Donohue
 Engineers & Architects
 COMPUTER AIDED DESIGN/DRAFTING
 ENGINEERS

CONTRACT DRAWINGS
HAZARDOUS WASTE STORAGE FACILITY
ANCHORAGE REGIONAL LANDFILL SITE
ANCHORAGE, ALASKA

Sheet No. 8
File No. A-50878
Project No.
C-4
Drawing No.

221-25

ALSO FILED AS 219-68

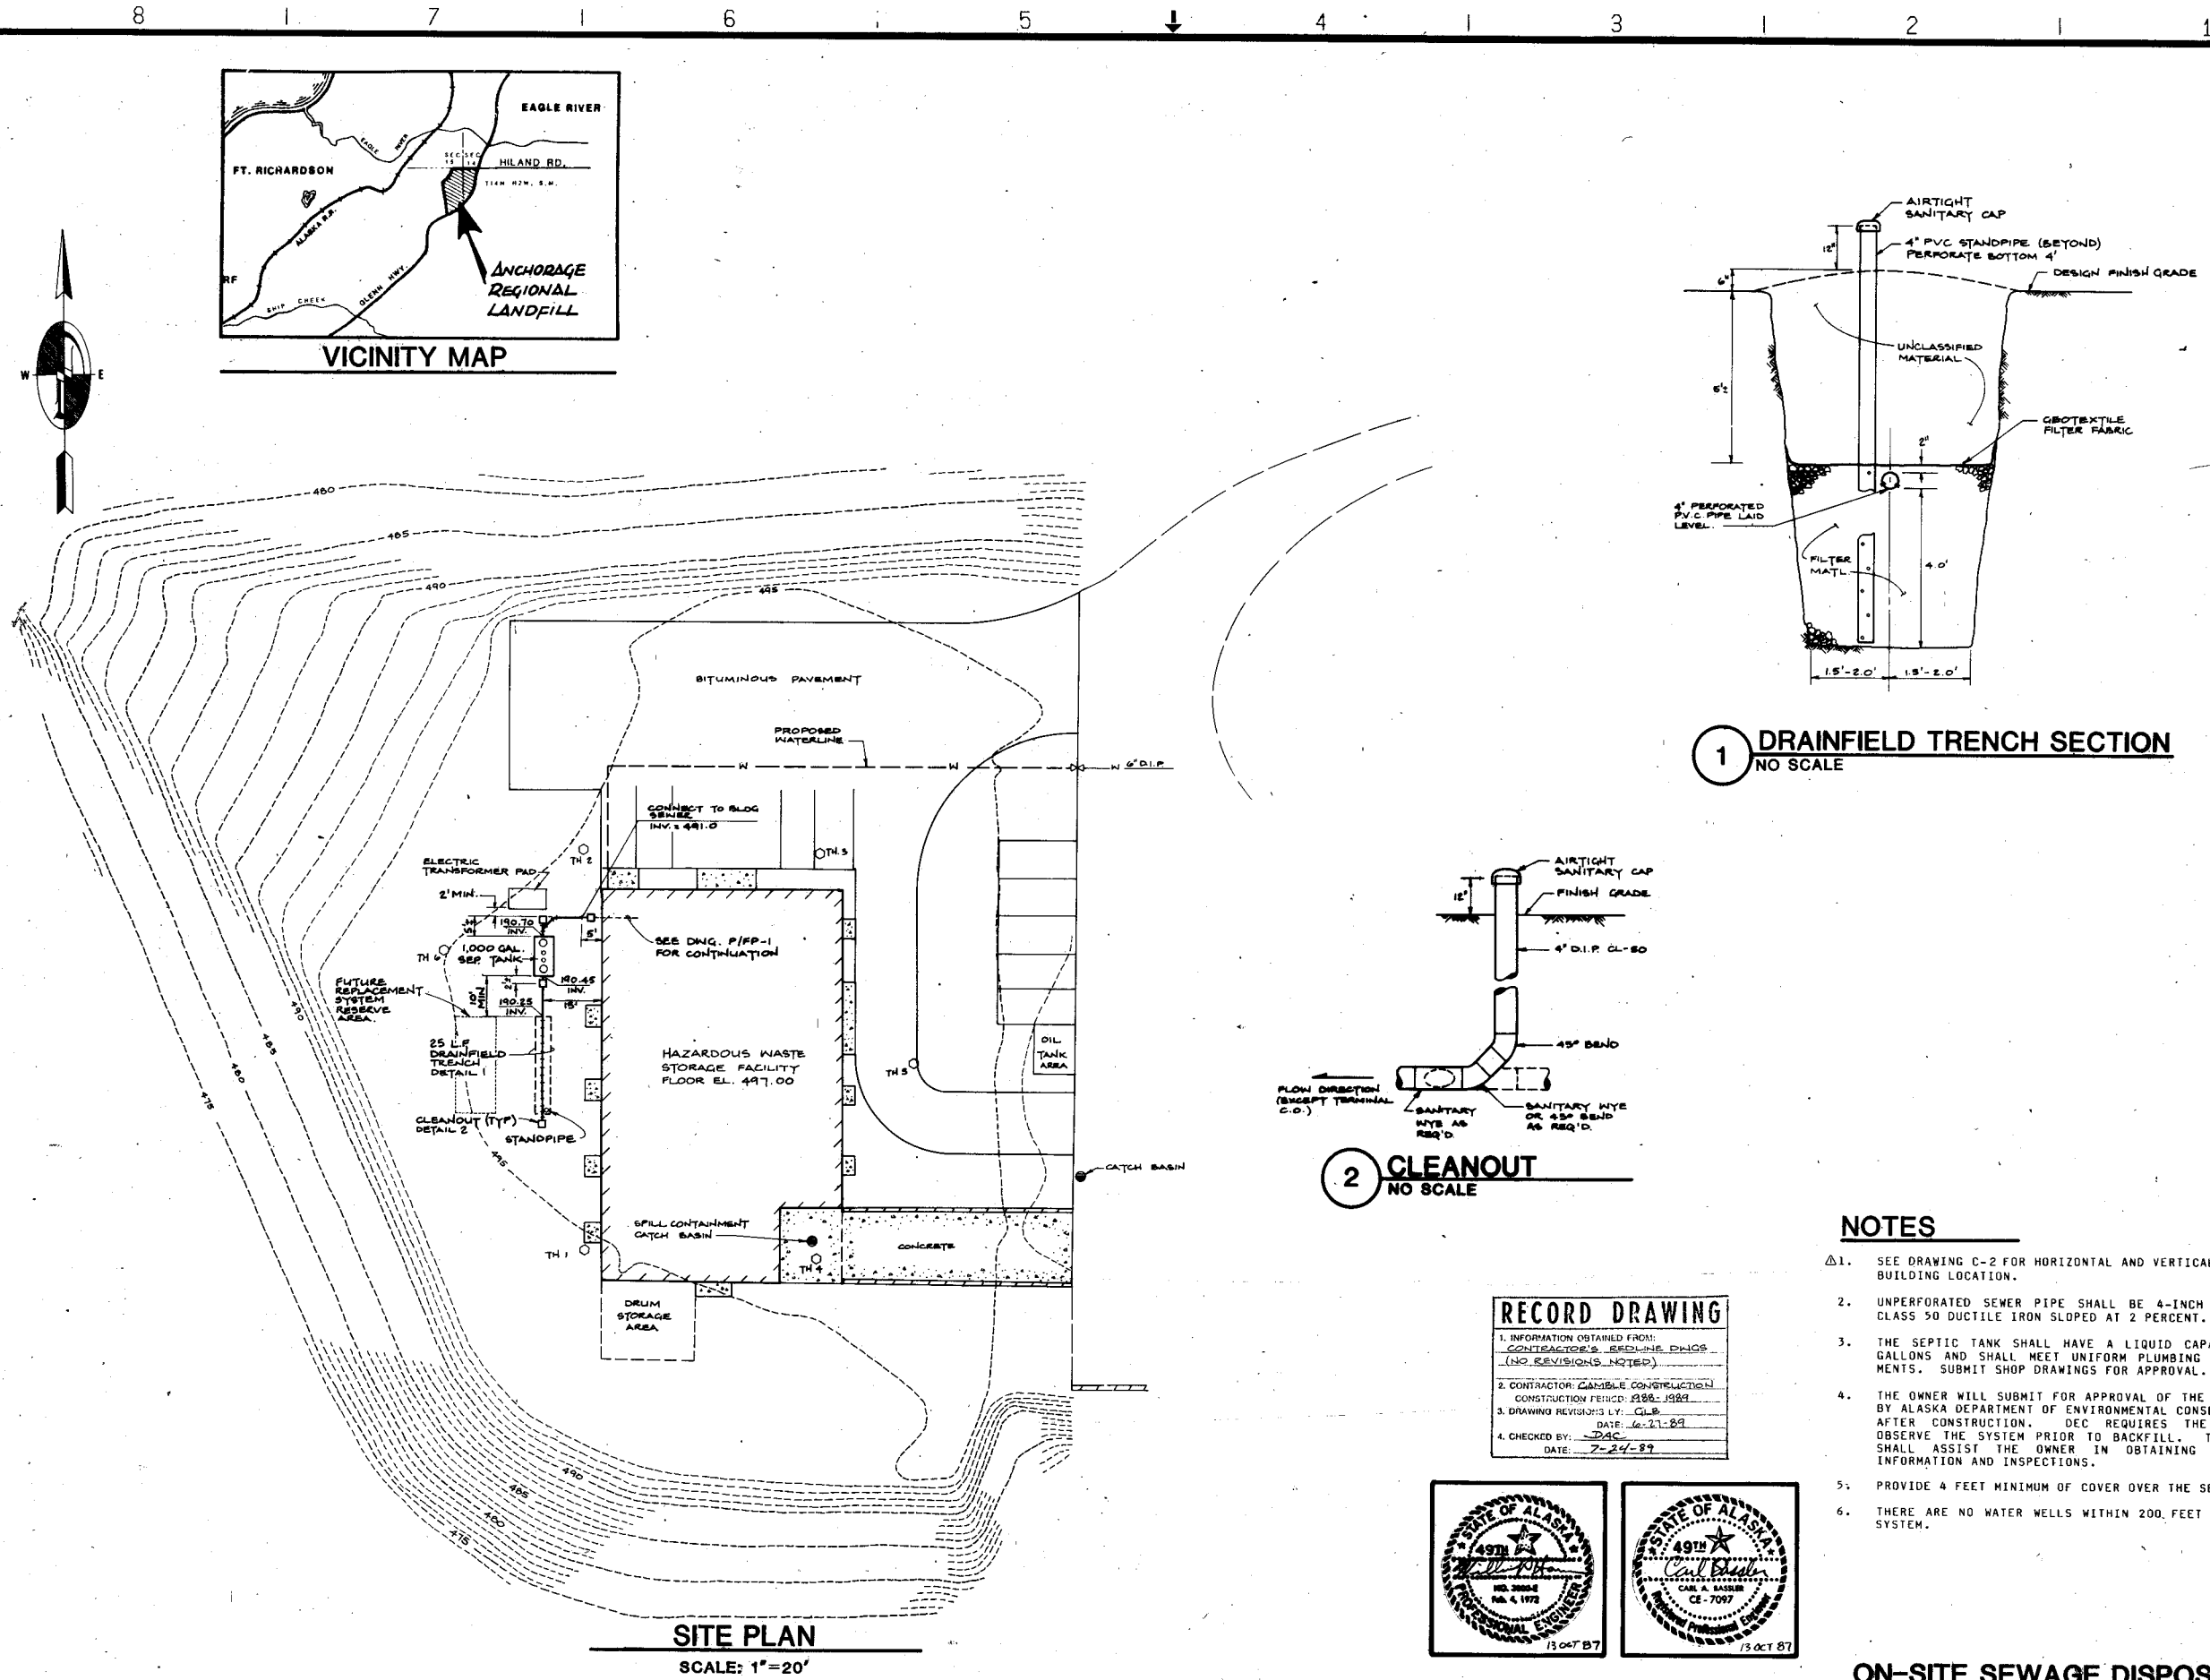


PLANS 11
REFERENCE FILES
322
83

DATE: 11-11-20
PROJECT: 221-25
SCALE: FULL SIZE

DATE: 11-11-20
PROJECT: 221-25
SCALE: FULL SIZE

RECORD DRAWING

1. INFORMATION OBTAINED FROM:
CONTRACTOR'S RECORDING PHOTOS
(NO REVISIONS NOTED)
2. CONTRACTOR: CAMBLE CONSTRUCTION
CONSTRUCTION PERIOD: 1988-1989
3. DRAWING REVISIONS BY: C.L.B.
DATE: 6-27-89
4. CHECKED BY: DAC
DATE: 7-24-89

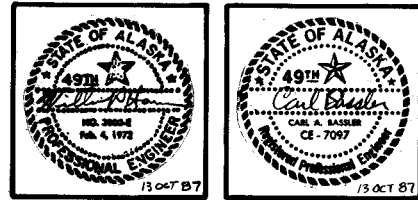

NOTES

1. SEE DRAWING C-2 FOR HORIZONTAL AND VERTICAL CONTROL, AND BUILDING LOCATION.
2. UNPERFORATED SEWER PIPE SHALL BE 4-INCH CAST IRON OR CLASS 50 DUCTILE IRON SLOPED AT 2 PERCENT.
3. THE SEPTIC TANK SHALL HAVE A LIQUID CAPACITY OF 1000 GALLONS AND SHALL MEET UNIFORM PLUMBING CODE REQUIREMENTS. SUBMIT SHOP DRAWINGS FOR APPROVAL.
4. THE OWNER WILL SUBMIT FOR APPROVAL OF THE SEPTIC SYSTEM BY ALASKA DEPARTMENT OF ENVIRONMENTAL CONSERVATION (DEC) AFTER CONSTRUCTION. DEC REQUIRES THE ENGINEER TO OBSERVE THE SYSTEM PRIOR TO BACKFILL. THE CONTRACTOR SHALL ASSIST THE OWNER IN OBTAINING THE REQUIRED INFORMATION AND INSPECTIONS.
5. PROVIDE 4 FEET MINIMUM OF COVER OVER THE SEPTIC TANK.
6. THERE ARE NO WATER WELLS WITHIN 200 FEET OF THE SEPTIC SYSTEM.

ON-SITE SEWAGE DISPOSAL PLAN

Donohue Engineers & Architects
COMPUTER AIDED DESIGN/DRAFTING
ENGINEERS


Scale _____
Date _____
Designer _____
Drafting _____
Checker _____
Approver _____

NO AS-BUILT REVISIONS
NOTE 1
Revisions No. _____
By _____
Date _____


CONTRACT DRAWINGS
HAZARDOUS WASTE STORAGE FACILITY
ANCHORAGE REGIONAL LANDFILL SITE
ANCHORAGE, ALASKA

Sheet No. 1
File No. _____
Project No. _____
C-5
Drawing No. _____


221-23

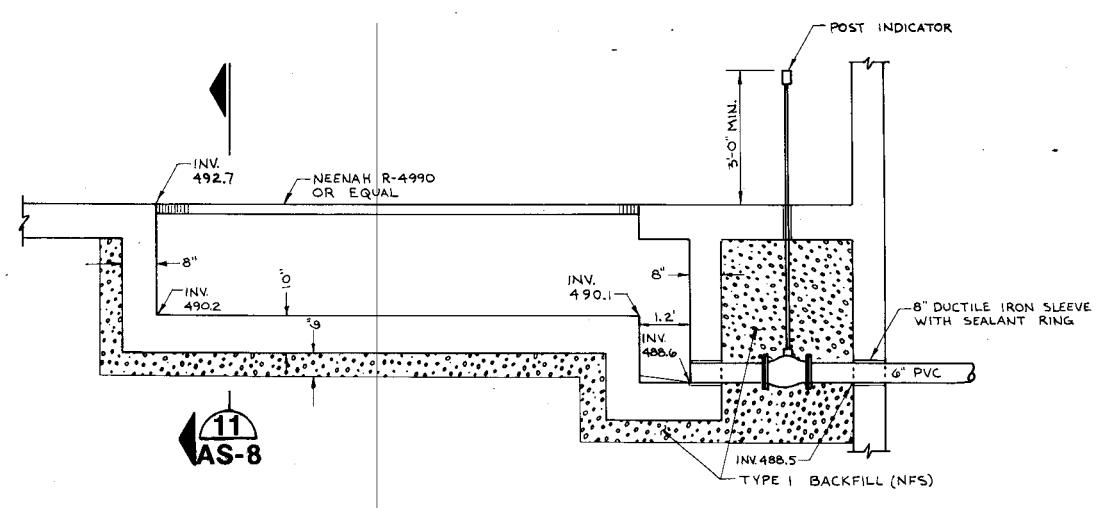


1 SPILL CONTAINMENT AND RETAINING WALL DETAIL

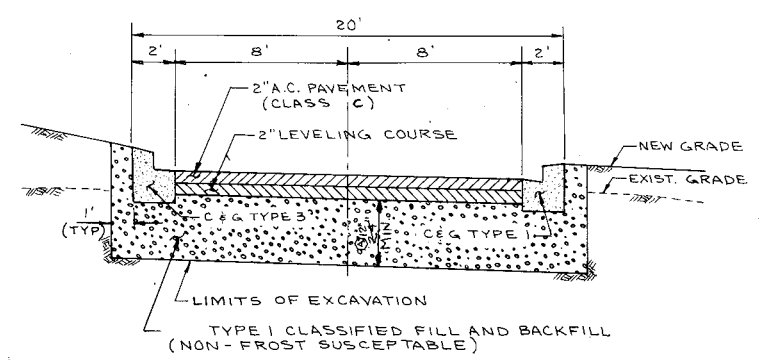


2 BITUMINOUS PAVEMENT SECTION EAST OF BUILDING

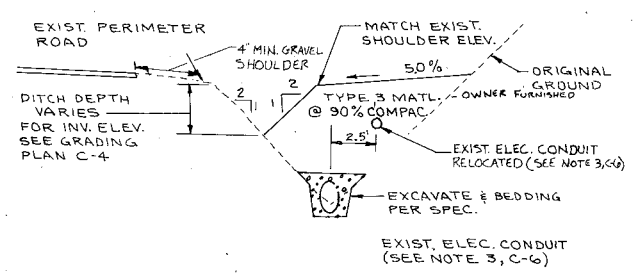


3 PERIMETER STORM DRAIN SECTION "A - A"

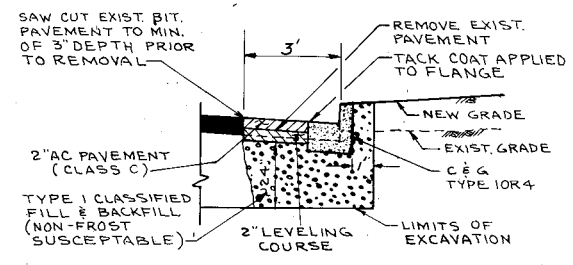

4 BUTT JOINT DETAIL

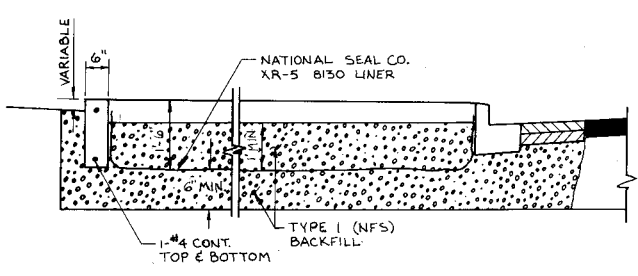

5 OIL TANK AREA SECTION "B-B"

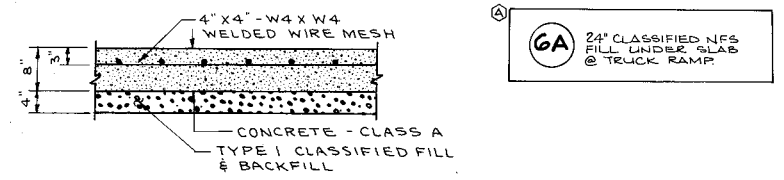

6 REINFORCED CONCRETE PAVEMENT SECTION

RECORD DRAWING	
1. INFORMATION OBTAINED FROM:	CONTRACTOR'S RESUBMITTALS
2. CONTRACTOR:	GAMBLE CONSTRUCTION
3. DRAWING REVISIONS BY:	CLB
4. CHECKED BY:	DAC
DATE:	7-24-89



2/8/88

SITE DETAILS

Scale	AS SHOWN
Date	12-24-87
Designer	SLP
Drafter	JPW
Checker	AWL
Approver	TRJ
Revisions	No.
By	Date

Donohue
 Engineers & Architects
 COMPUTER AIDED DESIGN/DRAFTING
 BOWEN ENGINEERS



CONTRACT DRAWINGS
HAZARDOUS WASTE STORAGE FACILITY
ANCHORAGE REGIONAL LANDFILL SITE
 ANCHORAGE, ALASKA

Sheet No.	9B
File No.	A-50876
Project No.	
Drawing No.	C-7

REFERENCE FILES
 R1=OS 11
 R2=
 R3=
 BURGER, REF (LV=11-20)

W/PLOT SCALE-
 PLOT SCALE-
 PLOT SCALE-
 (FULL SIZE)
 (FULL SIZE)
 (FULL SIZE)

221-24

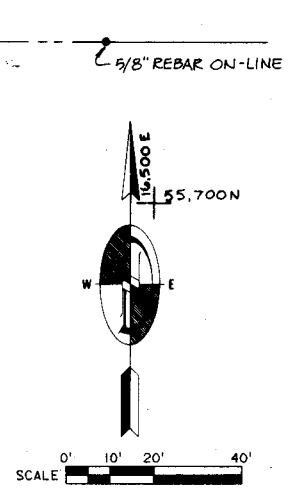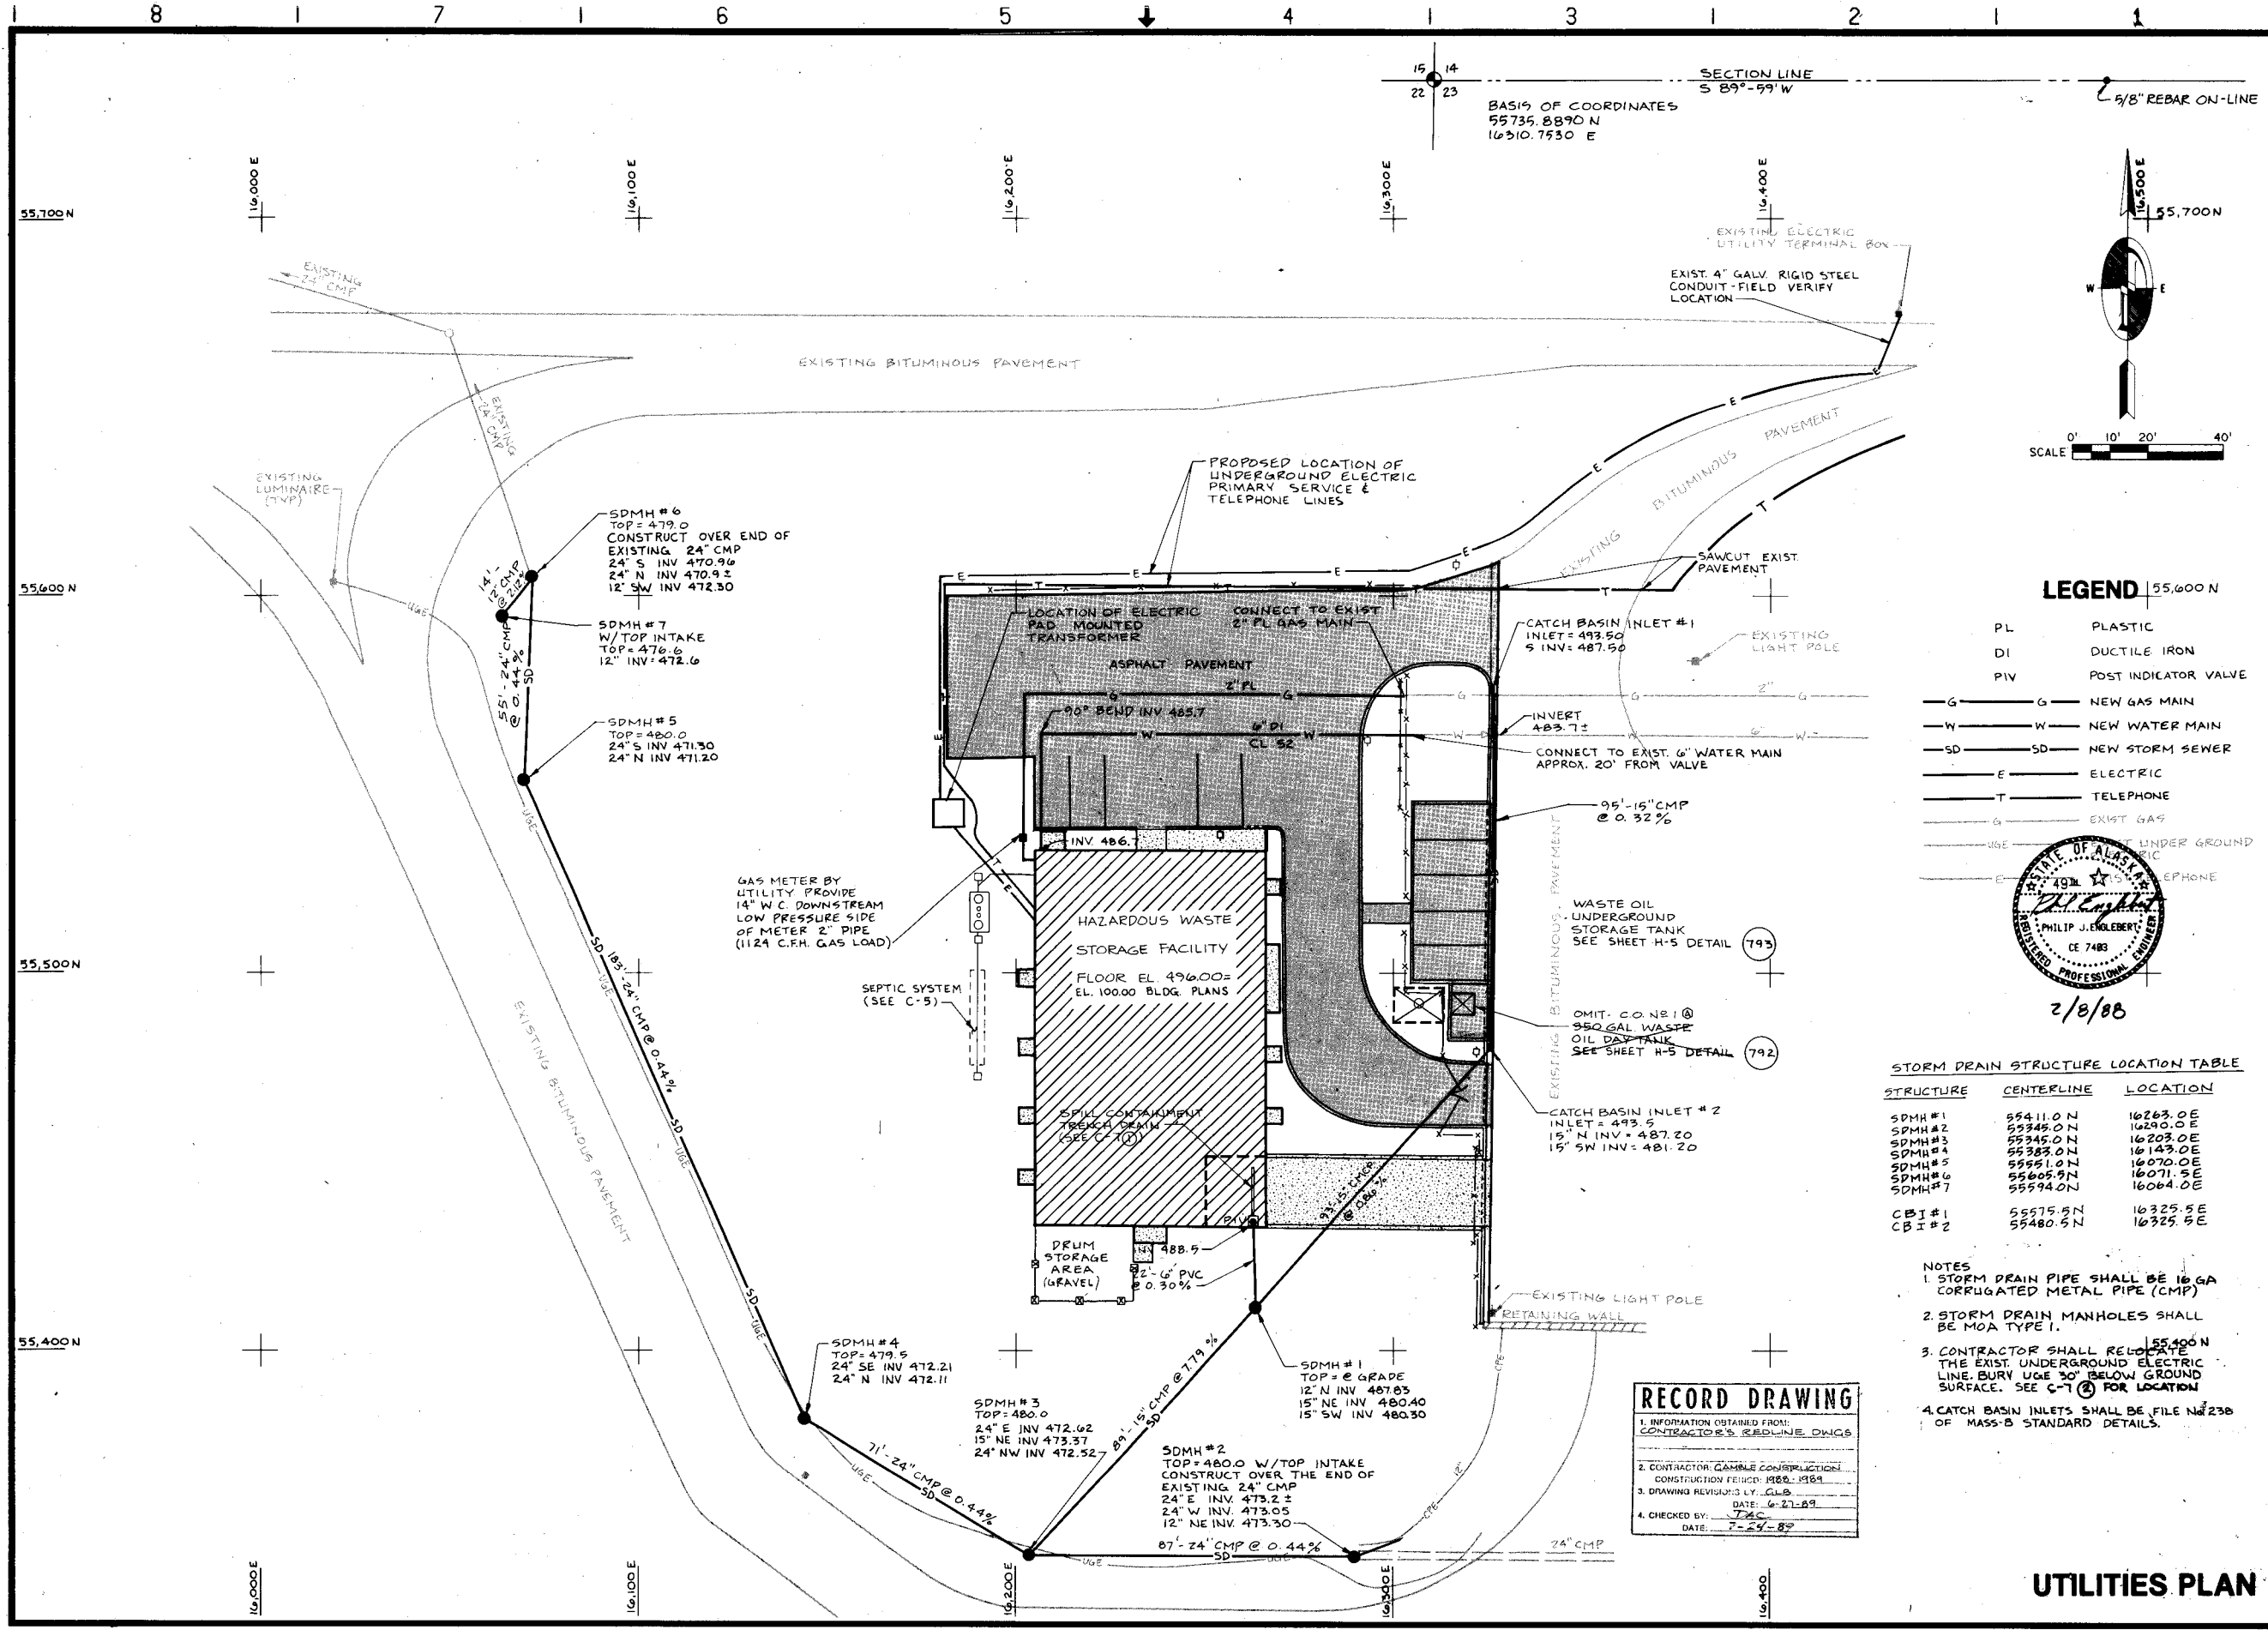

LEGEND

- PL PLASTIC
- DI DUCTILE IRON
- PIV POST INDICATOR VALVE
- G- NEW GAS MAIN
- W- NEW WATER MAIN
- SD- NEW STORM SEWER
- E- ELECTRIC
- T- TELEPHONE
- G- EXIST. GAS
- UG- UNDER GROUND
- E- TELEPHONE



STORM DRAIN STRUCTURE LOCATION TABLE

STRUCTURE	CENTERLINE	LOCATION
SDMH #1	55411.0 N	16263.0 E
SDMH #2	55349.0 N	16290.0 E
SDMH #3	55345.0 N	16203.0 E
SDMH #4	55383.0 N	16143.0 E
SDMH #5	55551.0 N	16070.0 E
SDMH #6	55605.9 N	16071.5 E
SDMH #7	55594.0 N	16064.0 E
CBI #1	55575.5 N	16325.5 E
CBI #2	55480.5 N	16325.5 E

- NOTES**
- STORM DRAIN PIPE SHALL BE 16 GA CORRUGATED METAL PIPE (CMP)
 - STORM DRAIN MANHOLES SHALL BE MOA TYPE I.
 - CONTRACTOR SHALL RELOCATE THE EXIST. UNDERGROUND ELECTRIC LINE BURY UGE 30" BELOW GROUND SURFACE. SEE C-7 FOR LOCATION
 - CATCH BASIN INLETS SHALL BE FILE NO 238 OF MASS-B STANDARD DETAILS.

RECORD DRAWING

1. INFORMATION OBTAINED FROM: CONTRACTOR'S FIELD NOTES

2. CONTRACTOR: CABLE CONSTRUCTION CONSTRUCTION PERIOD: 1980-1984

3. DRAWING REVISIONS BY: CLB DATE: 6-27-89

4. CHECKED BY: TAC DATE: 7-24-89

AS SHOWN	DATE	DESIGNER	DRAWN	CHECKER	APPROVER	NO.	REVISIONS	BY	DATE
2-5-88	SLP	JPW	AWL	TRJ					


Donohue Engineers & Architects
 COMPUTER AIDED DESIGN/DRAFTING
 1000 W. 11TH AVENUE
 ANCHORAGE, ALASKA 99501
 PHONE: 261-1111
 FAX: 261-1112

CONTRACT DRAWINGS
HAZARDOUS WASTE STORAGE FACILITY
ANCHORAGE REGIONAL LANDFILL SITE
 ANCHORAGE, ALASKA

Sheet No.	
File No.	
Project No.	
Drawing No.	C-6

PLANS 11 BORDER REF (L=11-29)
 REFERENCE FILES
 W-1 PLOT SCALE- (FULL SIZE)
 W-2 PLOT SCALE- (FULL SIZE)
 W-3 PLOT SCALE- (FULL SIZE)
 W-4 PLOT SCALE- (FULL SIZE)
 W-5 PLOT SCALE- (FULL SIZE)
 W-6 PLOT SCALE- (FULL SIZE)
 W-7 PLOT SCALE- (FULL SIZE)
 W-8 PLOT SCALE- (FULL SIZE)
 W-9 PLOT SCALE- (FULL SIZE)
 W-10 PLOT SCALE- (FULL SIZE)
 W-11 PLOT SCALE- (FULL SIZE)
 W-12 PLOT SCALE- (FULL SIZE)
 W-13 PLOT SCALE- (FULL SIZE)
 W-14 PLOT SCALE- (FULL SIZE)
 W-15 PLOT SCALE- (FULL SIZE)
 W-16 PLOT SCALE- (FULL SIZE)
 W-17 PLOT SCALE- (FULL SIZE)
 W-18 PLOT SCALE- (FULL SIZE)
 W-19 PLOT SCALE- (FULL SIZE)
 W-20 PLOT SCALE- (FULL SIZE)
 W-21 PLOT SCALE- (FULL SIZE)
 W-22 PLOT SCALE- (FULL SIZE)
 W-23 PLOT SCALE- (FULL SIZE)
 W-24 PLOT SCALE- (FULL SIZE)
 W-25 PLOT SCALE- (FULL SIZE)
 W-26 PLOT SCALE- (FULL SIZE)
 W-27 PLOT SCALE- (FULL SIZE)
 W-28 PLOT SCALE- (FULL SIZE)
 W-29 PLOT SCALE- (FULL SIZE)
 W-30 PLOT SCALE- (FULL SIZE)

WU1 00

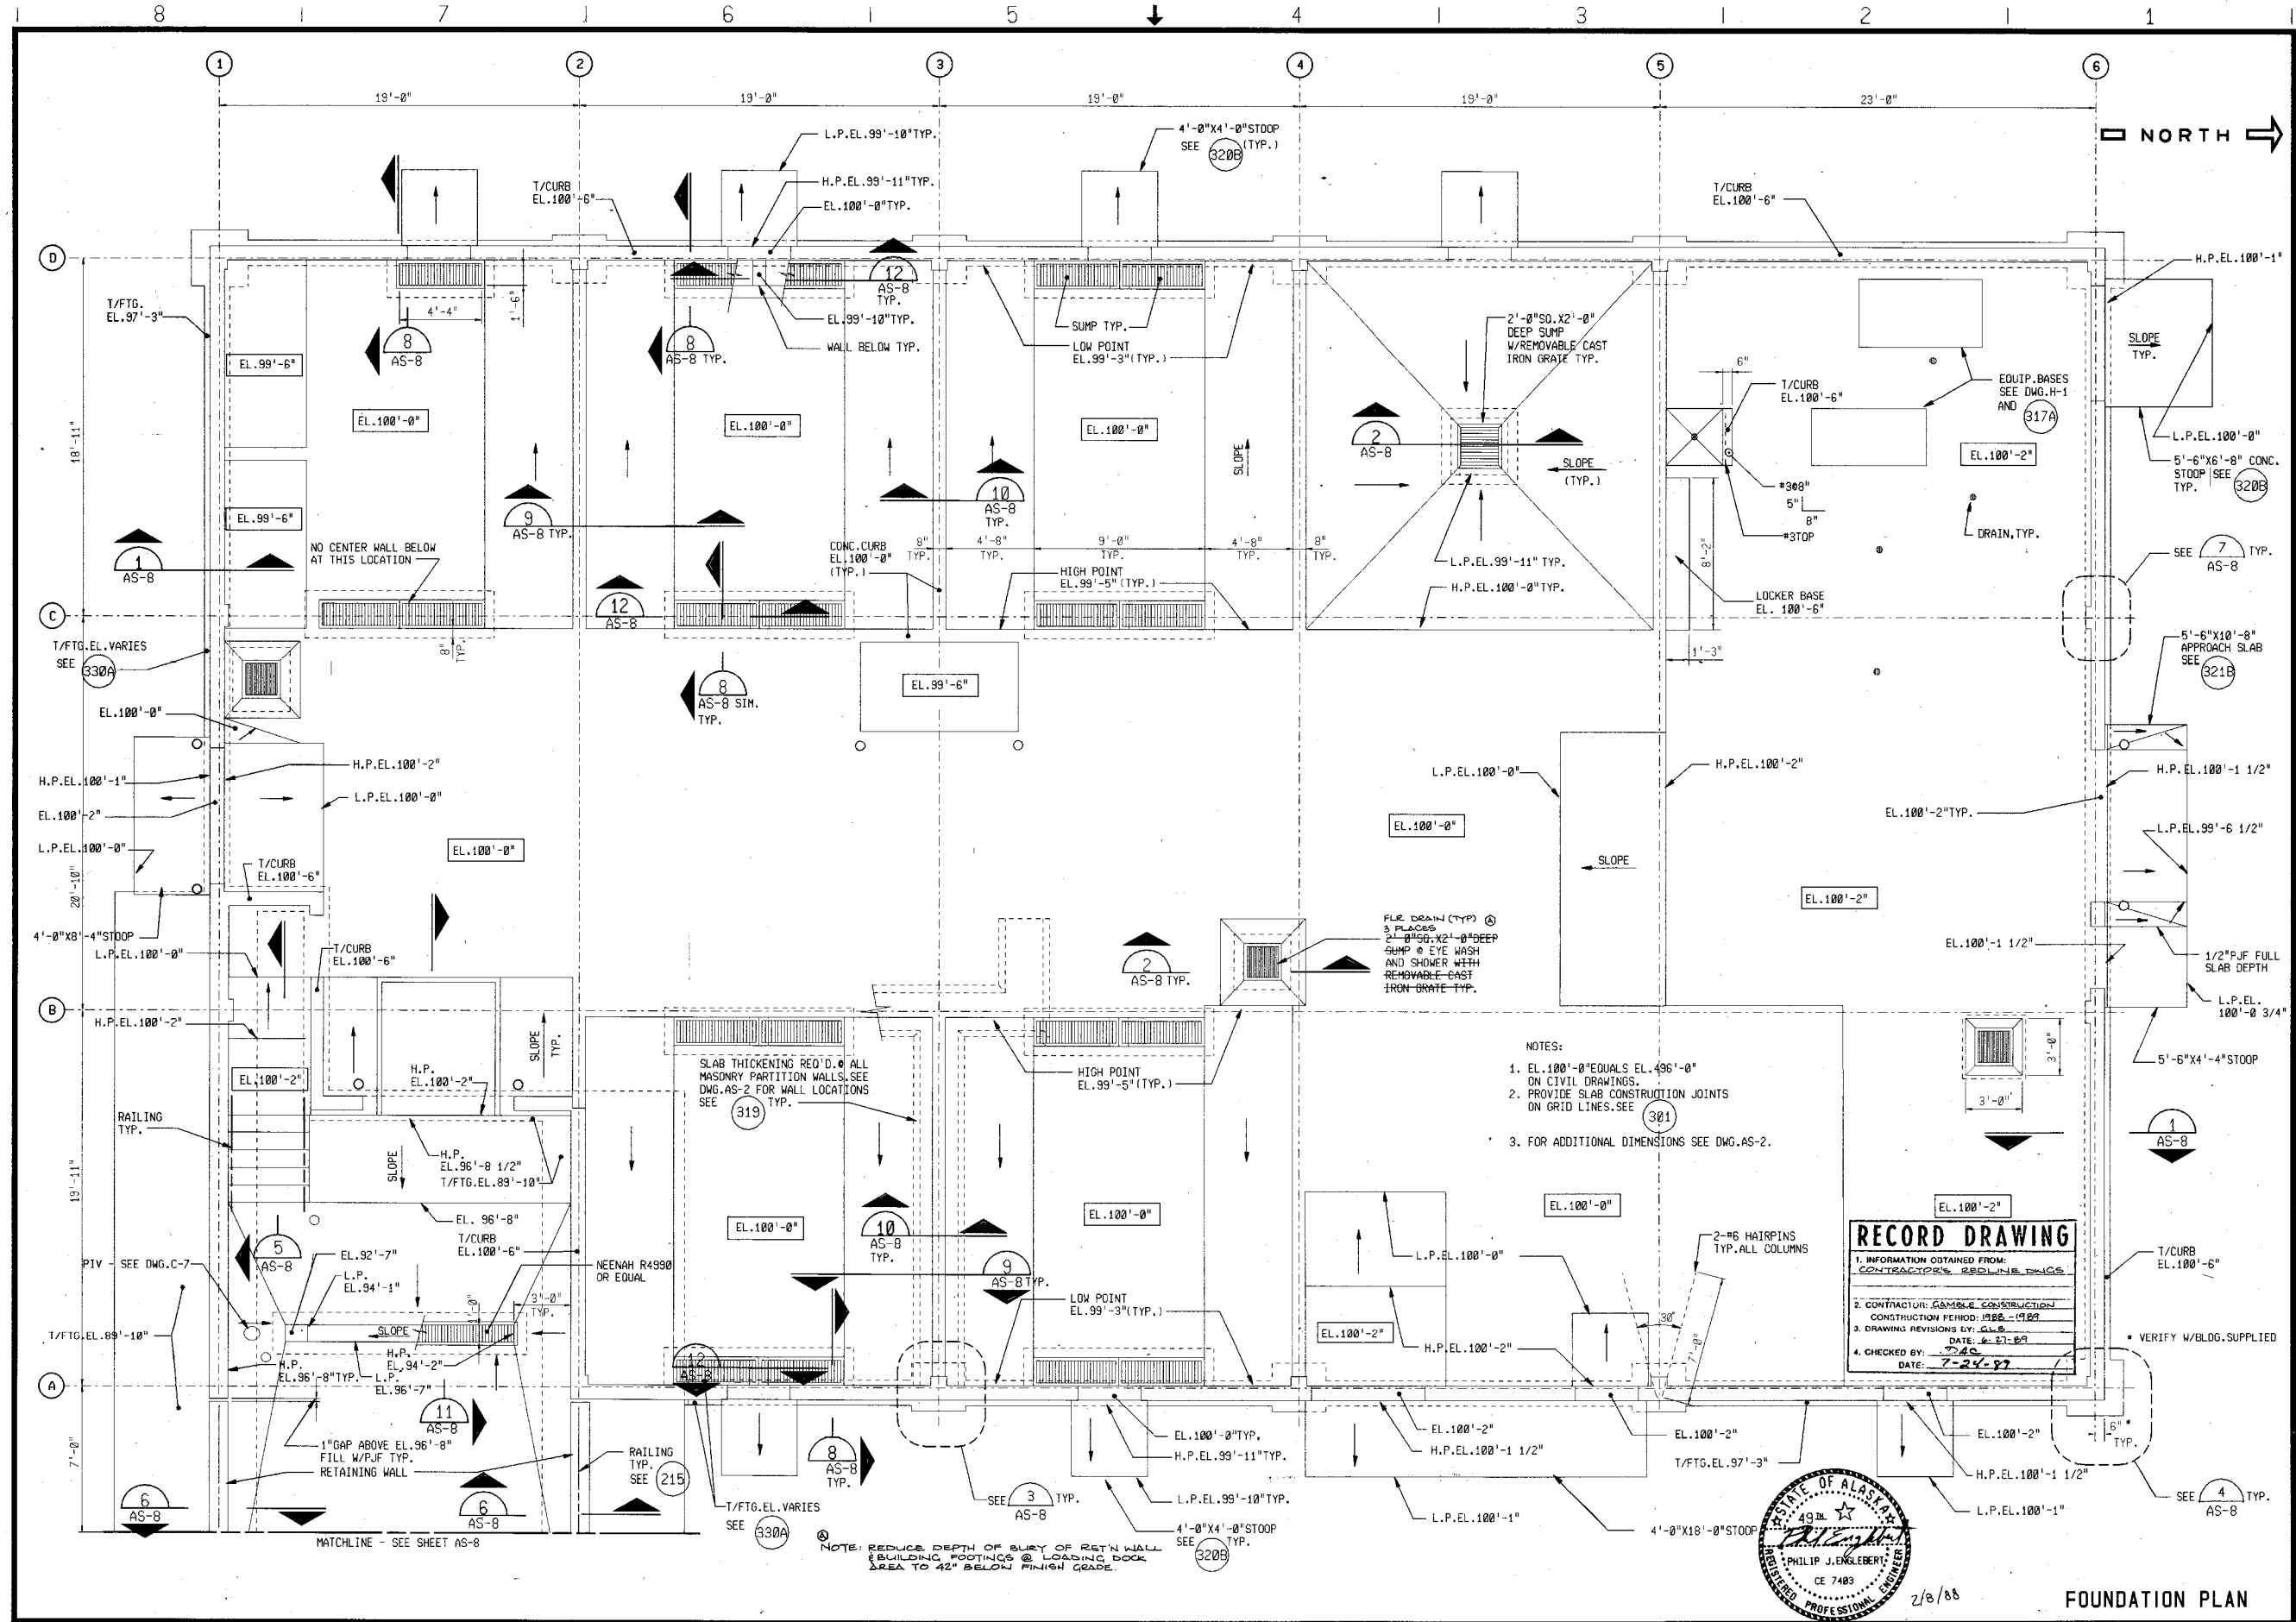

Scale	Date	Designer	Checker	Approver	By	Date
1/4"=1'-0"	2/5/88	AJB	MLJ/VEN	DLS	PJE	

Donohue
 Engineers & Architects
 COMPUTER AIDED DESIGN/DRAFTING
 1000 W. 11TH AVENUE
 ANCHORAGE, ALASKA 99501
 (907) 562-1111

CONTRACT DRAWINGS
HAZARDOUS WASTE STORAGE FACILITY
ANCHORAGE REGIONAL LANDFILL SITE
 ANCHORAGE, ALASKA

Sheet No.	10
File No.	A-58875
Project No.	15286
Drawing No.	AS-1

REFERENCE FILES
 RL=OS 1-1
 R2= 1-1
 R3= 1-1
 BORDER REF (LV-11-28)

HW- PLOT SCALE- 1:4
 PLOT NAME- S1
 (FULL SIZE)
 HW- PLOT SCALE- 1:4
 PLOT NAME- S1
 (FULL SIZE)

- NOTES:
 1. EL. 100'-0" EQUALS EL. 96'-0" ON CIVIL DRAWINGS.
 2. PROVIDE SLAB CONSTRUCTION JOINTS ON GRID LINES. SEE 301.
 3. FOR ADDITIONAL DIMENSIONS SEE DWG. AS-2.


RECORD DRAWING

1. INFORMATION OBTAINED FROM: CONTRACTOR'S RECORDING OFFICE

2. CONTRACTOR: GAMMA CONSTRUCTION
 CONSTRUCTION PERIOD: 1988 - 1989
 DATE: 6-27-89


3. DRAWING REVISIONS BY: DLS

4. CHECKED BY: PJE
 DATE: 7-24-87

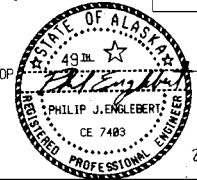

FOUNDATION PLAN

WU 60

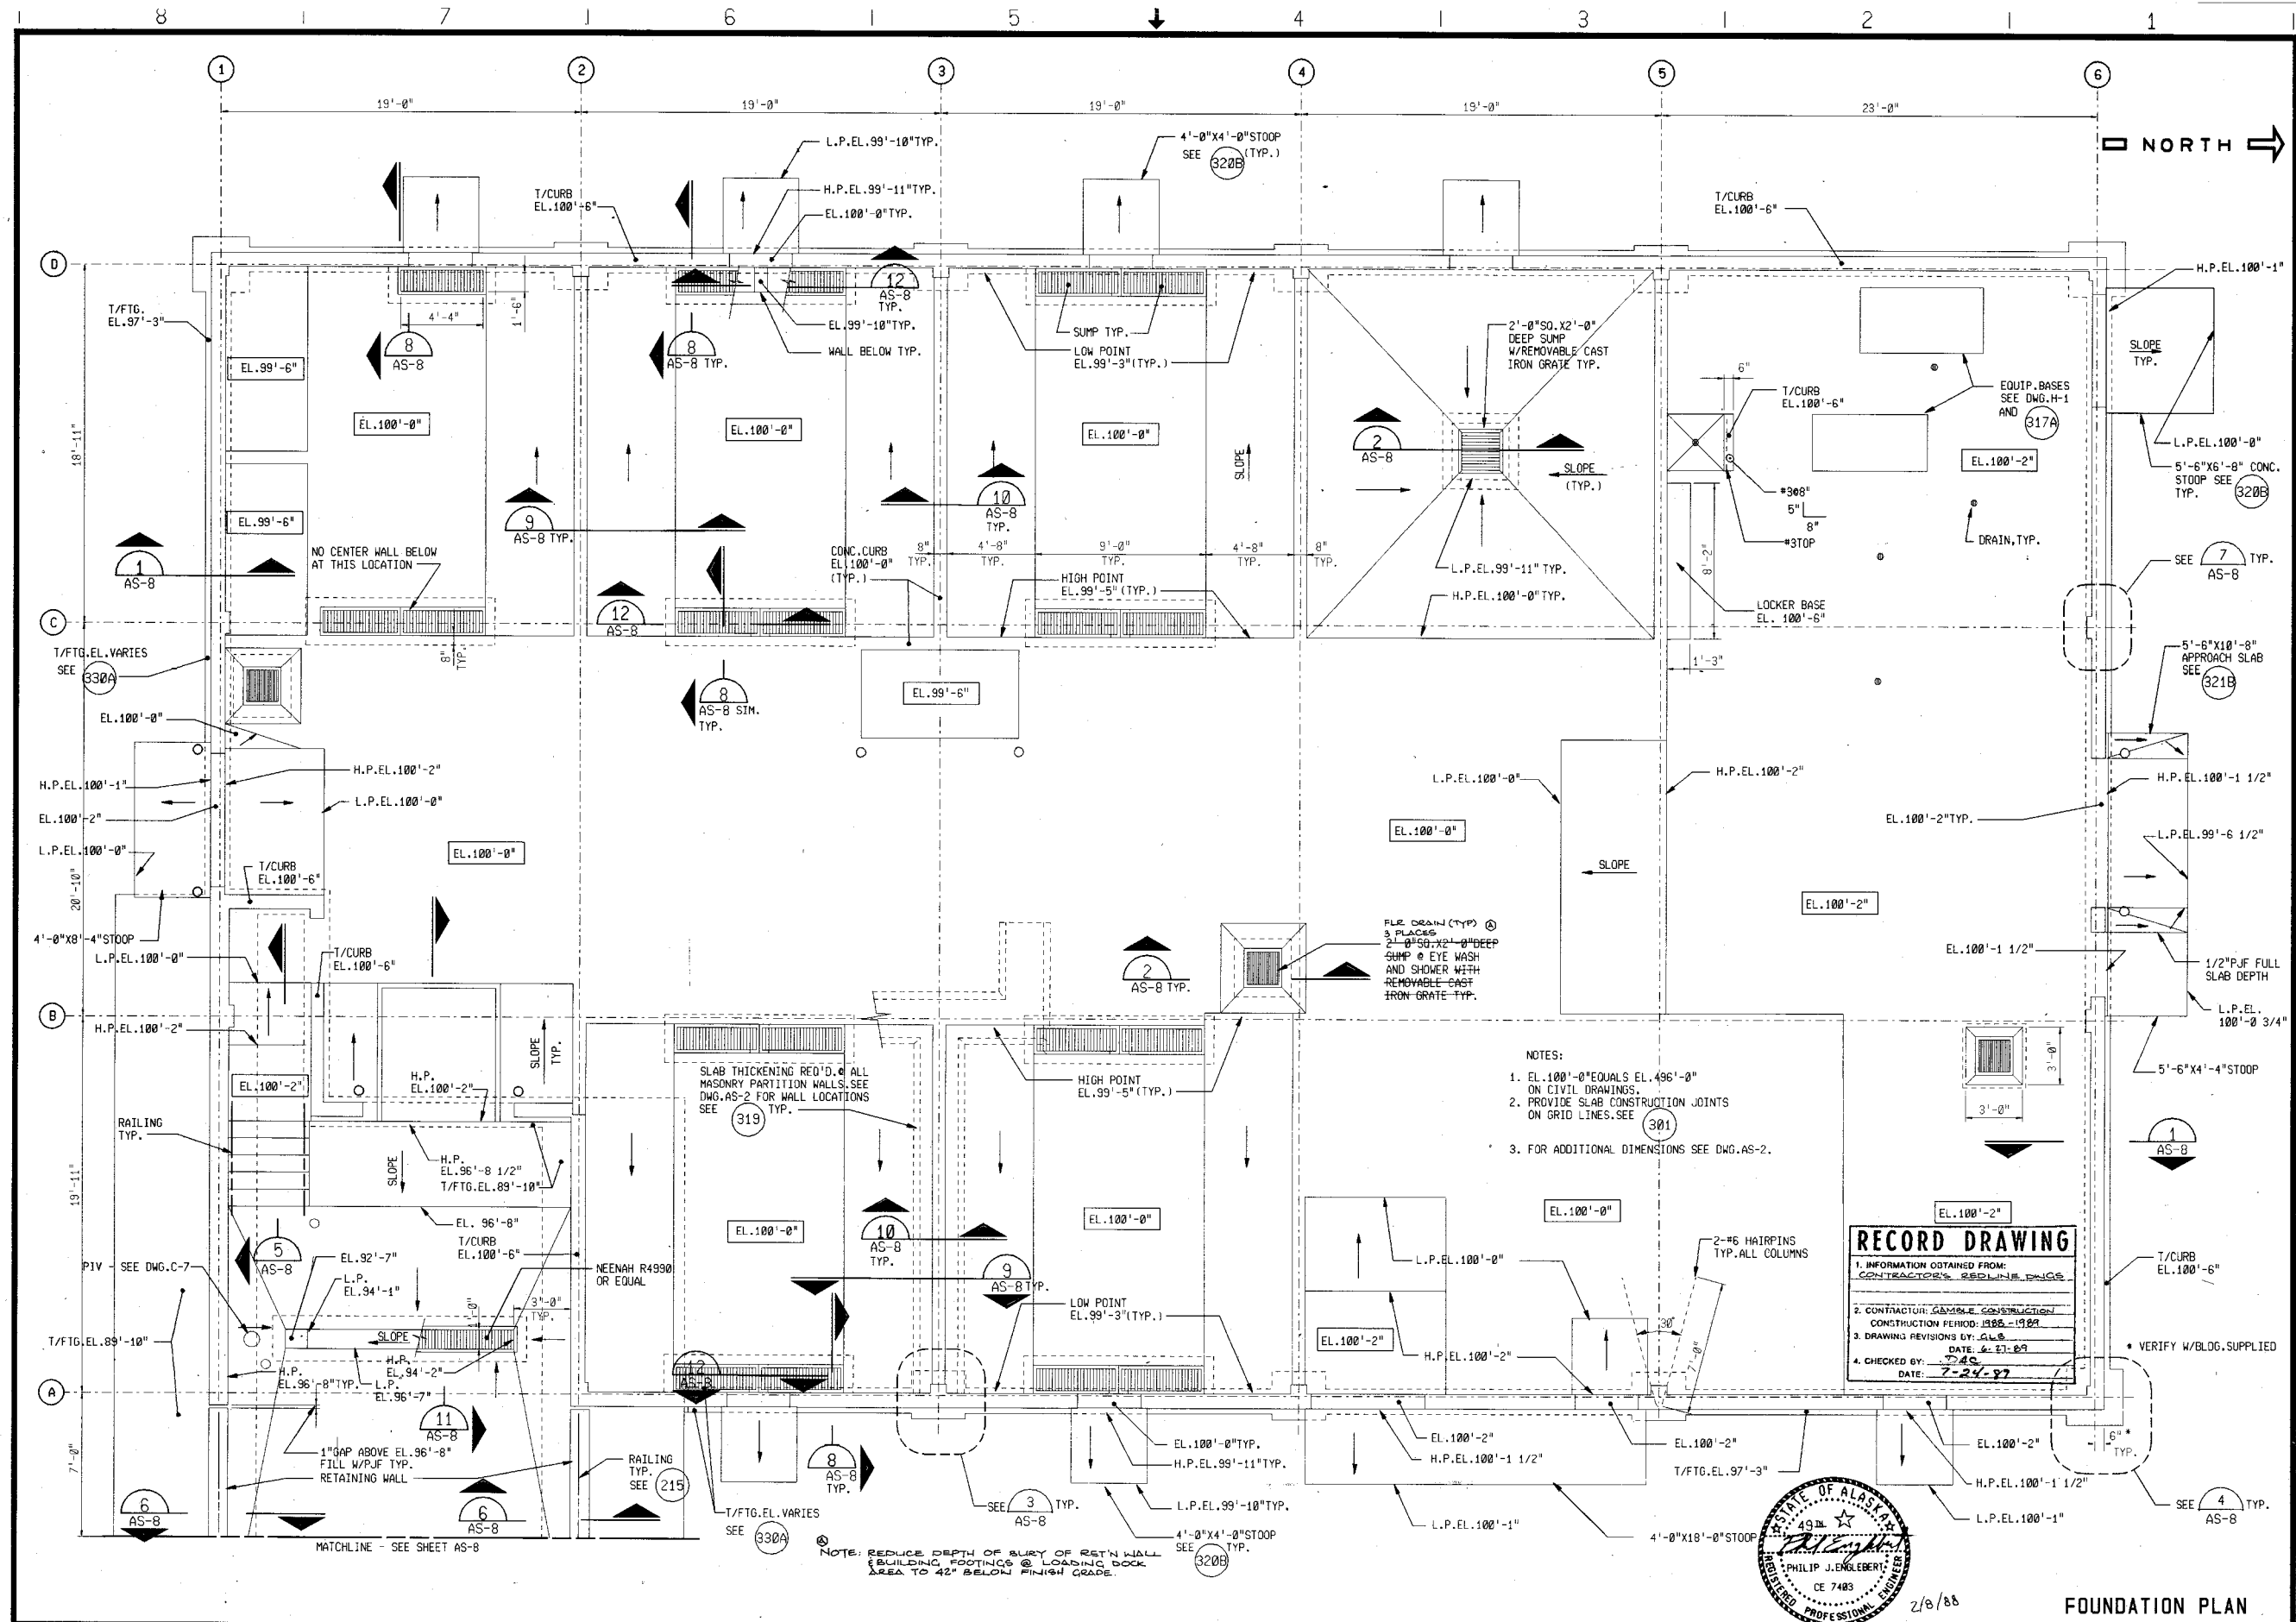

Scale	Date	Designer	Checker	Approver	By	Date
1/4"=1'-0"	2/5/88	AB	MLJ/VEN	ELS	P.E.	

Donohue
 Engineers & Architects
 COMPUTER AIDED DESIGN/DRAFTING
 ENGINEERS

CONTRACT DRAWINGS
HAZARDOUS WASTE STORAGE FACILITY
ANCHORAGE REGIONAL LANDFILL SITE
 ANCHORAGE, ALASKA

Sheet No.	10
File No.	A-50875
Project No.	15286
Drawing No.	AS-1

REFERENCE FILES
 R1-OS: I
 R2-
 R3-

WU-
 PLOT SCALE- 1:4
 PLOT NAME- S1
 (FULL SIZE)

0800
 WU-
 PLOT SCALE- 1:4
 PLOT NAME- S1
 (FULL SIZE)

- NOTES:
1. EL. 100'-0" EQUALS EL. 496'-0" ON CIVIL DRAWINGS.
 2. PROVIDE SLAB CONSTRUCTION JOINTS ON GRID LINES. SEE 301
 3. FOR ADDITIONAL DIMENSIONS SEE DWG. AS-2.


RECORD DRAWING

1. INFORMATION OBTAINED FROM: CONTRACTOR'S REEL/DWG.

2. CONTRACTOR GENERAL CONSTRUCTION PERIOD: 1985-1988


3. DRAWING REVISIONS BY: G.L.B. DATE: 4-27-89

4. CHECKED BY: T.A.C. DATE: 7-24-97

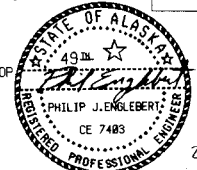

FOUNDATION PLAN

22-122

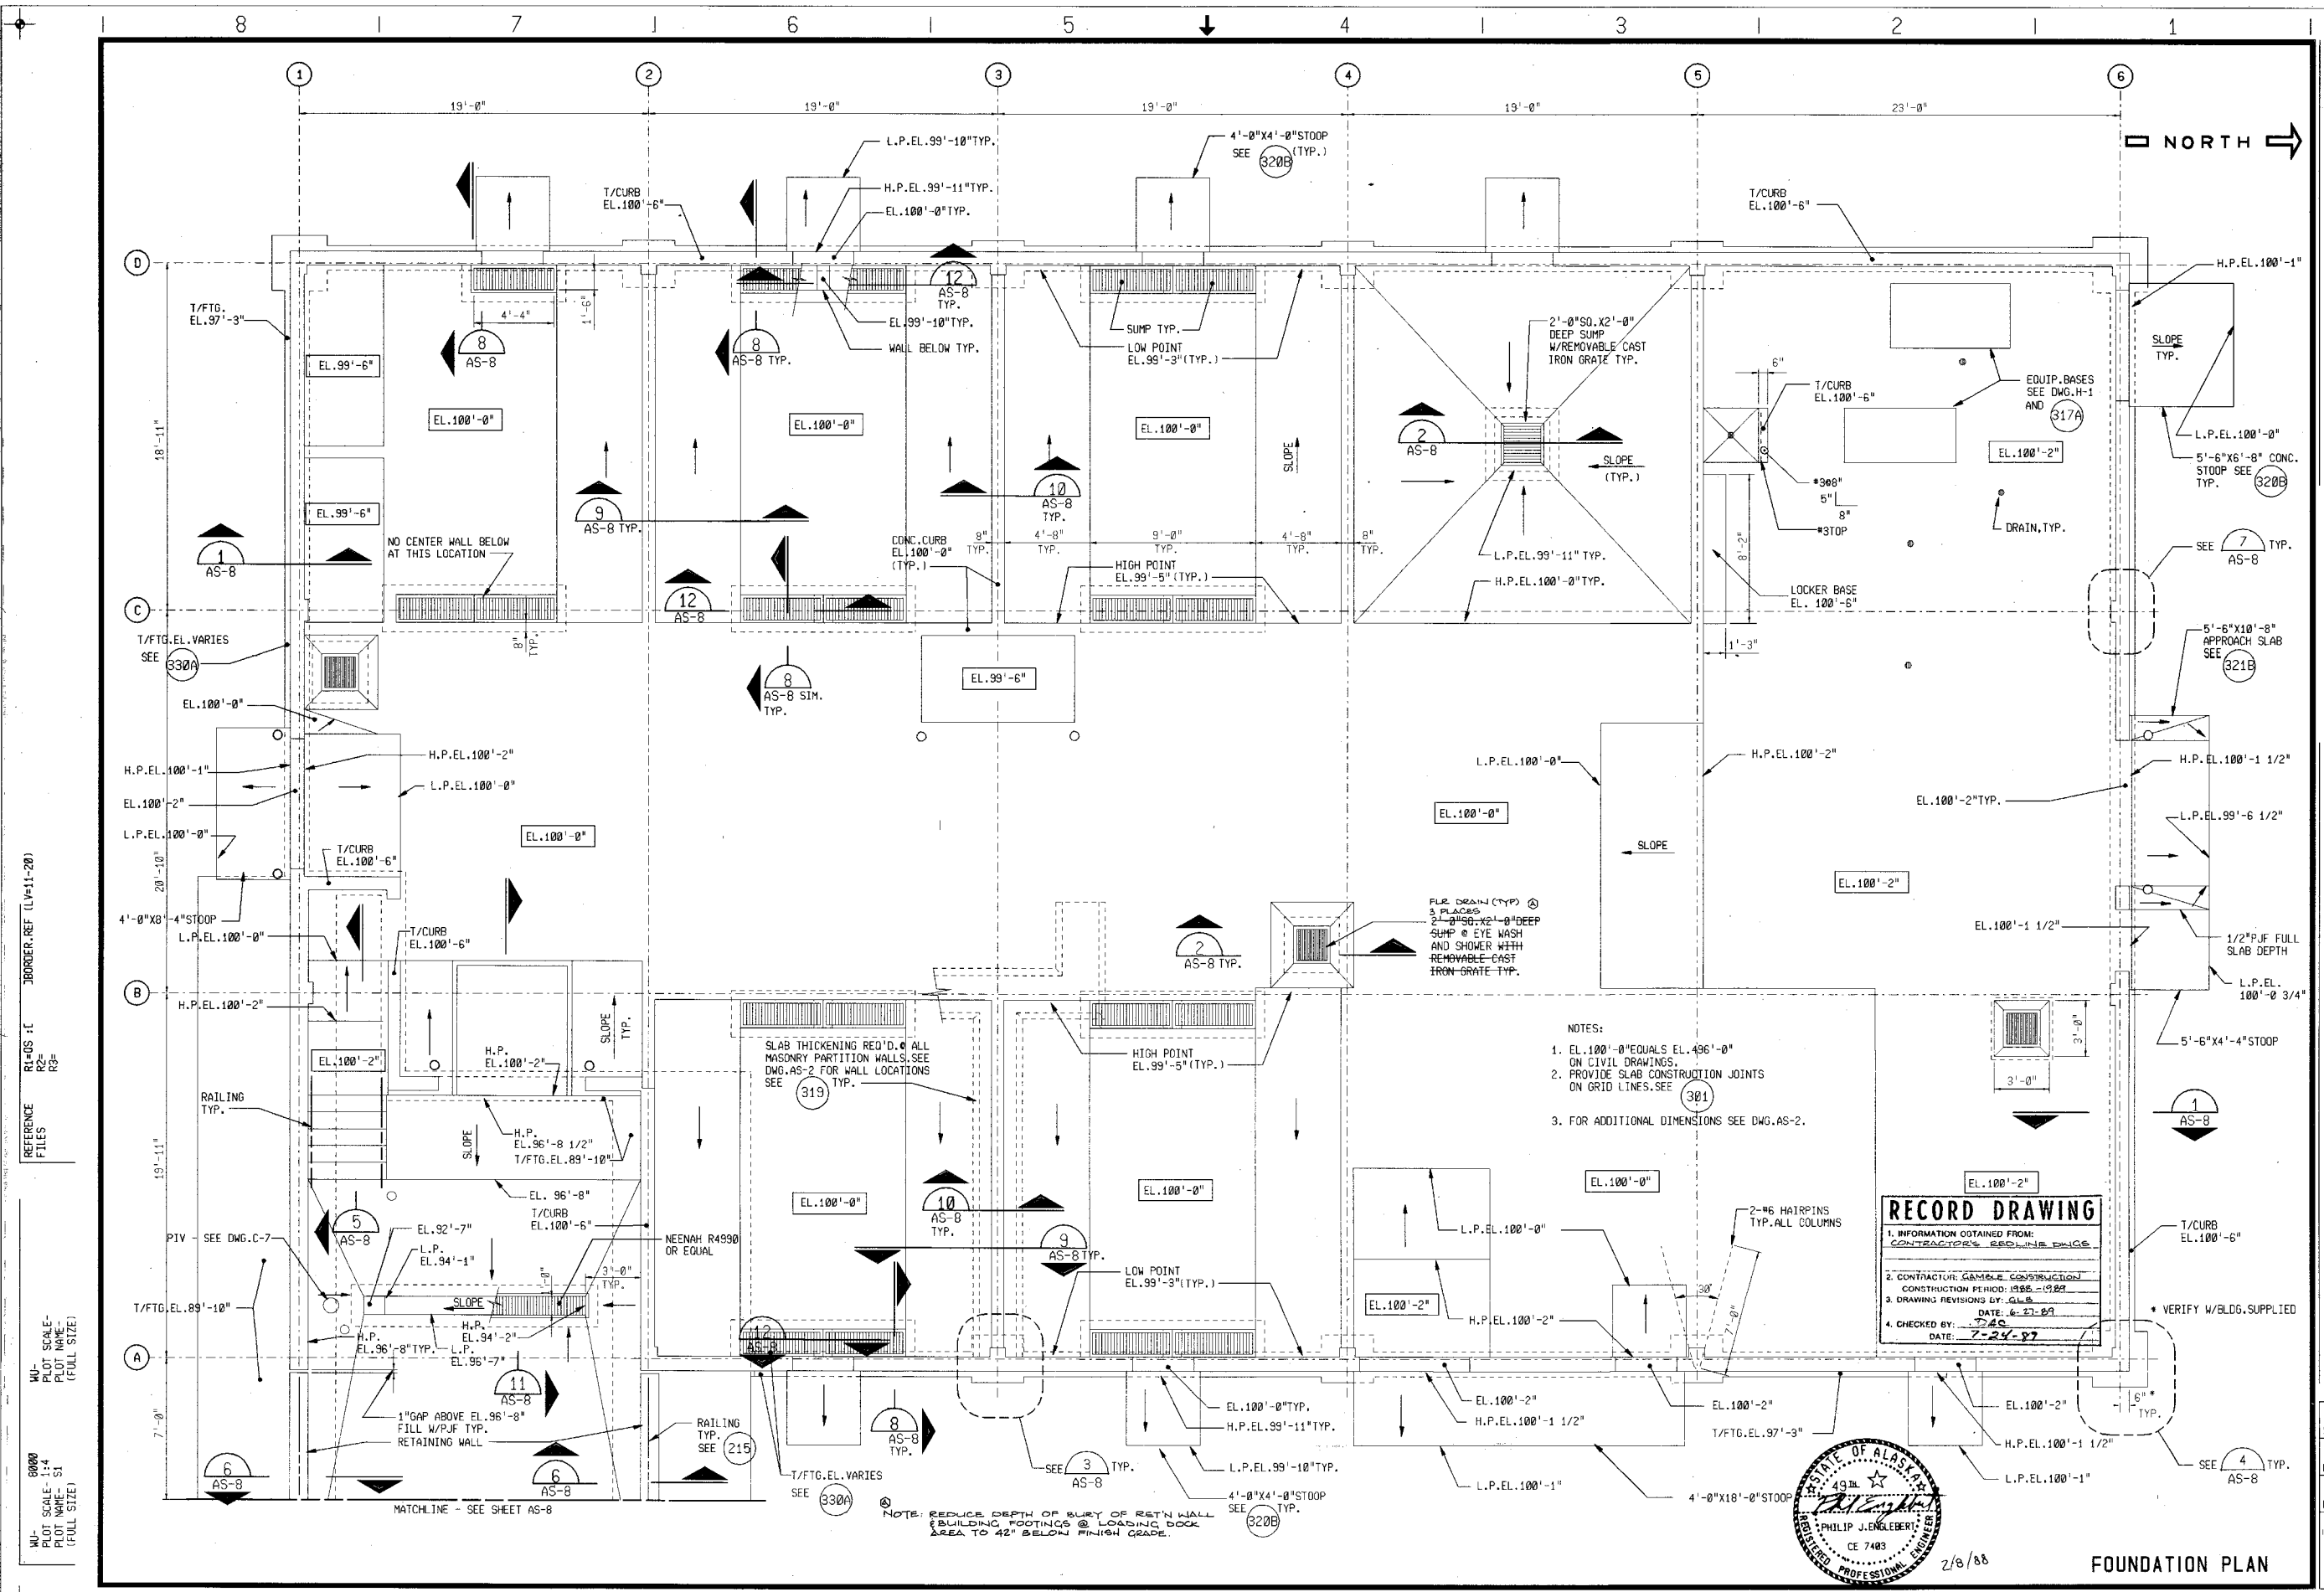

REFERENCE FILES
 RL=OS 1C
 R2= JORDNER REF (LW=11-20)
 R3=

90000
 PLOT SCALE- 1/4"
 PLOT NAME- S1
 (FULL SIZE)
 7'-0"

- NOTES:
1. EL. 100'-0" EQUALS EL. 496'-0" ON CIVIL DRAWINGS.
 2. PROVIDE SLAB CONSTRUCTION JOINTS ON GRID LINES. SEE 301
 3. FOR ADDITIONAL DIMENSIONS SEE DWG. AS-2.


RECORD DRAWING

1. INFORMATION OBTAINED FROM: CONTRACTOR'S REDLINE PAGE

2. CONTRACTOR: GEMBLE CONSTRUCTION
 CONSTRUCTION PERIOD: 1986 - 1987

3. DRAWING REVISIONS BY: JAS
 DATE: 6-27-89

4. CHECKED BY: JAS
 DATE: 7-24-87

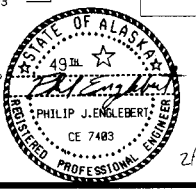

FOUNDATION PLAN


Scale	Date	Designer	Checker	Approver	No.	Revisions	By	Date
1/4"=1'-0"	2/5/88	AJB	ML/VEN	PLS	6			

Donohue
 Engineers & Architects
 COMPUTER AIDED DESIGN/DRAFTING
 600 W. ENGINEERS

CONTRACT DRAWINGS
HAZARDOUS WASTE STORAGE FACILITY
ANCHORAGE REGIONAL LANDFILL SITE
 ANCHORAGE, ALASKA

Sheet No.	10
File No.	A-50875
Project No.	15286
AS-1	Drawing No.

221-21A

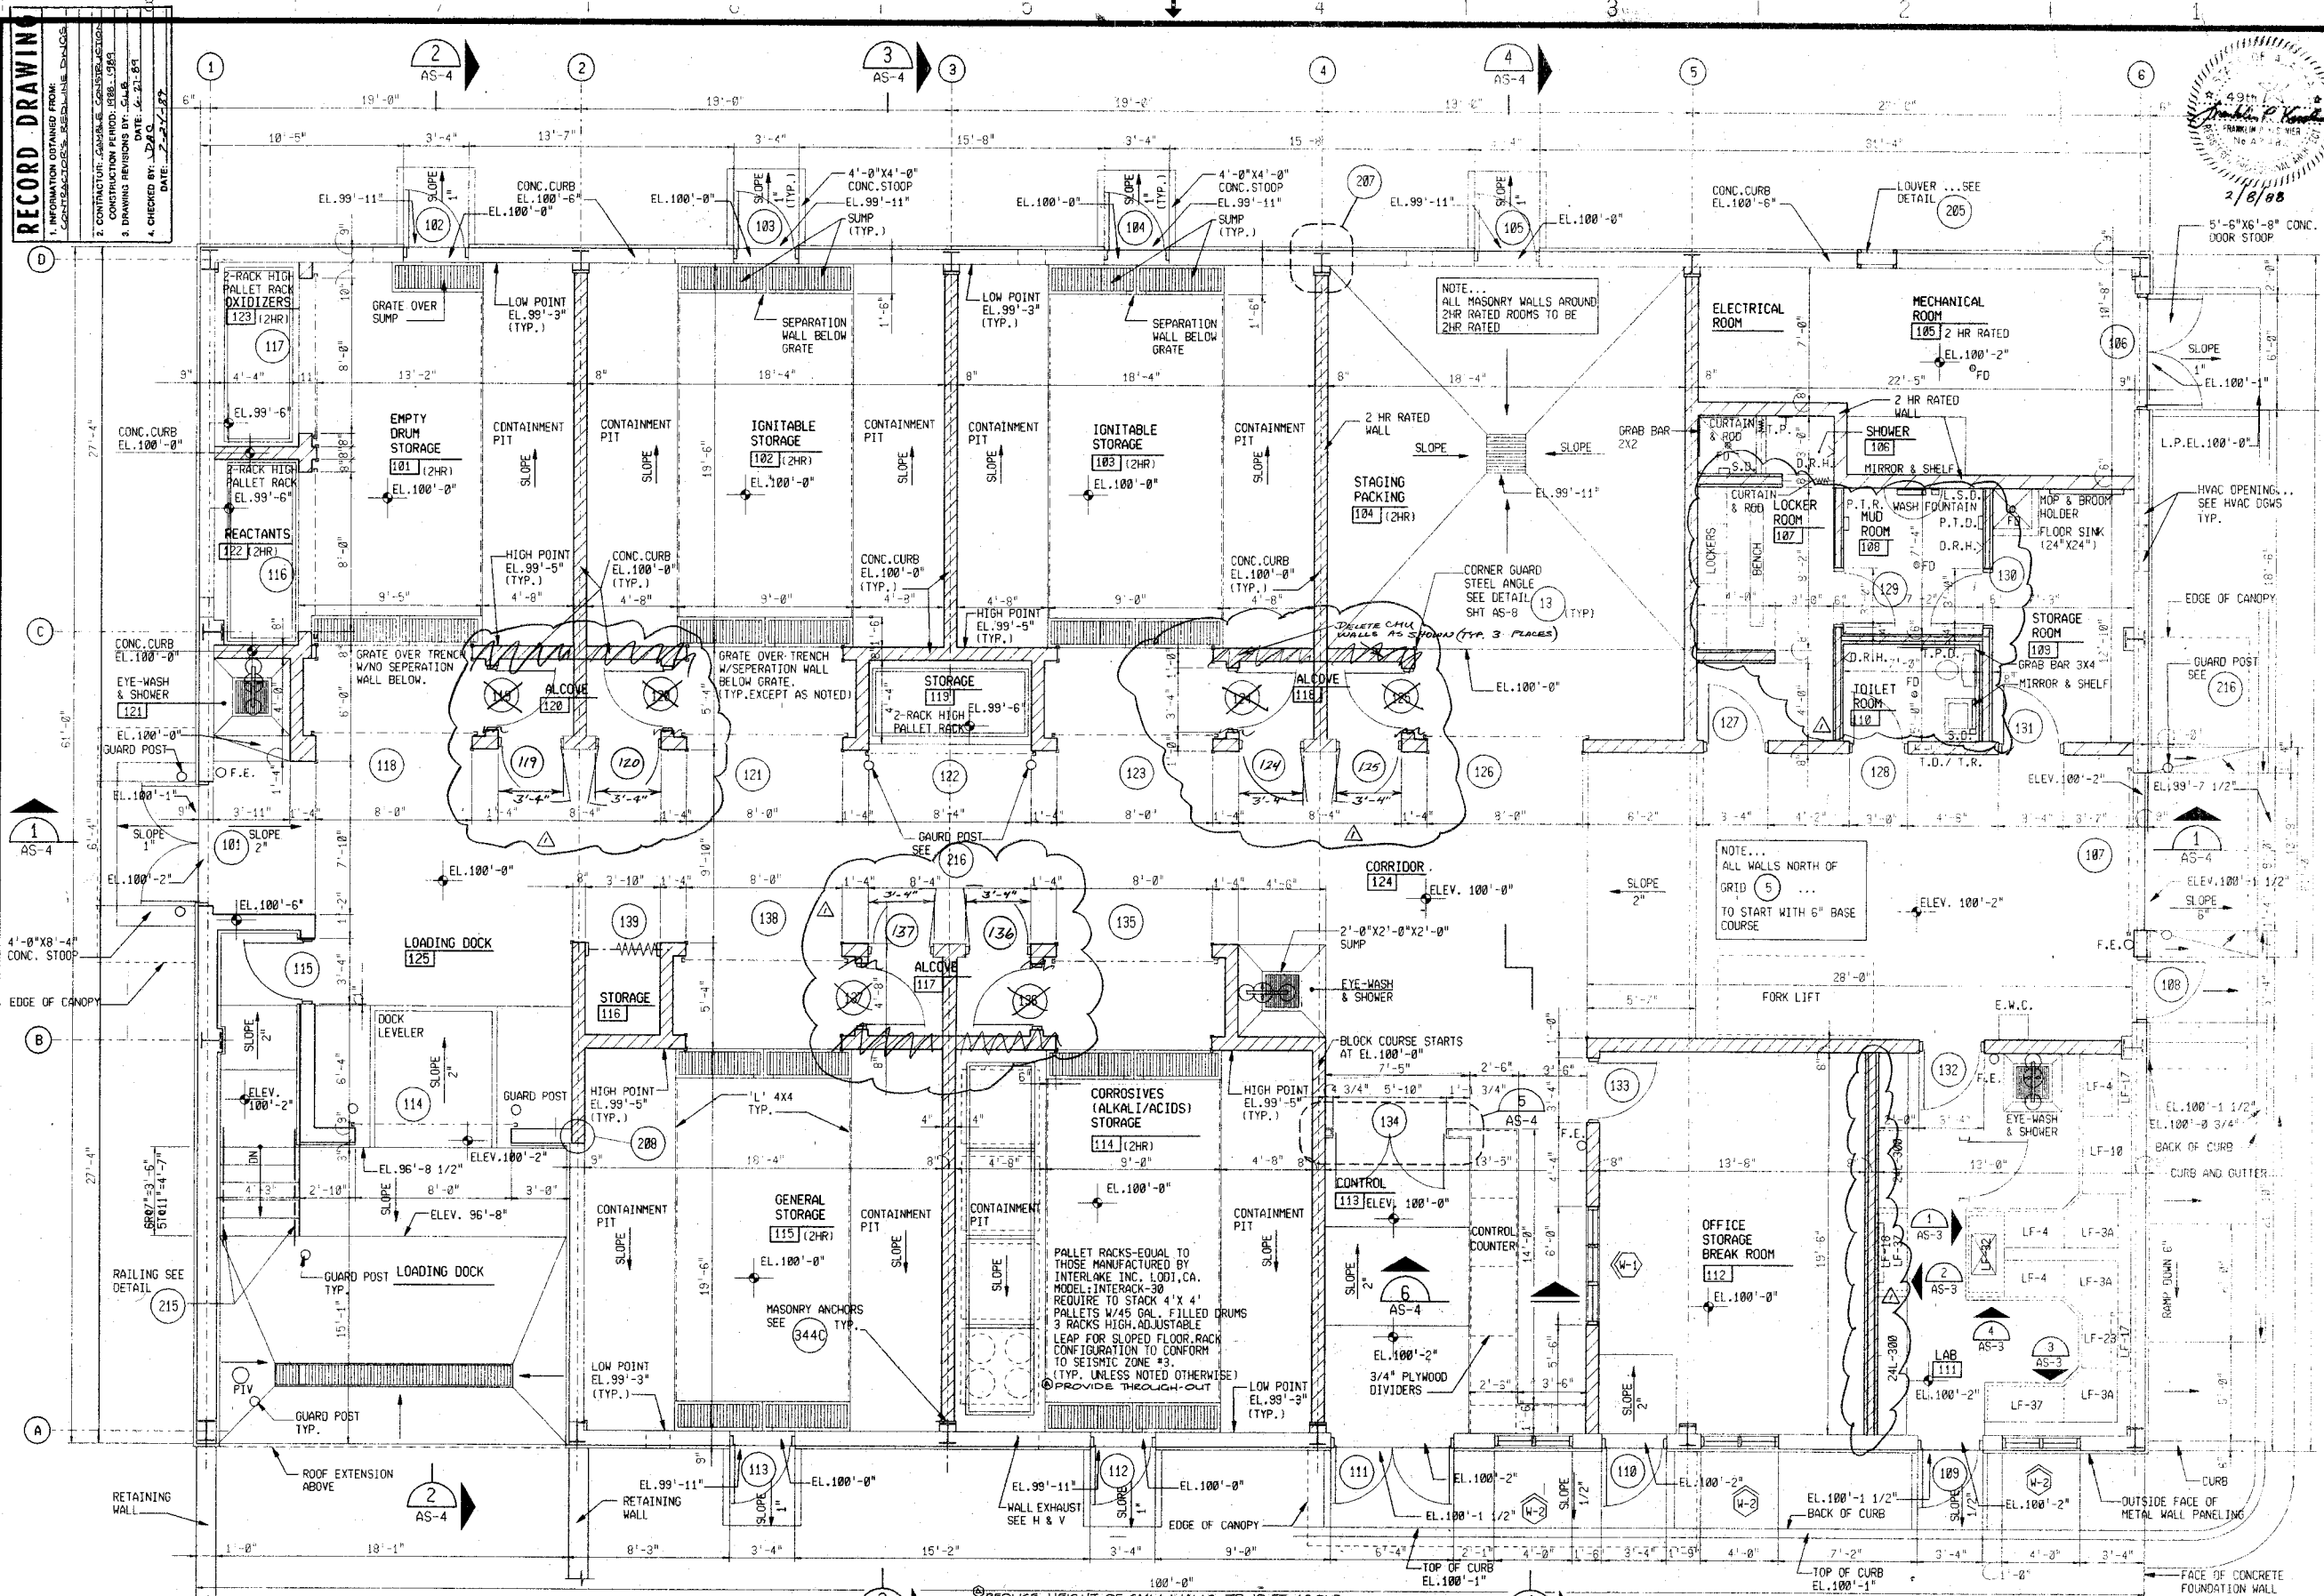

RECORD DRAWING

1. INFORMATION OBTAINED FROM: CONTRACTS, SPECIFICATIONS, PERMITS, DRAWINGS, ETC.

2. CONTRACTOR: CAVALLI CONSTRUCTION


3. CONSTRUCTION PERIOD: 1988-1989

4. DRAWING REVISIONS BY: G.A.B.

5. DATE: 4-27-87

6. CHECKED BY: J.D.A.C.

7. DATE: 2-27-87

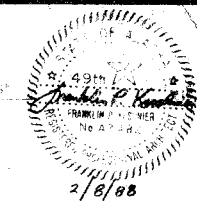

Scale	AS SHOWN
Date	2/9/88
Designer	FPK
Drafter	AHK
Checker	FPK
Approver	KEK
Revisors	By Date
No.	

Donohue
Engineers & Architects
COMPUTER AIDED DESIGN/DRAFTING
ENGINEERS

CONTRACT DRAWINGS
HAZARDOUS WASTE STORAGE FACILITY
ANCHORAGE REGIONAL LANDFILL SITE
ANCHORAGE, ALASKA

Sheet No. 11
File No. A-50874
Project No. 15286

FLOOR PLAN
1/4"=1'-0"


FIRST FLOOR PLAN

REDUCE HEIGHT OF CMU WALLS TO 10 FT ABOVE FINISHED FLOOR AND FRAME ON TOP OF CMU TO UNDERSIDE OF ROOF WITH 6-INCH METAL STUD AND CYBOARD FRAMING (2 HR. FIRE RATING)

CHANGE ISSUED 9-27-88, D.A.C. ELIMINATE 3-ALCOVES AS SHOWN IN CLOUDED AREAS, CHANGE CHIL WALLS TO FRAMED WALLS

AS-2

221-21

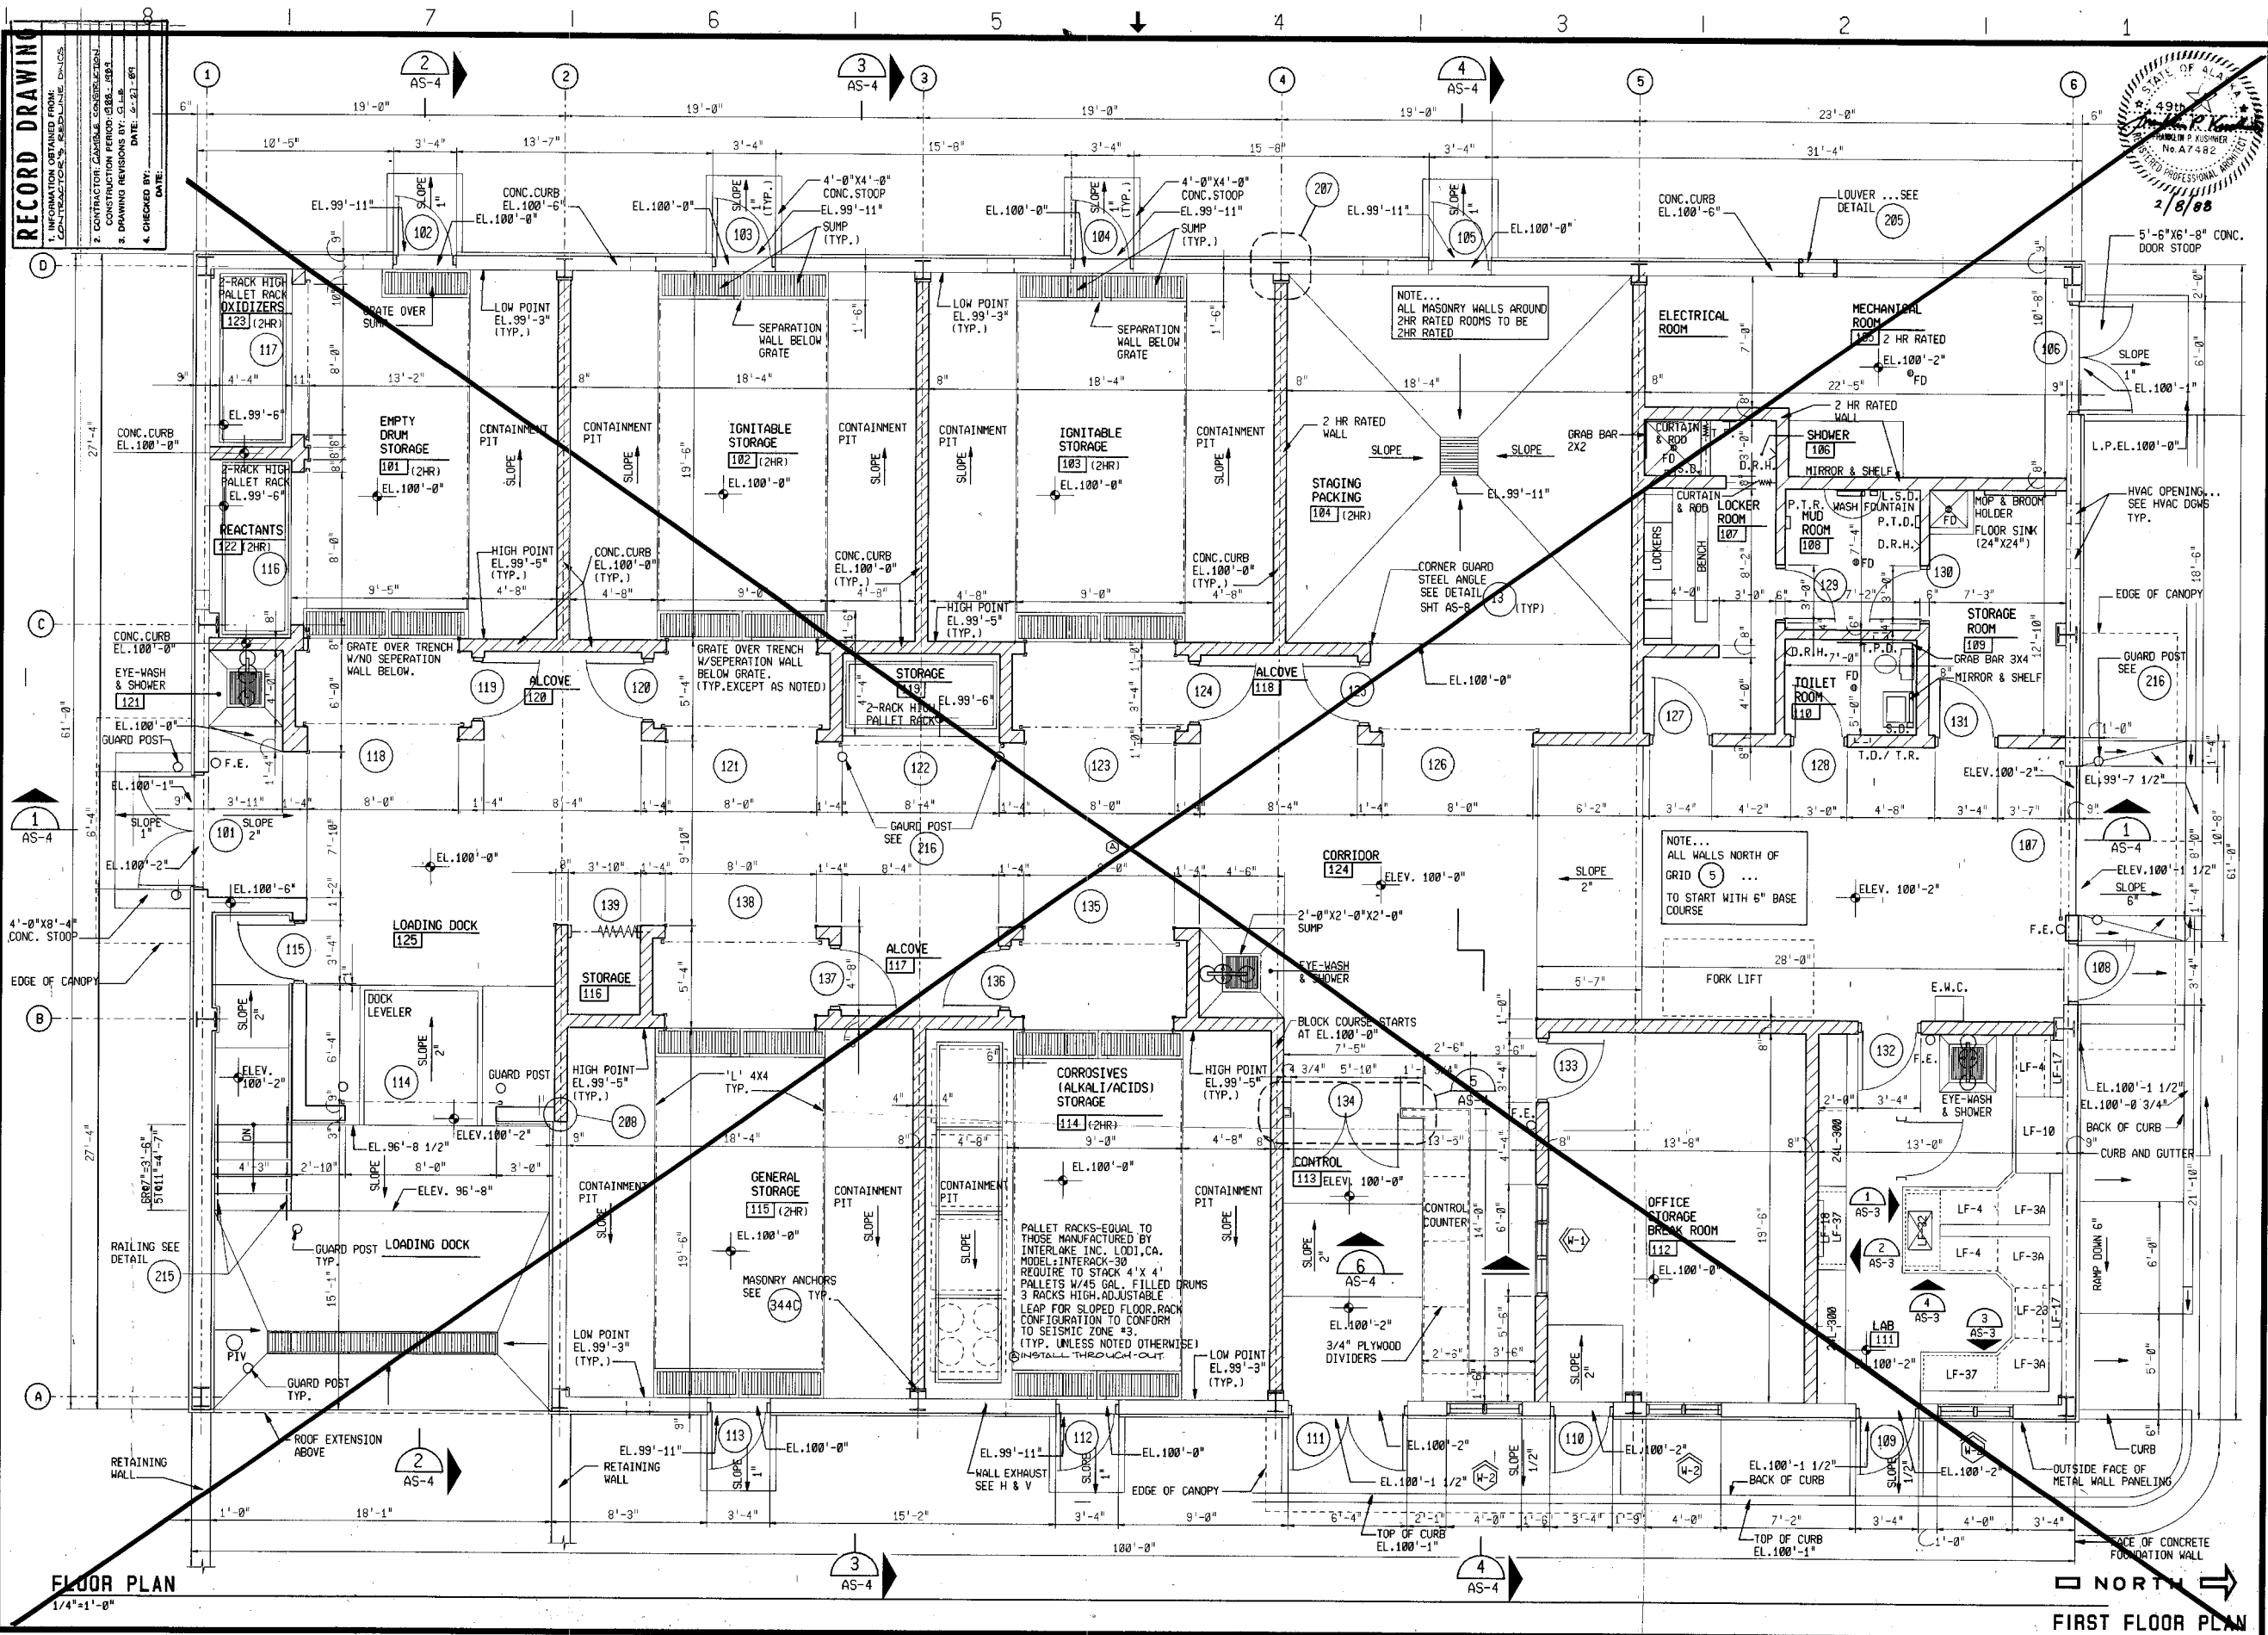


RECORD DRAWING

1. INFORMATION OBTAINED FROM CONTRACTOR'S RECORDINGS

2. CONTRACTOR: CANNON CONSTRUCTION

3. DRAWING REVISIONS BY: G.L.B.

4. CHECKED BY: DATE: 2/21/88

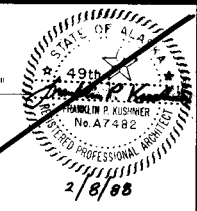

Scale	AS SHOWN
Date	2/25/88
Designer	FPK
Dr.-officer	AKH
Checker	FPK
Approver	KEH

Donohue
Engineers & Architects
COMPUTER AIDED DESIGN/DRAFTING
ENGINEERS


CONTRACT DRAWINGS
HAZARDOUS WASTE STORAGE FACILITY
ANCHORAGE REGIONAL LANDFILL SITE
ANCHORAGE, ALASKA

Sheet No.	11
File No.	A-50874
Project No.	15266
AS-2	


FLOOR PLAN
1/4"=1'-0"
FIRST FLOOR PLAN




8 | 7 | 6 | 5 | 4 | 3 | 2 | 1

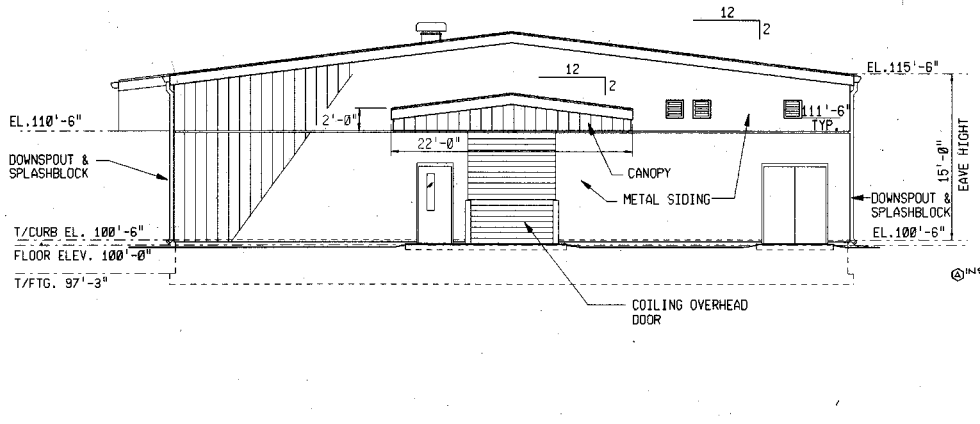


NORTH ELEVATION
1/8"=1'-0"

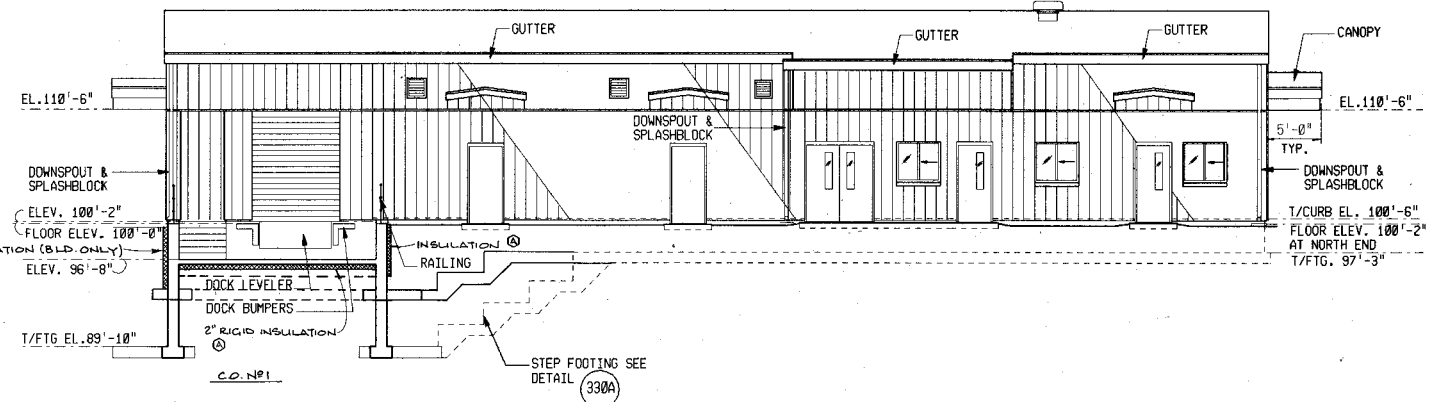


EAST ELEVATION
1/8"=1'-0"

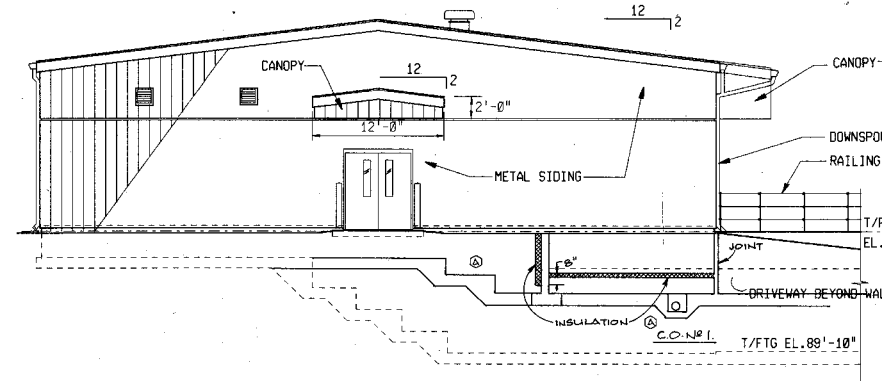


SOUTH ELEVATION
1/8"=1'-0"

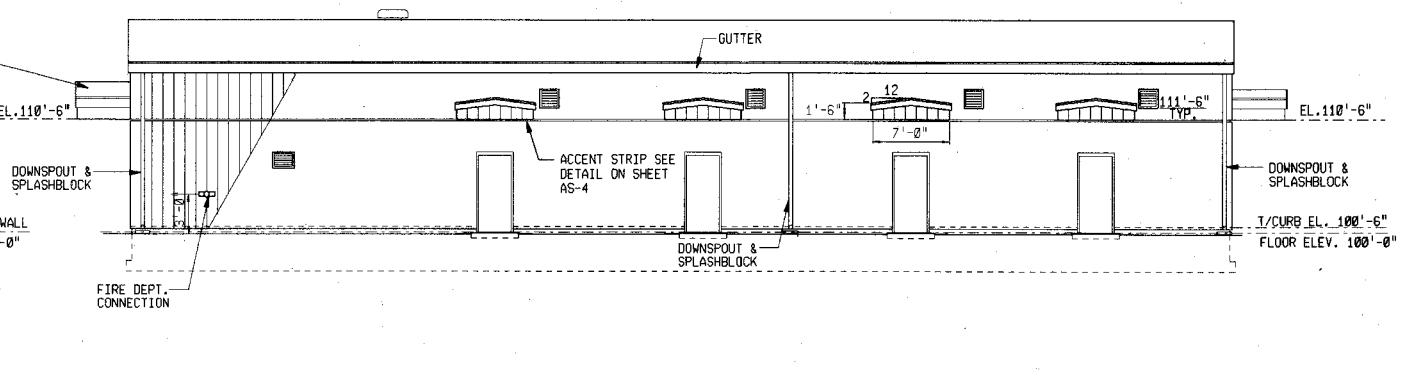


WEST ELEVATION
1/8"=1'-0"

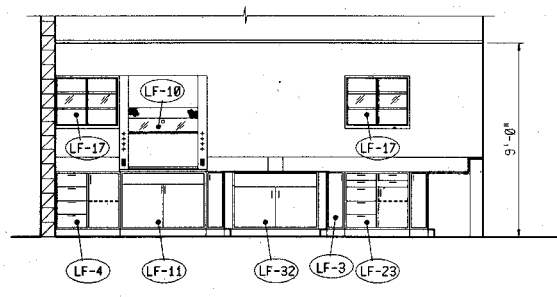


ELEVATION 1
LAB CABINET ELEVATIONS
1/4"=1'-0"

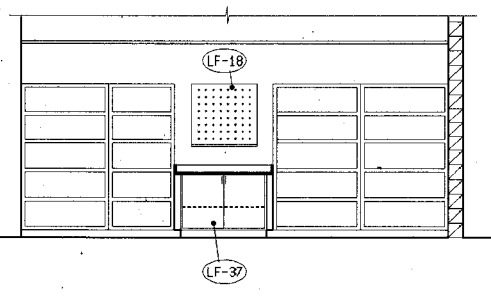

ELEVATION 2

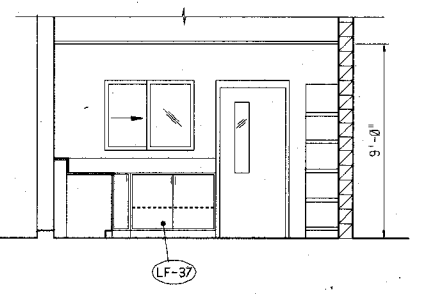


ELEVATION 3

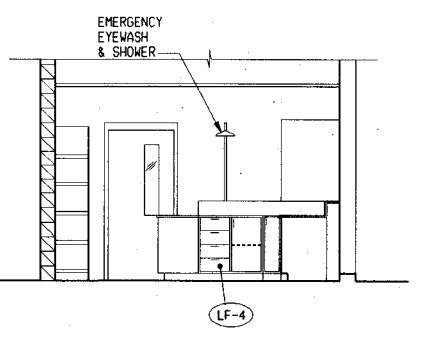

ELEVATION 4

RECORD DRAWING
1. INFORMATION OBTAINED FROM:
CONTRACTOR'S REPLY SHEET
2. CONTRACTOR: GAMBLE CONSTRUCTION
CONSTRUCTION PERIOD: 1988-1989
3. DRAWING REVISIONS BY: CLE
DATE: 12-27-89
4. CHECKED BY: TAC
DATE: 7-24-89

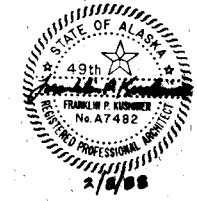

BUILDING ELEVATIONS

Scale	Date	Designer	Checker	Approver	No.	Revisions	By	Date
AS SHOWN	2/5/88	FFK	FFK	FFK				

Donohue
Engineers & Architects
COMPUTER AIDED DESIGN/DRAFTING
REGISTERED PROFESSIONAL ENGINEERS


CONTRACT DRAWINGS
HAZARDOUS WASTE STORAGE FACILITY
ANCHORAGE REGIONAL LANDFILL SITE
ANCHORAGE, ALASKA

Sheet No. 12
File No. A-50873
Project No. 15286

AS-3
Drawing No.


661-60

8 | 7 | 6 | 5 | 4 | 3 | 2 | 1

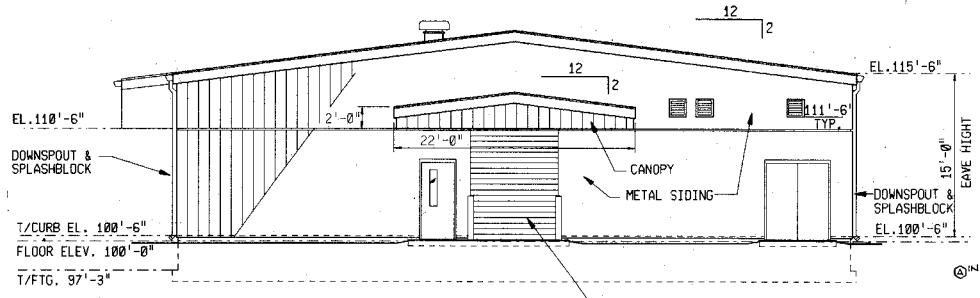


NORTH ELEVATION

1/8"=1'-0"

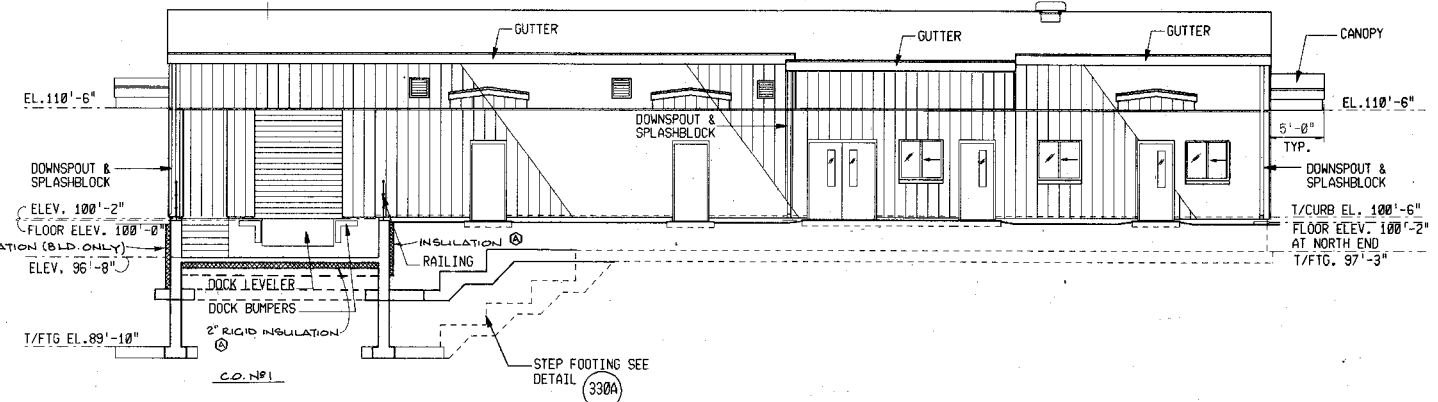


EAST ELEVATION

1/8"=1'-0"

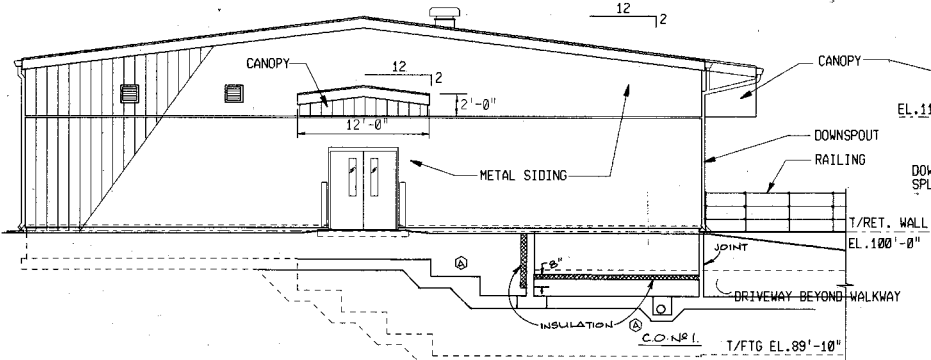


SOUTH ELEVATION

1/8"=1'-0"

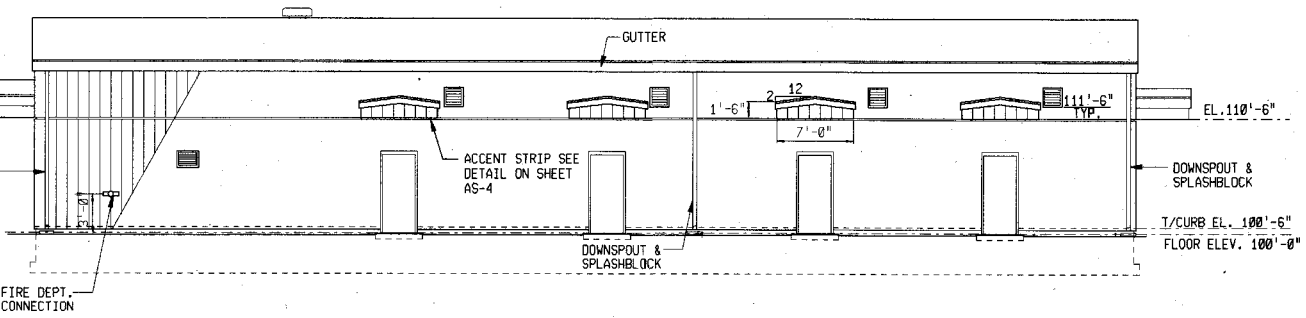

WEST ELEVATION


1/8"=1'-0"

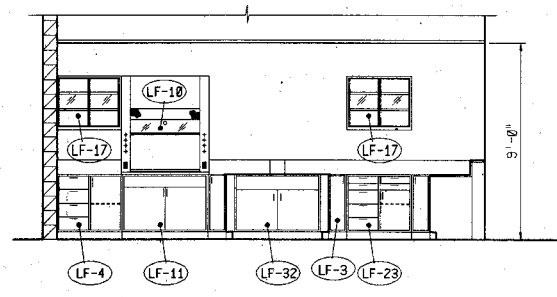


ELEVATION 1

LAB CABINET ELEVATIONS


1/4"=1'-0"

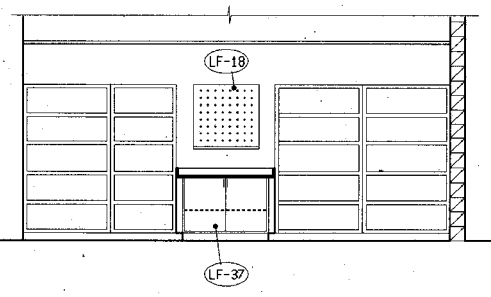

ELEVATION 2

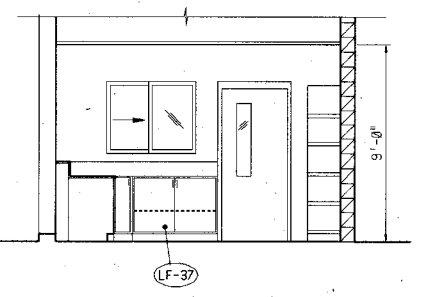

ELEVATION 3

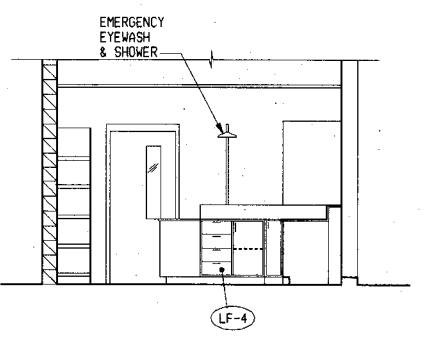

ELEVATION 4

RECORD DRAWING	
1. INFORMATION OBTAINED FROM: CONTRACTOR'S RECORDING DEVICE	
2. CONTRACTOR: GAMBLE CONSTRUCTION	
CONSTRUCTION PERIOD: 1988 - 1989	
3. DRAWING REVISIONS BY: CLS	
DATE: 6-27-89	
4. CHECKED BY: TAC	
DATE: 7-24-89	



BUILDING ELEVATIONS

Scale	AS SHOWN	Date	2/5/88	Designer	EPK	Checker	AKK	Approver	KEH	No.	Revisions	By	Date

Donohue
Engineers & Architects
 COMPUTER AIDED DESIGN/DRAFTING
 ENGINEERS

CONTRACT DRAWINGS
HAZARDOUS WASTE STORAGE FACILITY
ANCHORAGE REGIONAL LANDFILL SITE
 ANCHORAGE, ALASKA


Sheet No.	12
File No.	A-58873
Project No.	15286

AS-3

Drawing No.


221-20

8 | 7 | 6 | 5 | 4 | 3 | 2 | 1

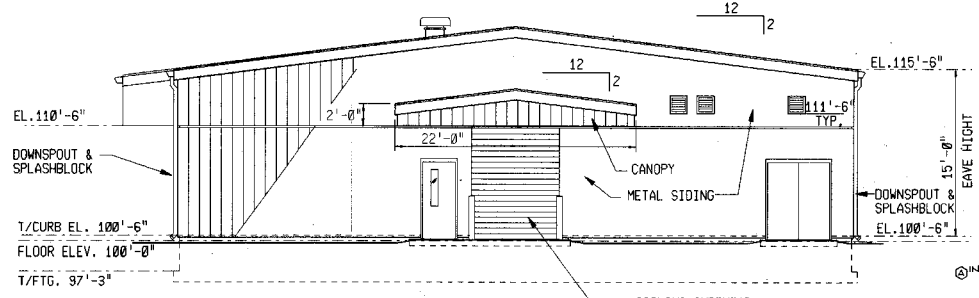


NORTH ELEVATION

1/8"=1'-0"

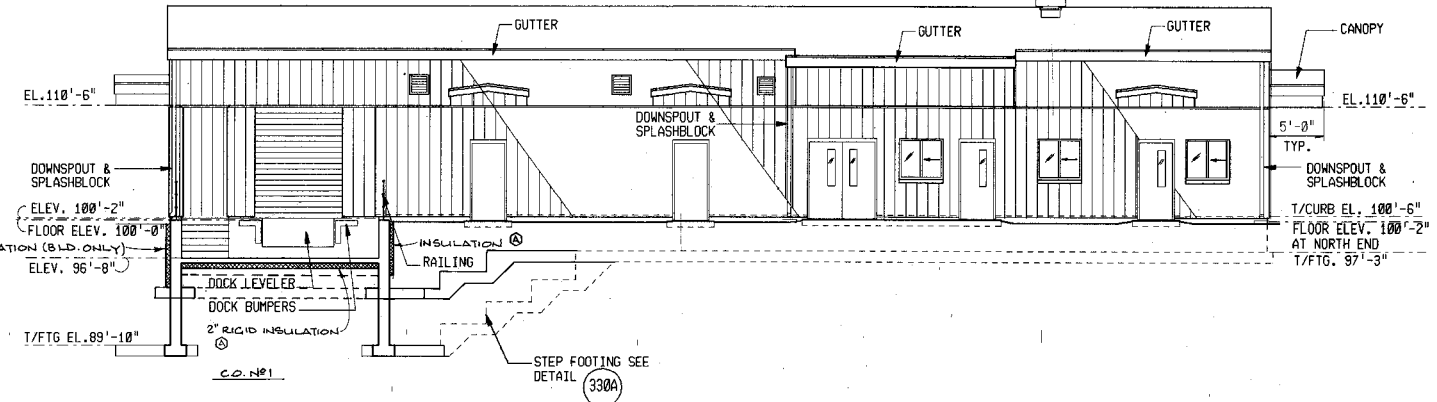


EAST ELEVATION

1/8"=1'-0"

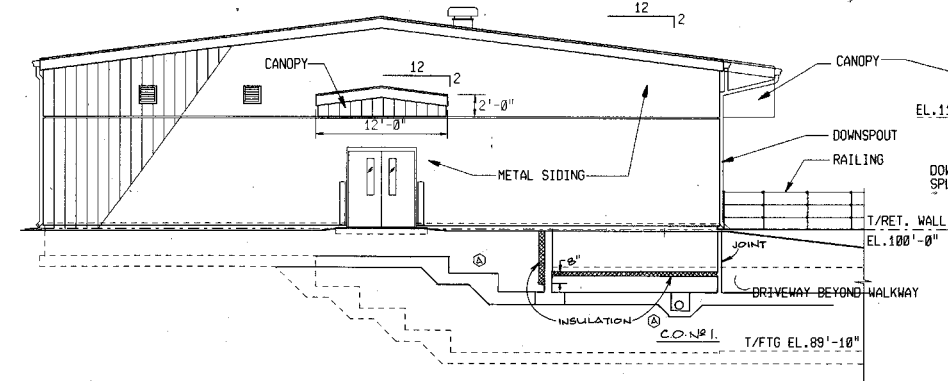


SOUTH ELEVATION

1/8"=1'-0"

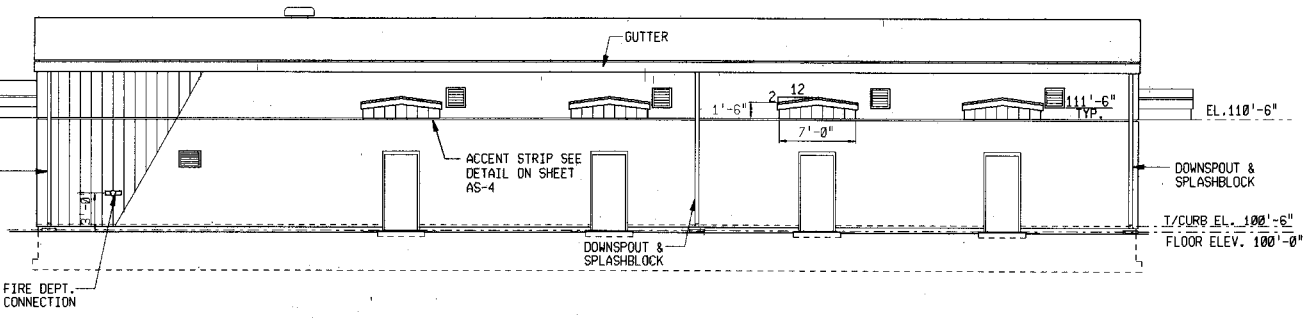

WEST ELEVATION


1/8"=1'-0"

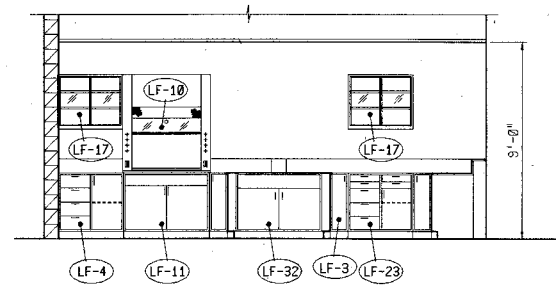


ELEVATION 1

LAB CABINET ELEVATIONS


1/4"=1'-0"

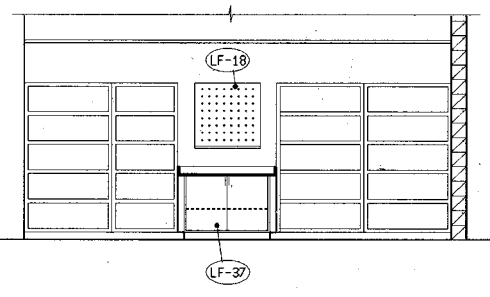

ELEVATION 2

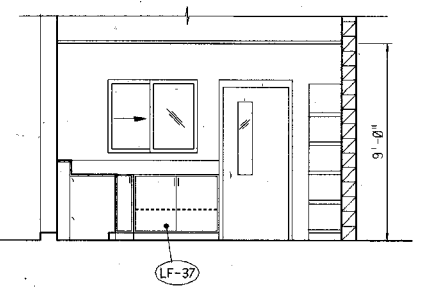


ELEVATION 3

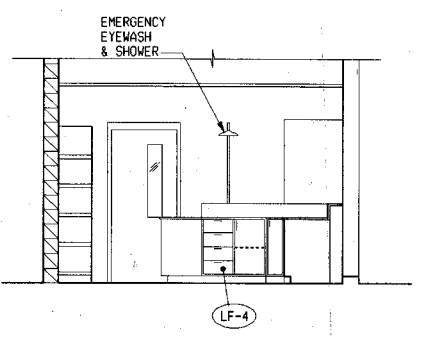

ELEVATION 4

RECORD DRAWING	
1. INFORMATION OBTAINED FROM: CONTRACTOR'S RECORD DRAWINGS	
2. CONTRACTOR: GAMBLE CONSTRUCTION	
CONSTRUCTION PERIOD: 1988 - 1989	
3. DRAWING REVISIONS BY: GMB	
DATE: 6-27-89	
4. CHECKED BY: JAC	
DATE: 7-24-89	

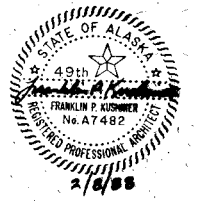

BUILDING ELEVATIONS

Scale	AS SHOWN
Date	2/5/88
Designer	PFK
Drafter	AHK
Checker	PFK
Approver	KEH
No.	
Revisions	
By	
Date	

Donohue
Engineers & Architects
COMPUTER AIDED DESIGN/DRAFTING
REGISTERED PROFESSIONAL ENGINEERS
DBWL


CONTRACT DRAWINGS
HAZARDOUS WASTE STORAGE FACILITY
ANCHORAGE REGIONAL LANDFILL SITE
ANCHORAGE, ALASKA

Sheet No.	12
File No.	A-50873
Project No.	15286

AS-3

Drawing No.
DESIGN FILE ELEV.ARC 221-20

66-111

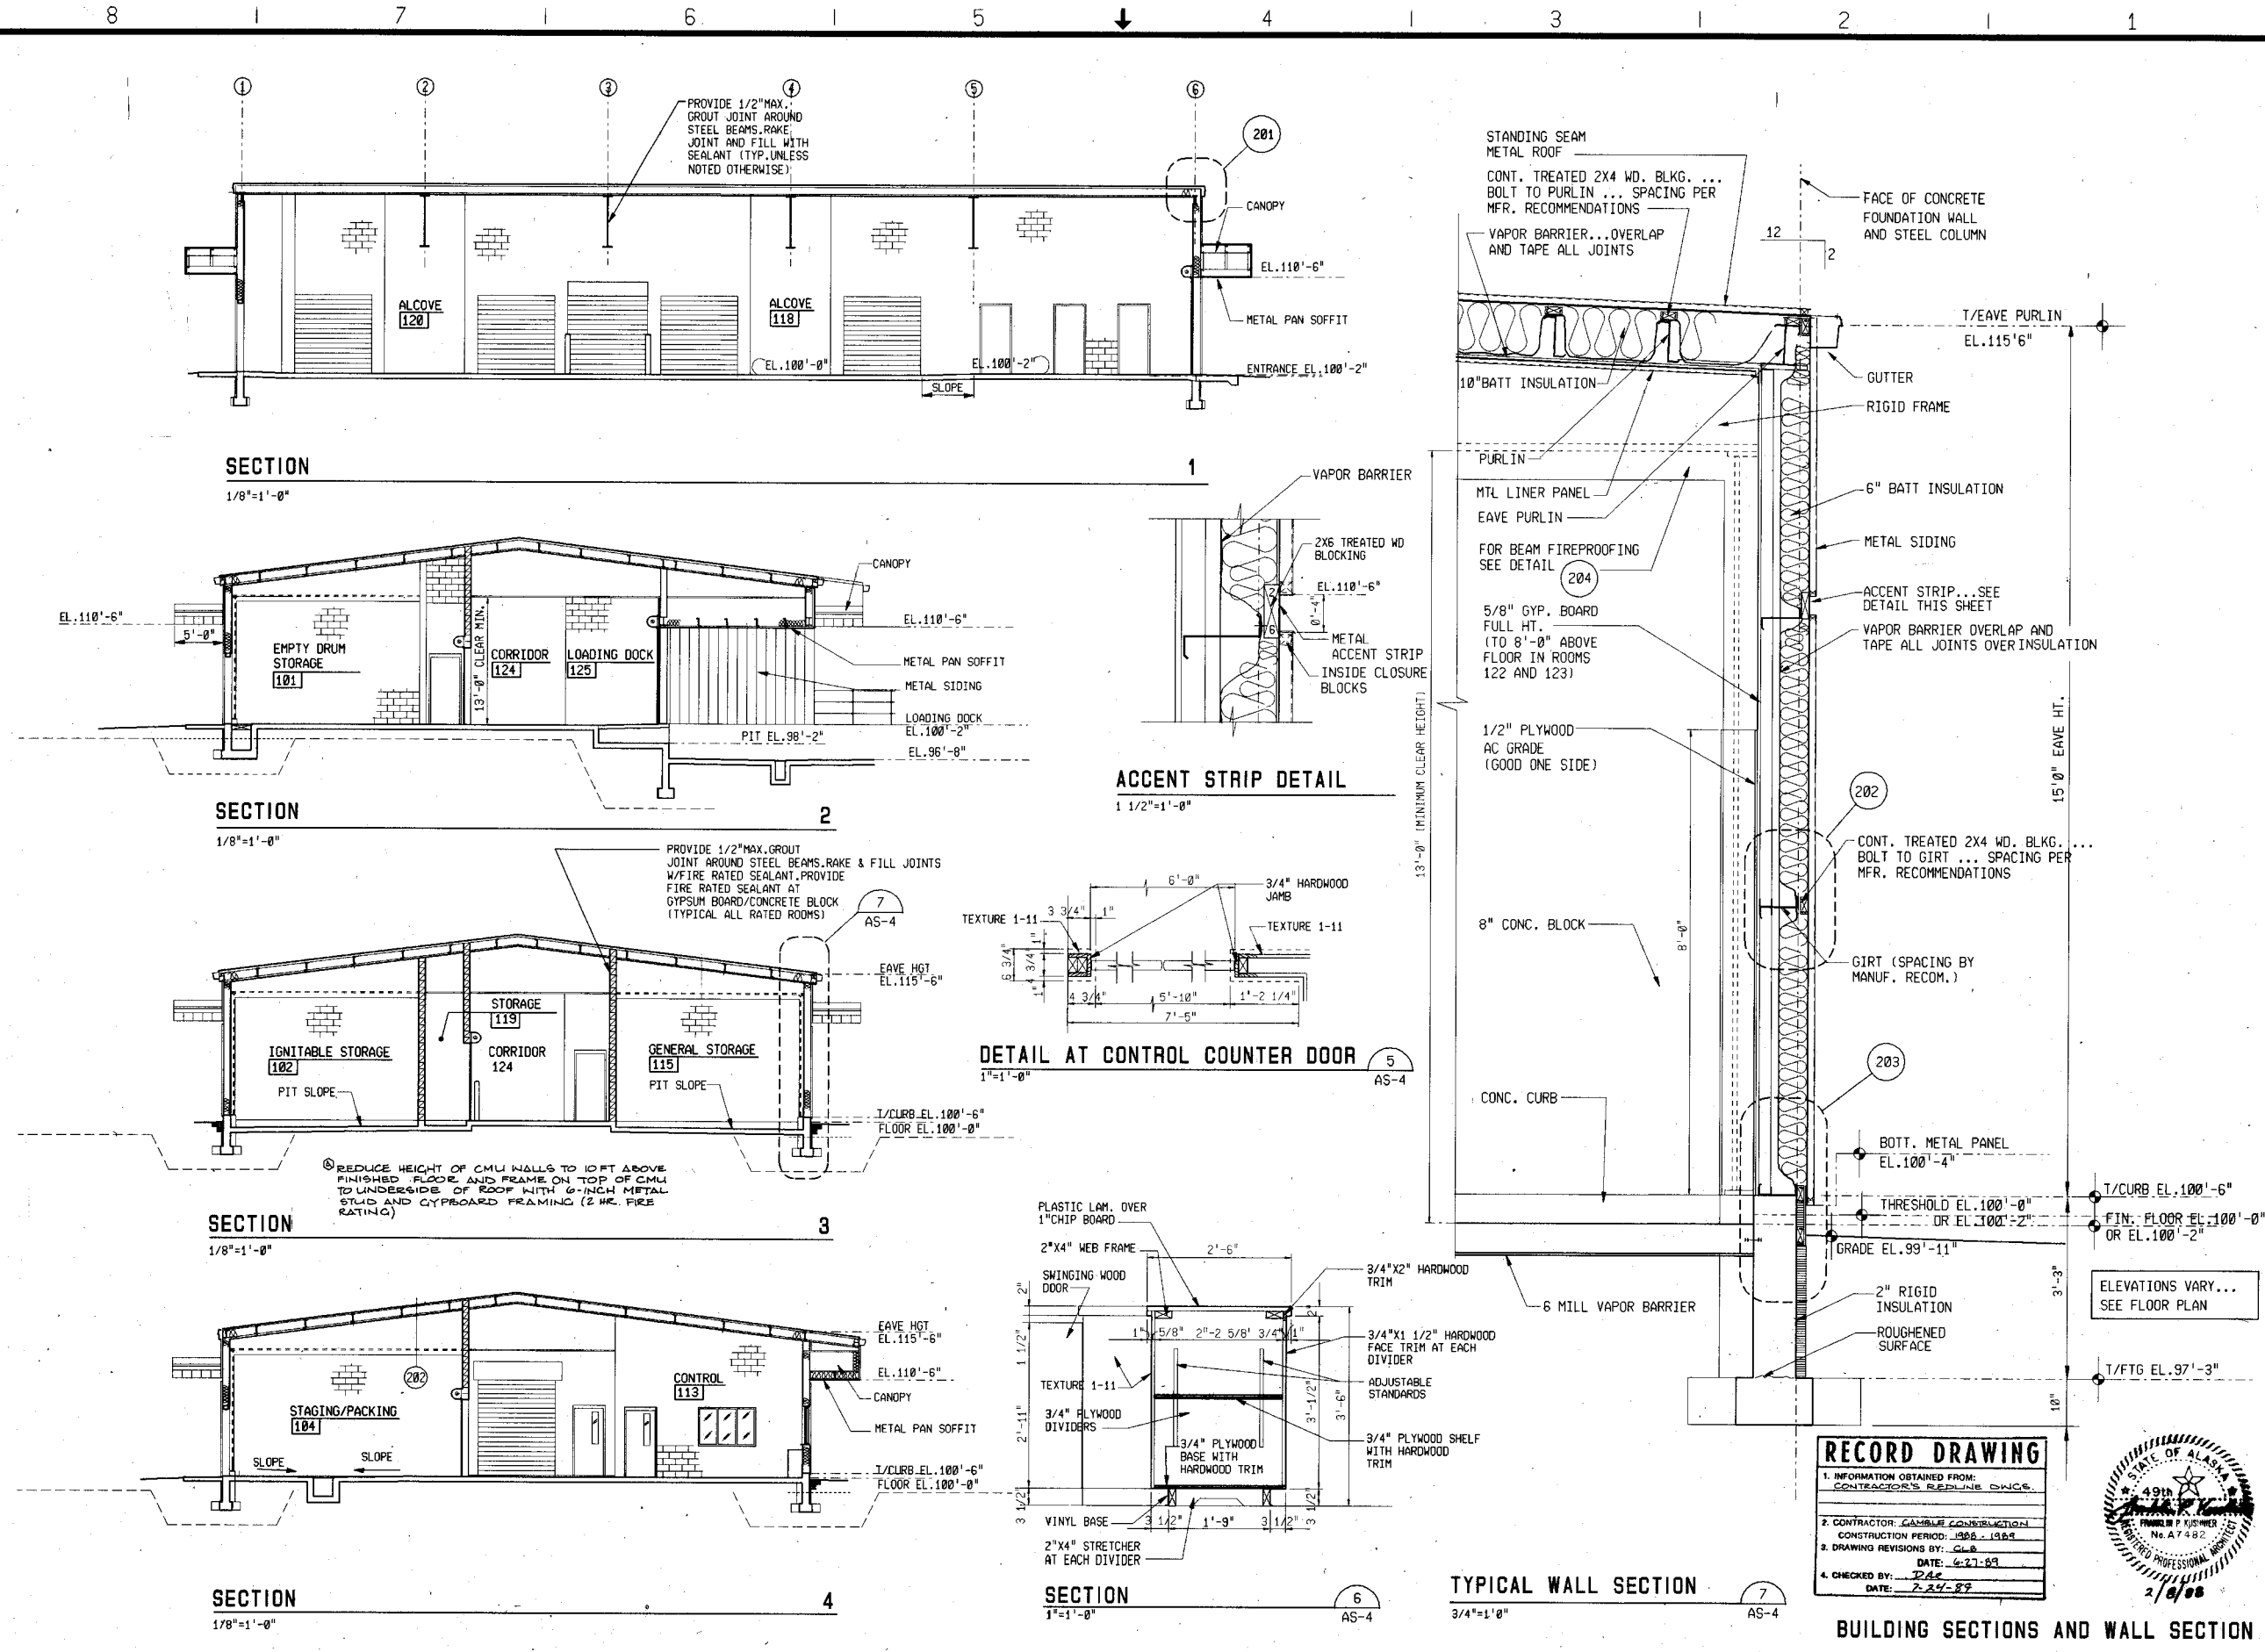

SECTION
1/8"=1'-0"

SECTION
1/8"=1'-0"

SECTION
1/8"=1'-0"

SECTION
1/8"=1'-0"

ACCENT STRIP DETAIL
1 1/2"=1'-0"

DETAIL AT CONTROL COUNTER DOOR
1"=1'-0"

SECTION
1"=1'-0"

TYPICAL WALL SECTION
3/4"=1'-0"

RECORD DRAWING
1. INFORMATION OBTAINED FROM:
CONTRACTOR'S REDLINE DNCE.
2. CONTRACTOR: CAMBLE CONSTRUCTION
CONSTRUCTION PERIOD: 1988 - 1989
3. DRAWING REVISIONS BY: CLE
DATE: 6-27-89
4. CHECKED BY: DAE
DATE: 7-24-89




Scale	AS SHOWN	Date	2/5/88	Designer	EPK	Drafter	ARK	Checker	EPK	Approver	KEH	No.	Revisions	By	Date


Donohue
Engineers & Architects
COMPUTER AIDED DESIGN/DRAFTING
REGISTERED PROFESSIONAL ENGINEERS
STATE OF ALASKA
No. 7482

CONTRACT DRAWINGS
HAZARDOUS WASTE STORAGE FACILITY
ANCHORAGE REGIONAL LANDFILL SITE
ANCHORAGE, ALASKA


Sheet No. 13
File No. A-58872
Project No. 15286
AS-4
Drawing No.

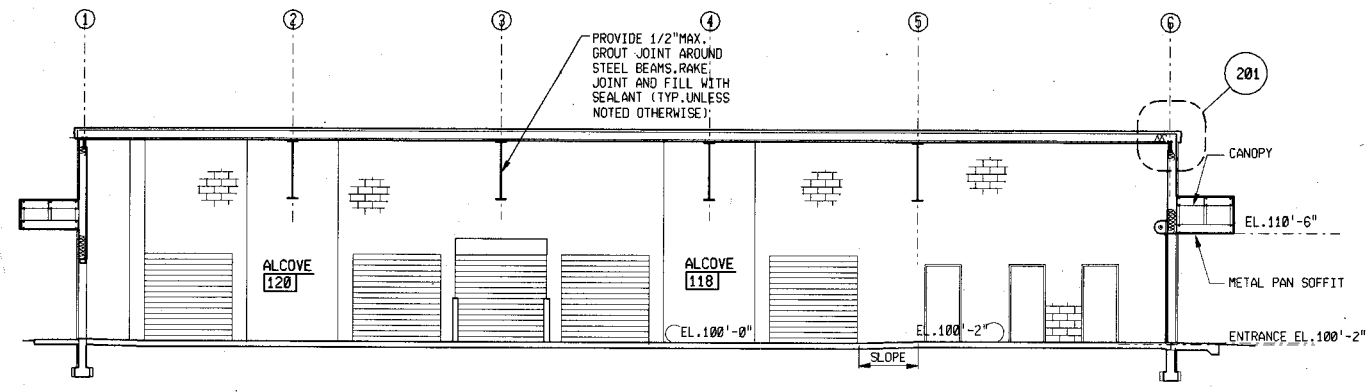


SECTION
1/8"=1'-0"

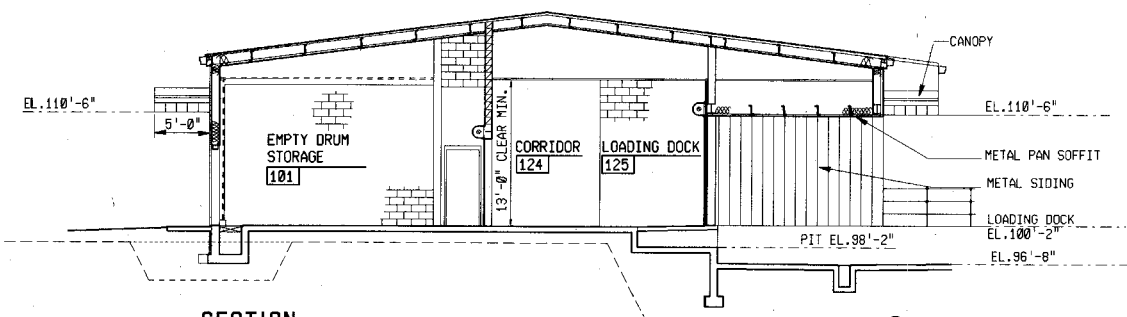


SECTION
1/8"=1'-0"

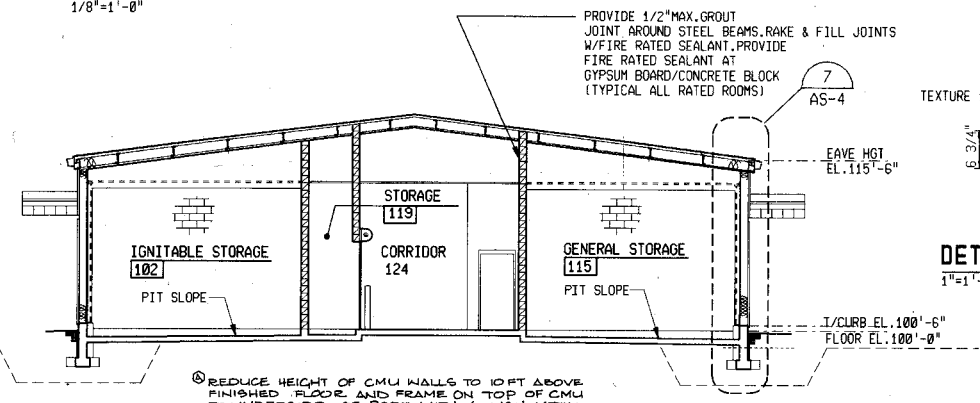


SECTION
1/8"=1'-0"

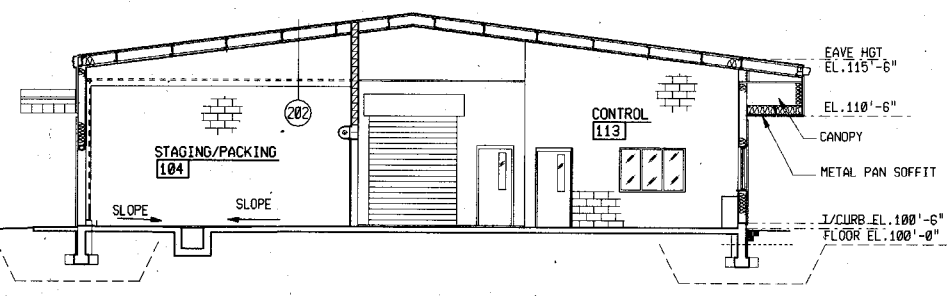


SECTION
1/8"=1'-0"

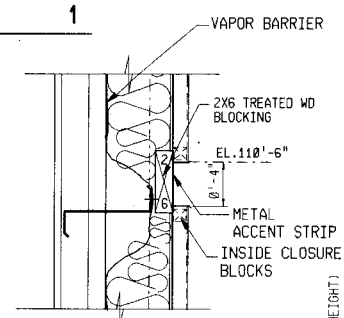


ACCENT STRIP DETAIL
1 1/2"=1'-0"

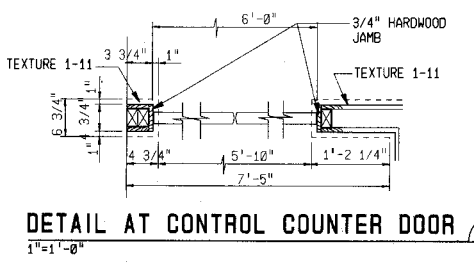

DETAIL AT CONTROL COUNTER DOOR
1"=1'-0"

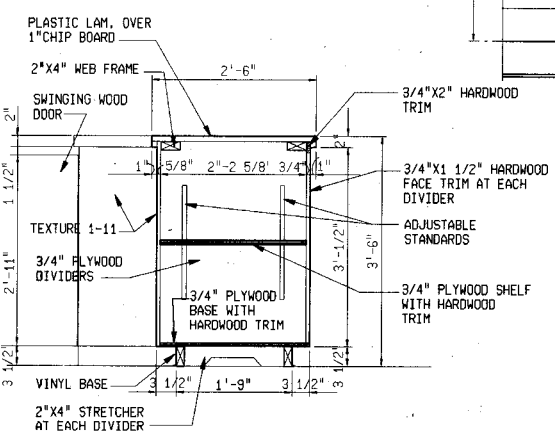

SECTION
1"=1'-0"

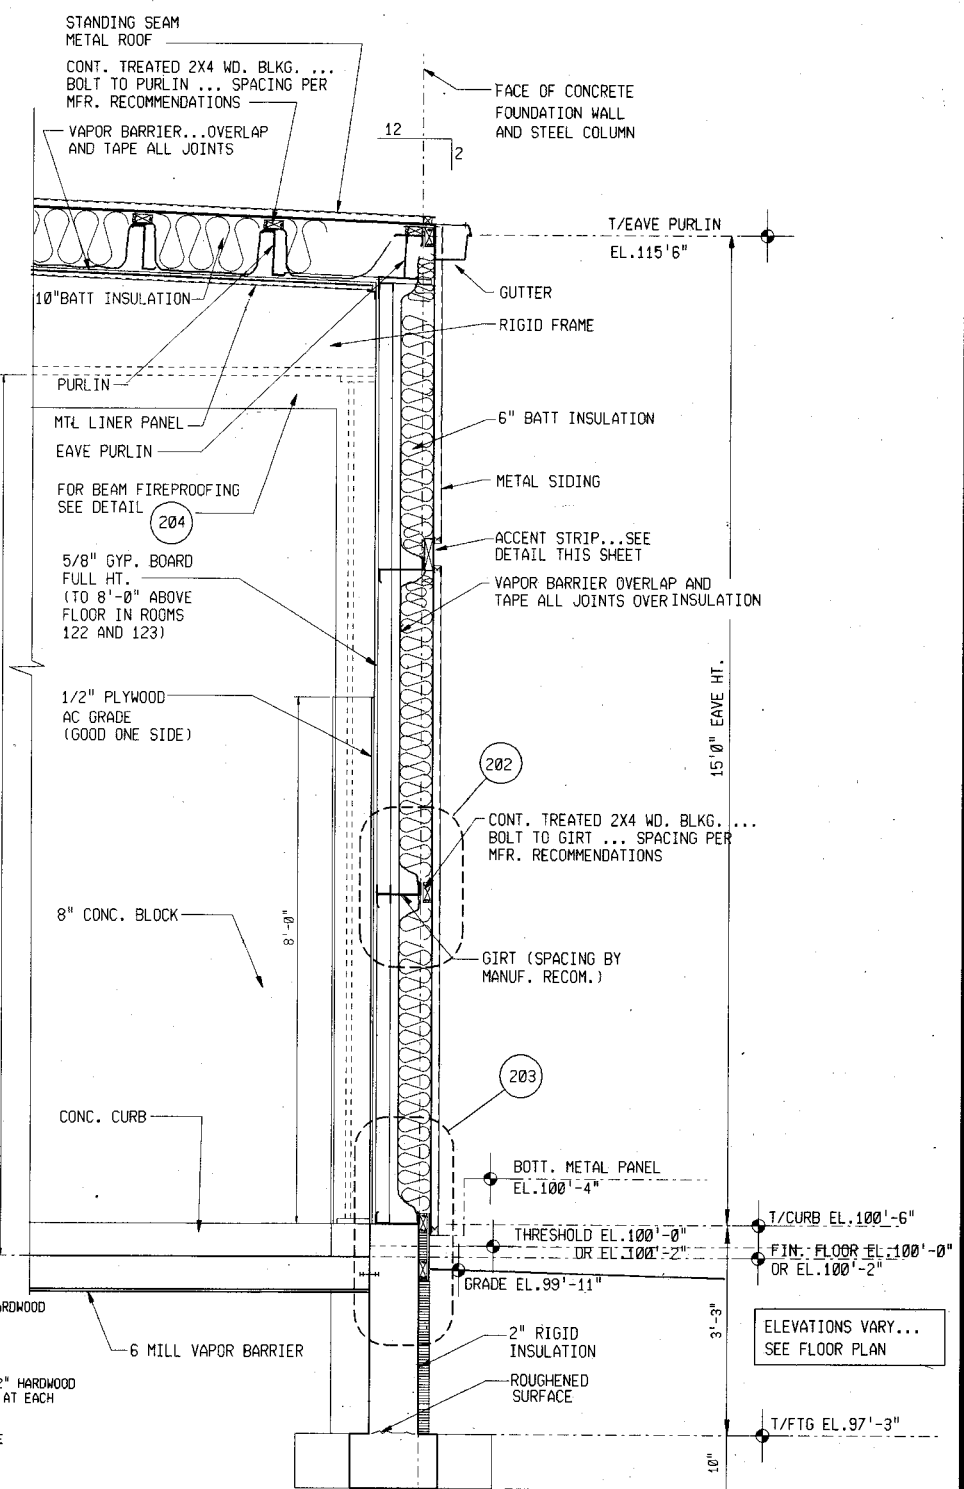

TYPICAL WALL SECTION
3/4"=1'-0"

RECORD DRAWING	
1. INFORMATION OBTAINED FROM:	CONTRACTOR'S REPLY DWGS.
2. CONTRACTOR:	GAMBLE CONSTRUCTION
3. DRAWING REVISIONS BY:	DATE
4. CHECKED BY:	DATE



BUILDING SECTIONS AND WALL SECTION


Scale	AS SHOWN
Date	2/5/88
Designer	FPK
Drafter	FPK
Checker	FPK
Approver	REF
No.	6
Revisions	By Date

Donohue
Engineers & Architects
COMPUTER AIDED DESIGN/DRAFTING
ANCHORAGE, ALASKA

CONTRACT DRAWINGS
HAZARDOUS WASTE STORAGE FACILITY
ANCHORAGE REGIONAL LANDFILL SITE
ANCHORAGE, ALASKA

Sheet No.	13
File No.	A-58872
Project No.	15286
AS-4	Drawing No.

221-19

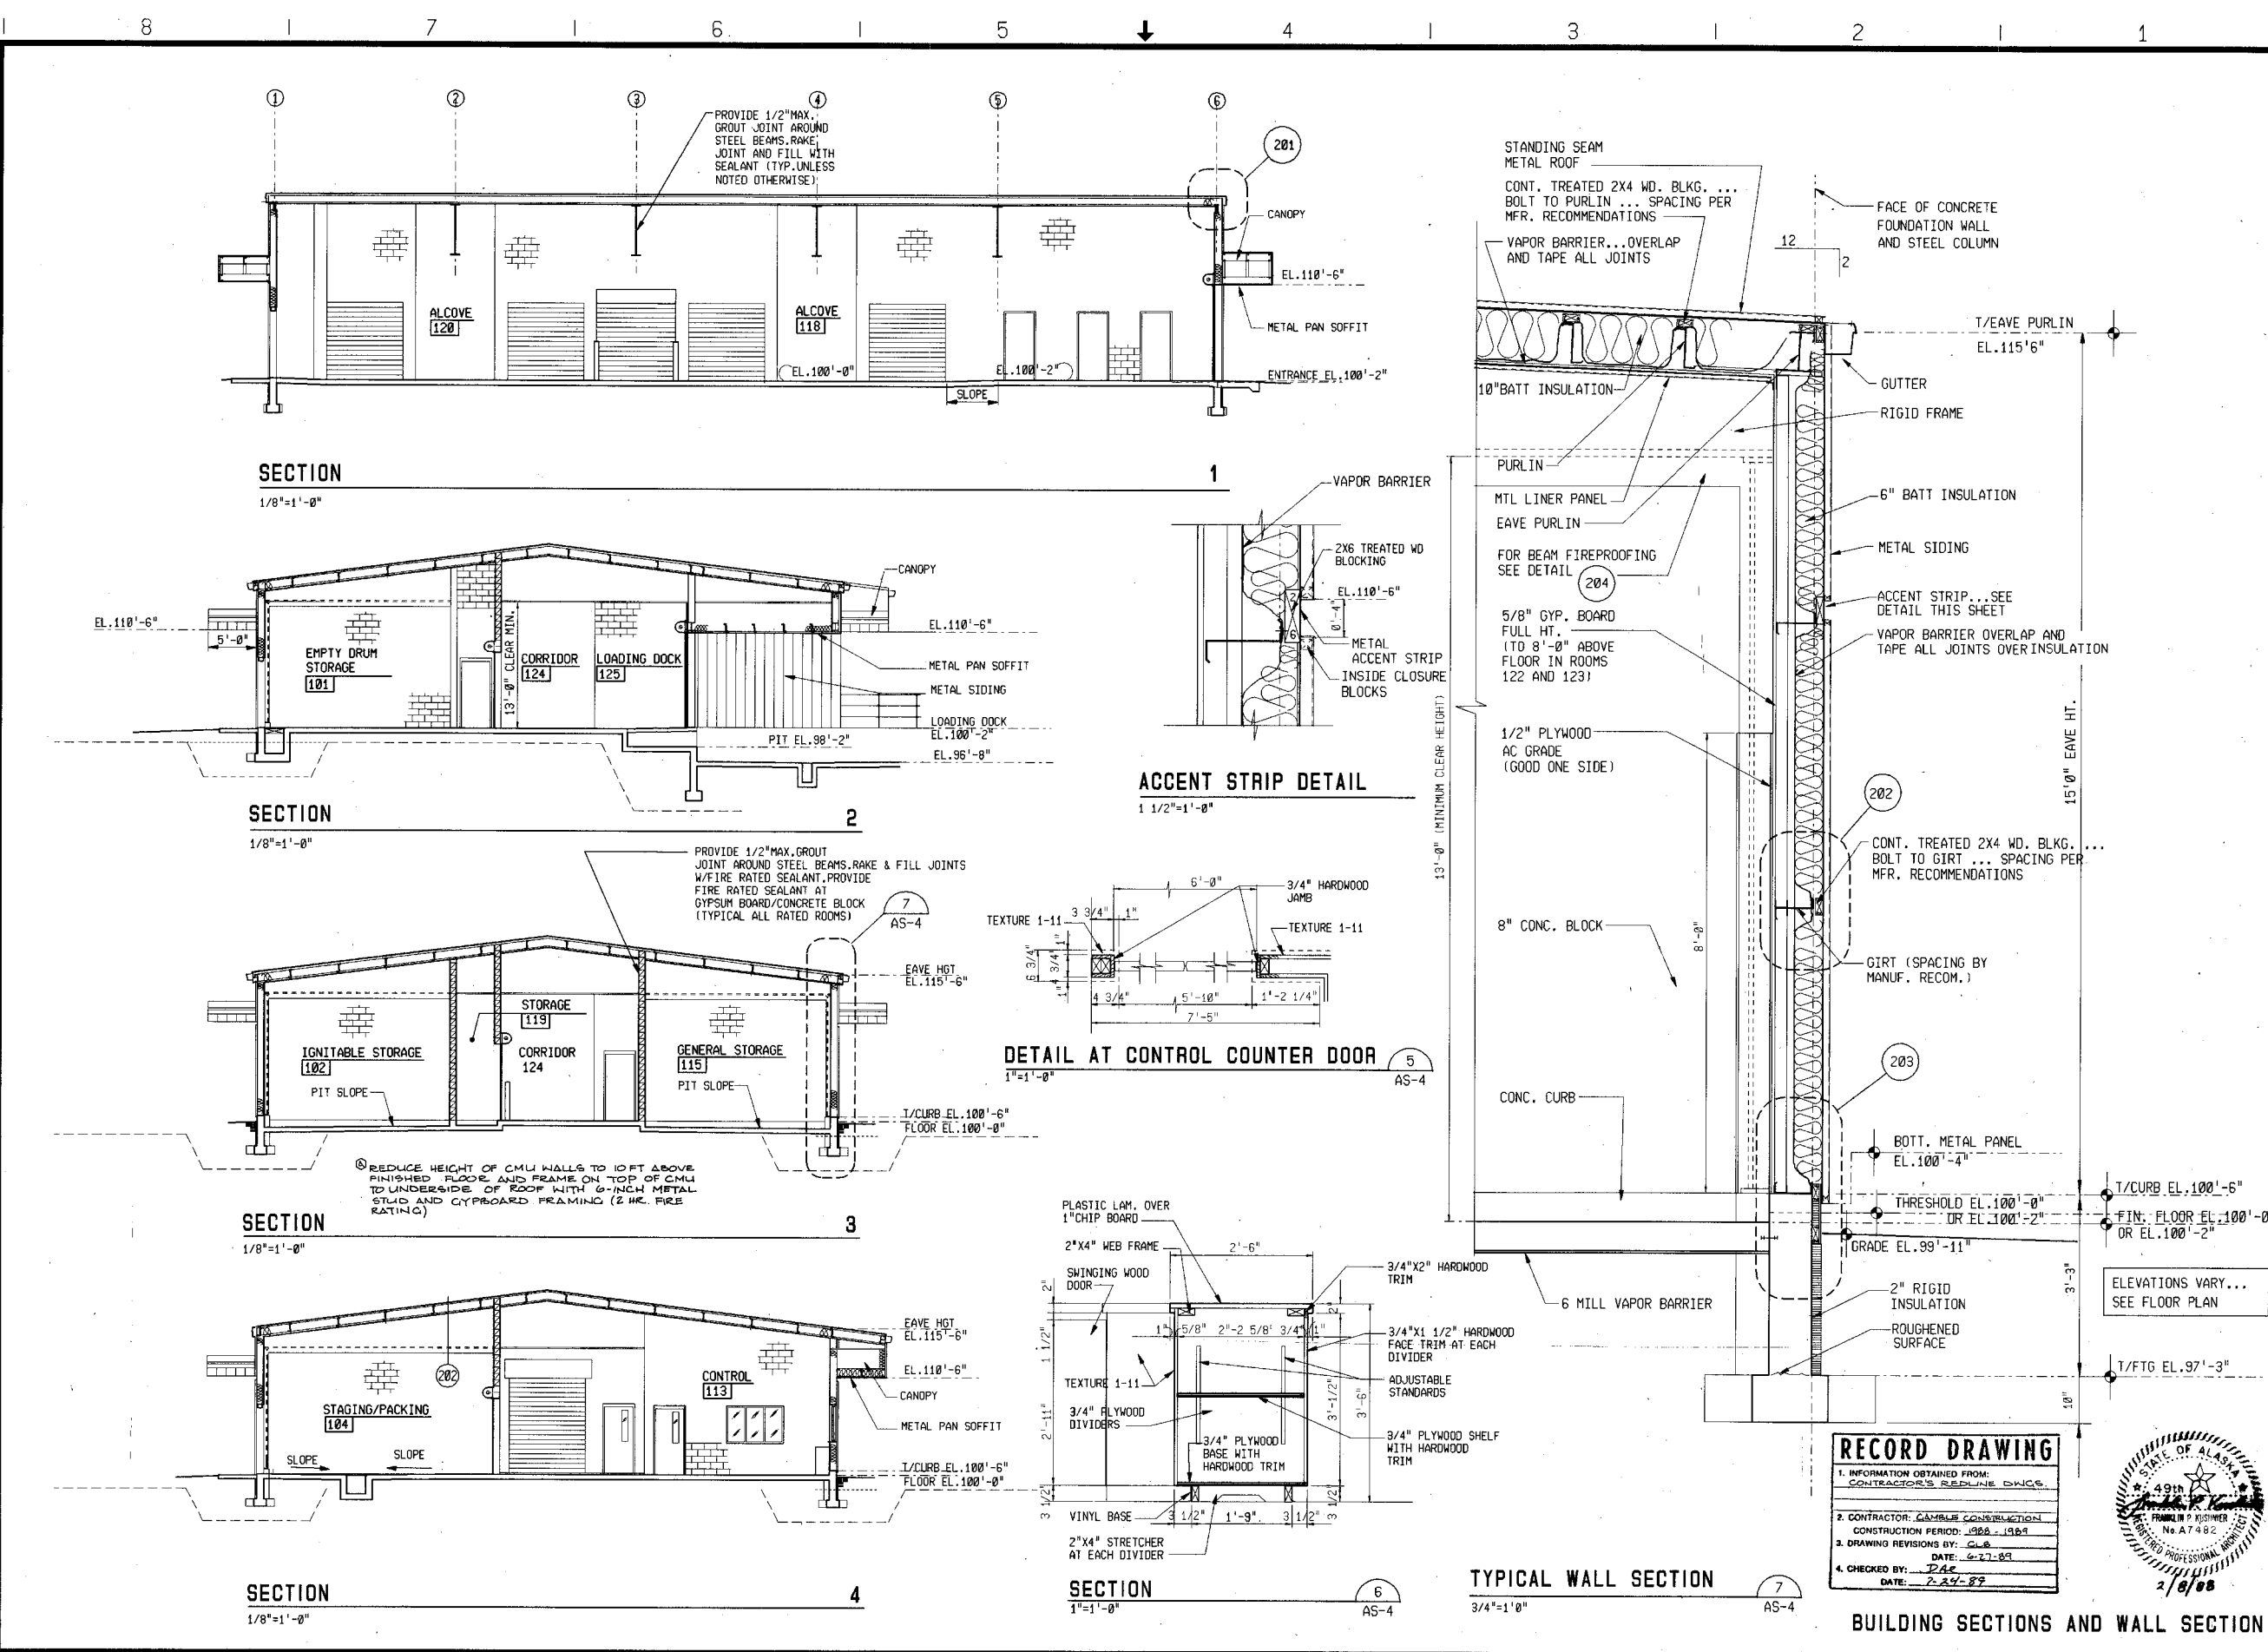

REFERENCE FILES
 01-05-11 BORDER REF (1/4"=1'-0")
 02-05-11

NO PLOT SCALE- PLOT NAME- (FULL SIZE)
 NO PLOT SCALE- PLOT NAME- (FULL SIZE)


Scale	AS SHOWN	AS SHOWN
Date	2/5/88	2/5/88
Designer	FKK	FKK
Drafter	AKK	AKK
Checker	FKK	FKK
Approver	KEH	KEH
No.	5	5
Revisions		
By		
Date		

Donohue
 Engineers & Architects
 COMPUTER AIDED DESIGN/DRAFTING
 ENGINEERS

CONTRACT DRAWINGS
HAZARDOUS WASTE STORAGE FACILITY
ANCHORAGE REGIONAL LANDFILL SITE
 ANCHORAGE, ALASKA

Sheet No.	13
File No.	A-58872
Project No.	15286
Drawing No.	AS-4

RECORD DRAWING
 1. INFORMATION OBTAINED FROM:
 CONTRACTOR'S REDLINE DWGS.
 2. CONTRACTOR: GAMBLE CONSTRUCTION
 CONSTRUCTION PERIOD: 1988-1989
 3. DRAWING REVISIONS BY: CLB
 DATE: 6-27-87
 4. CHECKED BY: JAA
 DATE: 2-25-88

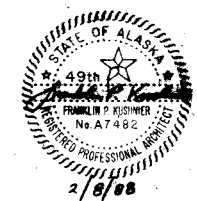

BUILDING SECTIONS AND WALL SECTION


81-122

DOOR SCHEDULE

DOOR NO.	DOOR				FRAME		DETAILS			HND GROUP / NAME PLATES	LABEL (DOOR & FRAME)	LINTEL
	SIZE W X H X THK.	TYPE	MATERIAL	GRILL W X H	TYPE	MATERIAL	HEAD	JAMB	SILL			
101	2'-3"-0"X7'-0"X1 3/4"	② D-1	GHM-I	-	F-1	GHM	217	217	217	1 / 1	-	①
102	3'-0"X7'-0"X1 3/4"	D-2	GHM-I	-	F-1	GHM	217	217	217	2 / -	-	①
103	3'-0"X7'-0"X1 3/4"	D-2	GHM-I	-	F-1	GHM	217	217	217	2 / -	-	①
104	3'-0"X7'-0"X1 3/4"	D-2	GHM-I	-	F-1	GHM	217	217	217	2 / -	-	①
105	3'-0"X7'-0"X1 3/4"	D-2	GHM-I	-	F-1	GHM	217	217	217	2 / -	-	①
106	2'-2'-10"X7'-0"X1 3/4"	D-2	GHM-I	-	F-1	GHM	217	217	217	1 / -	-	①
107	8'-0"X10'-0"X1 3/4"	⑤ D-3	STL-I	-	① STL	210	210	210	- / -	-	-	①
108	3'-0"X7'-0"X1 3/4"	② D-1	GHM-I	-	F-1	GHM	217	217	217	4 / 1	-	①
109	3'-0"X7'-0"X1 3/4"	② D-1	GHM-I	-	F-1	GHM	217	217	217	5 / 1	-	①
110	3'-0"X7'-0"X1 3/4"	② D-1	GHM-I	-	F-1	GHM	217	217	217	5 / 1	-	①
111	2'-3'-0"X7'-0"X1 3/4"	② D-1	GHM-I	-	F-1	GHM	217	217	217	6 / 1	-	①
112	3'-0"X7'-0"X1 3/4"	D-2	GHM-I	-	F-1	GHM	217	217	217	2 / -	-	①
113	3'-0"X7'-0"X1 3/4"	D-2	GHM-I	-	F-1	GHM	217	217	217	2 / -	-	①
114	8'-0"X10'-0"X1 3/4"	D-3	STL-I	-	① STL	210	210	210	- / -	-	-	①
115	3'-0"X7'-0"X1 3/4"	② D-1	GHM-I	-	F-1	GHM	217	217	217	4 / 1	-	①
116	8'-0"X8'-0"X3/4"	D-3	STL	-	-	STL	211	211	211	- / -	B	L-2 ③
117	8'-0"X8'-0"X3/4"	D-3	STL	-	-	STL	211	211	211	- / -	B	L-2 ③
118	8'-0"X8'-0"X3/4"	D-3	STL	-	-	STL	211	211	211	- / -	B	L-2 ③
119	3'-0"X7'-0"X1 3/4"	D-2	GHM	-	F-1	GHM	213	213	213	7 / -	B	L-1 ③
120	3'-0"X7'-0"X1 3/4"	D-2	GHM	-	F-1	GHM	213	213	213	7 / -	B	L-1 ③
121	8'-0"X8'-0"X3/4"	D-3	STL	-	-	STL	211	211	211	- / -	B	L-2 ③
122	8'-4"X8'-0"X3/4"	D-3	STL	-	-	STL	211	211	211	- / -	B	L-2 ③
123	8'-0"X8'-0"X3/4"	D-3	STL	-	-	STL	211	211	211	- / -	B	L-2 ③
124	3'-0"X7'-0"X1 3/4"	D-2	GHM	-	F-1	GHM	213	213	213	7 / -	B	L-1 ③
125	3'-0"X7'-0"X1 3/4"	D-2	GHM	-	F-1	GHM	213	213	213	7 / -	B	L-1 ③
126	8'-0"X8'-0"X3/4"	D-3	STL	-	-	STL	211	211	211	- / -	B	L-2 ③
127	3'-0"X7'-0"X1 3/4"	D-2	GHM	12"X12"	F-2	GHM	213	213	213	8 / 2	-	L-1 ③
128	2'-8"X7'-0"X1 3/4"	D-2	GHM	-	F-2	GHM	213	213	213	9 / 3	-	L-1 ③
129	2'-8"X7'-0"X1 3/4"	D-2	GHM	12"X12"	F-2	GHM	213	213	213	8 / 4	-	L-3 ③
130	2'-8"X7'-0"X1 3/4"	D-2	GHM	-	F-2	GHM	213	213	213	8 / 4	-	L-3 ③
131	3'-0"X7'-0"X1 3/4"	D-2	GHM	12"X12"	F-2	GHM	213	213	213	8 / 5	-	L-1 ③
132	3'-0"X7'-0"X1 3/4"	④ D-1	GHM	-	F-2	GHM	213	213	213	10 / 6	-	L-1 ③
133	3'-0"X7'-0"X1 3/4"	④ D-1	GHM	-	F-1	GHM	213	213	213	10 / 7	-	L-1 ③
134	2'-3'-0"X2'-11"X1 3/8"	D-5	WOOD	-	-	WOOD	5/AS-4	5/AS-4	5/AS-4	11 / 8	-	-
135	8'-0"X8'-0"X3/4"	D-3	STL	-	-	STL	211	211	211	- / -	B	L-2 ③
136	3'-0"X7'-0"X1 3/4"	D-2	GHM	-	F-1	GHM	213	213	213	7 / -	B	L-1 ③
137	3'-0"X7'-0"X1 3/4"	D-2	GHM	-	F-1	GHM	213	213	213	7 / -	B	L-1 ③
138	8'-0"X8'-0"X3/4"	D-3	STL	-	-	STL	211	211	211	- / -	B	L-2 ③
139	3'-10"X8'-0"	D-4	STL	-	-	STL	-	-	-	- / -	-	L-1 ③

DOOR SCHEDULE NOTES

ABBREVIATIONS	FOOTNOTES	GENERAL NOTES	NAME PLATES
AL ALUMINUM GHM GALVANIZED HOLLOW METAL GHM-I GALVANIZED HOLLOW METAL-INSULATED HM HOLLOW METAL STL STEEL STL-I STEEL-INSULATED	① FRAMING BY PRE ENGINEERED BUILDING SUPPLIER ② 1" TEMPERED INSULATING GLASS ③ SEE STRUCTURAL LINTEL SCHEDULE ④ 1/4" TEMPERED GLASS ⑤ ELECTRIC OPERATED	1. NO SMOKING 2. LOCKER ROOM 3. TOILET 4. MUD ROOM 5. STORAGE 6. LAB 7. OFFICE 8. AUTHORIZED PERSONNEL ONLY	1. NO SMOKING 2. LOCKER ROOM 3. TOILET 4. MUD ROOM 5. STORAGE 6. LAB 7. OFFICE 8. AUTHORIZED PERSONNEL ONLY

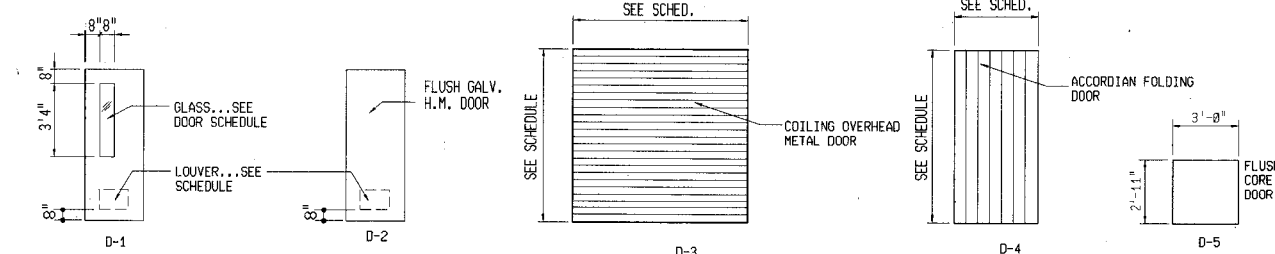

DOOR TYPES


ROOM FINISH SCHEDULE

ROOM NO.	ROOM NAME	FLOOR	BASE	WALLS	CEILING		ROOM ENVIRONMENT	DOOR, TRIM OR CASEWORK
					FINISH	HGT.		
101	EMPTY DRUM STORAGE	A	B	B	E	VARIES	NORMAL	F
102	IGNITABLE STORAGE	A	B	B	E	VARIES	NORMAL	F
103	IGNITABLE STORAGE	A	B	B	E	VARIES	NORMAL	F
104	STAGING / PACKING	A	B	B	E	VARIES	NORMAL	F
105	MECHANICAL ROOM	A	B	B	E	VARIES	NORMAL	F
106	SHOWER	A	B	B	E	8'-0"	MOIST	F
107	LOCKER ROOM	A	B	B	E	8'-0"	MOIST	F
108	MUD ROOM	A	B	B	E	8'-0"	MOIST	F
109	STORAGE ROOM	A	B	B	E	8'-0"	NORMAL	F
110	TOILET ROOM	A	B	B	E	8'-0"	NORMAL	F
111	LAB	A	B	B	E	9'-0"	NORMAL	F
112	OFFICE STORAGE/BREAK ROOM	A	B	B	E	8'-0"	NORMAL	F
113	CONTROL	A	B	B	E	VARIES	NORMAL	F
114	CORROSIVES TALKAL / ACIDS STORAGE	A	B	B	E	VARIES	NORMAL	F
115	GENERAL STORAGE	A	B	B	E	VARIES	NORMAL	F
116	STORAGE	A	B	B	E	VARIES	NORMAL	F
117	ALCOVE	A	B	B	E	VARIES	NORMAL	F
118	ALCOVE	A	B	B	E	VARIES	NORMAL	F
119	STORAGE	A	B	B	E	VARIES	NORMAL	F
120	ALCOVE	A	B	B	E	VARIES	NORMAL	F
121	EYE WASH / SHOWER	A	B	B	E	VARIES	MOIST	F
122	REACTANTS	A	B	B	E	VARIES	NORMAL	F
123	OXIDIZERS	A	B	B	E	VARIES	NORMAL	F
124	CORRIDOR	A	B	B	E	VARIES	NORMAL	F
125	LOADING DOCK	A	B	B	E	VARIES	NORMAL	F

SYMBOLS	GENERAL NOTES	SUBSTRATE	MATERIAL OR FINISH
LETTER IN UPPER CORNER DENOTES SUBSTRATE NUMBER IN LOWER CORNER DENOTES MATERIAL OR FINISH NUMBER IN CIRCLE DENOTES FOOTNOTE	1. ALL DEPRESSION AREAS IN STORAGE ROOMS REQUIRE A COATING FOOTNOTES ① FOR USE WITH PAINT AND COATING SCHEDULE IN SPECIFICATIONS OMIT GYP. BOARD ON WALLS ABOVE 8'-0"	A- CONCRETE B- CONCRETE BLOCK C- GYPSUM BOARD ON METAL STUDS D- PLYWOOD 8" HIGH OVER GYP. BD. E- METAL LINER PANEL (PREFINISHED) F- HOLLOW METAL G- STL. DOORS, GUARDS, DUCTWORK	1. COATING 2. SEALER 3. CERAMIC TILE 4. SUSPENDED VINYL-COATED GYP. BOARD, LAY-IN CEILING 5. SUSPENDED ACOUSTIC TILE, LAY-IN CEILING 6. VINYL 7. EPOXY COATING

RECORD DRAWING

1. INFORMATION OBTAINED FROM: CONTRACTOR'S REDLINE DWG.
2. CONTRACTOR: GAMBLE CONSTRUCTION CONSTRUCTION PERIOD: 1988 - 1989
3. DRAWING REVISIONS BY: G.L.B. DATE: 6-27-89
4. CHECKED BY: [Signature] DATE: 7-24-89

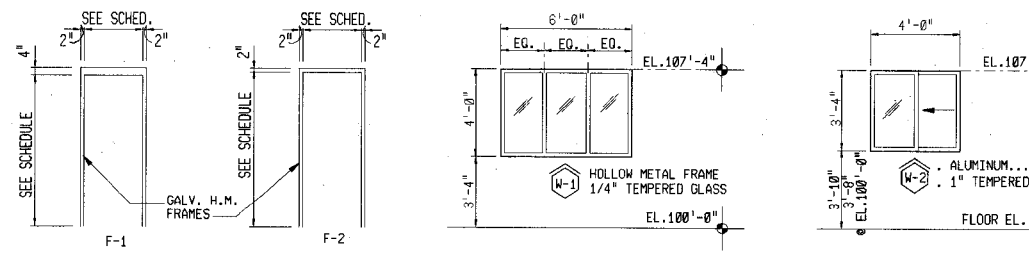

FRAME TYPES

WINDOW TYPES

DOOR AND ROOM FINISH SCHEDULES

Scale	Date	Designer	Checker	Approver	No.	Revisions	By	Date
AS SHOWN	2/5/88	FPK	FPK	KEH				

Donohue
 Engineers & Architects
 COMPUTER AIDED DESIGN/DRAFTING
 1001 ENGINEERS


CONTRACT DRAWINGS
HAZARDOUS WASTE STORAGE FACILITY
ANCHORAGE REGIONAL LANDFILL SITE
 ANCHORAGE, ALASKA

Sheet No.	14
File No.	A-50871
Project No.	15286


AS-5
 Drawing No.

221-17


8 | 7 | 6 | 5 | 4 | 3 | 2 | 1

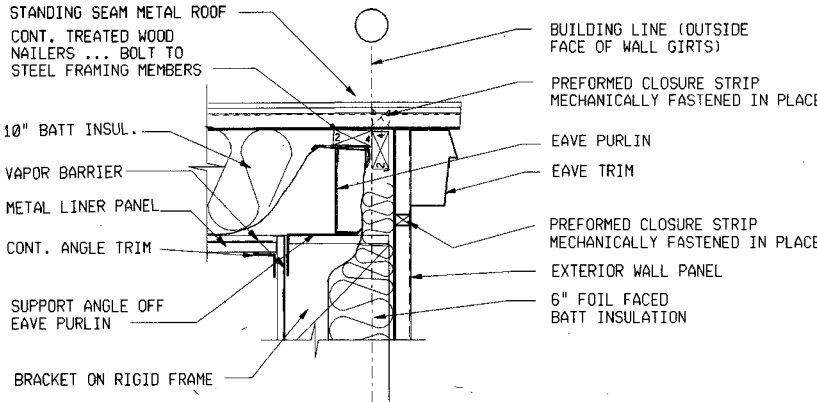


EAVE DETAIL
1 1/2" = 1'-0" (201)

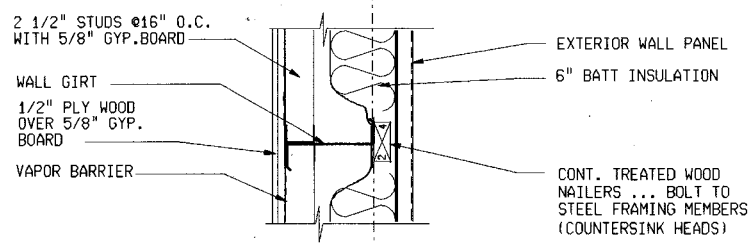


GIRT DETAIL
1 1/2" = 1'-0" (202)

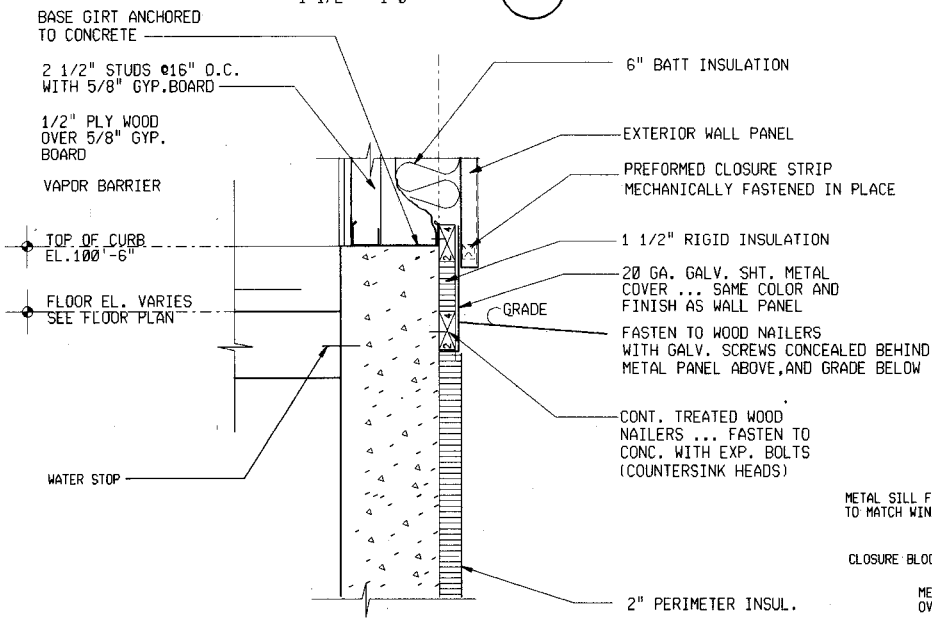


SILL DETAIL
1 1/2" = 1'-0" (203)

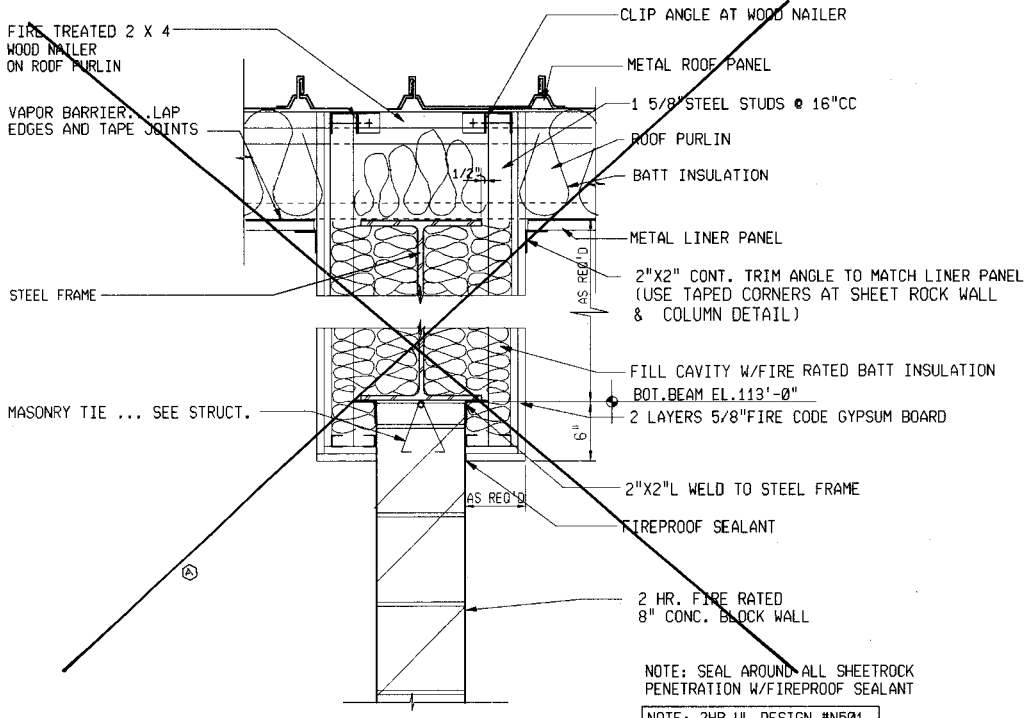


FIRE RATED CONNECTION OF ROOF TO RIGID FRAME
1 1/2" = 1'-0" SEE REVISED DET. 204 ON SHT AS-10 (204)

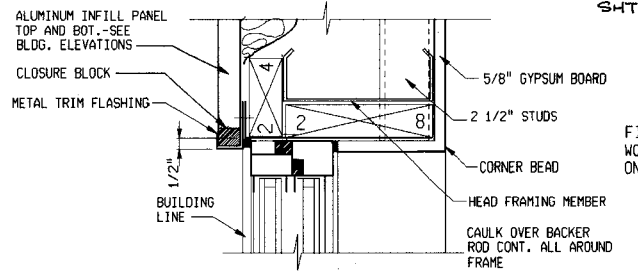

HEAD

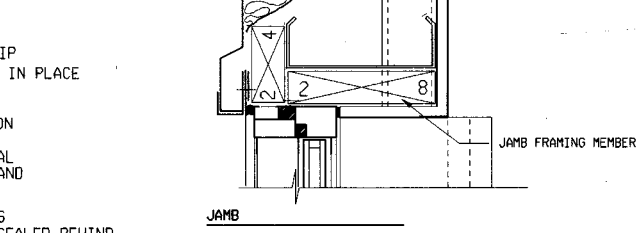


JAMB



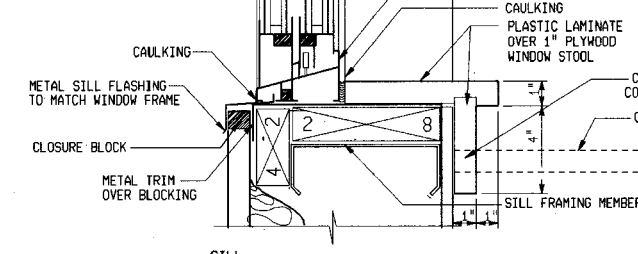


SILL

EXTERIOR WINDOW DETAIL
3" = 1'-0" (206)

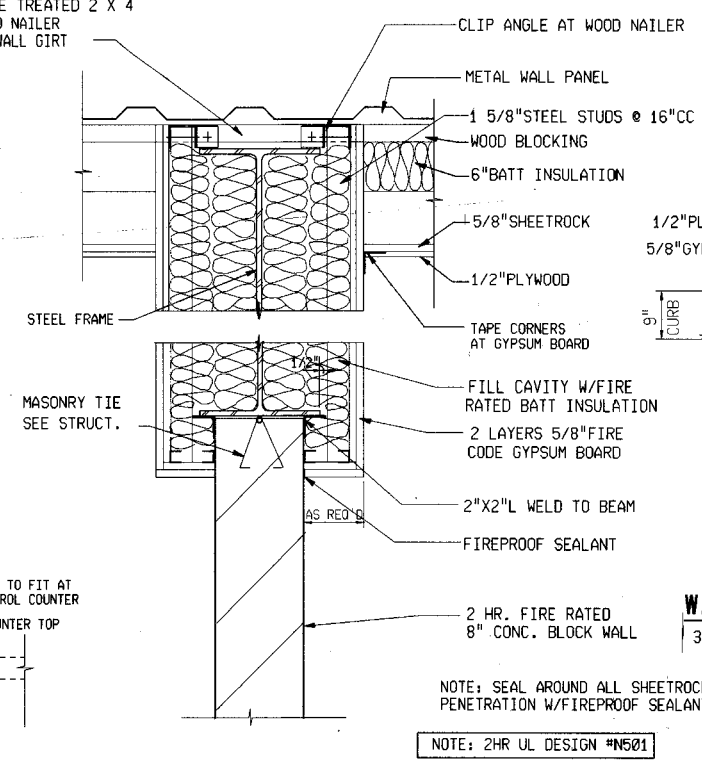


DETAIL AT COLUMN/WALL
1 1/2" = 1'-0" (207)

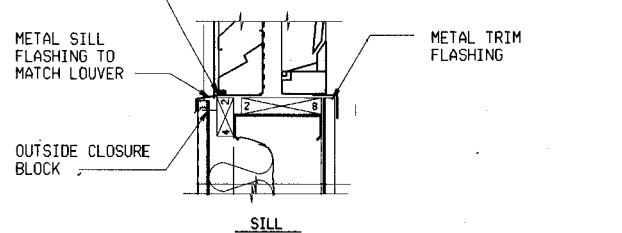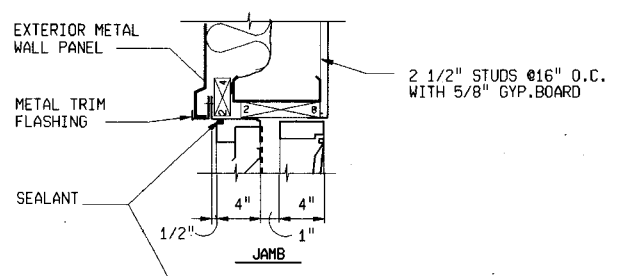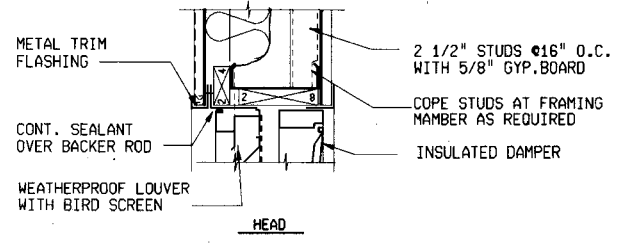


LOUVER DETAIL
1 1/2" = 1'-0" (205)

RECORD DRAWING	
1. INFORMATION OBTAINED FROM:	CONTRACTOR'S RECORDING BOOKS
2. CONTRACTOR:	GAMBLE CONSTRUCTION
CONSTRUCTION PERIOD:	1986 - 1987
3. DRAWING REVISIONS BY:	CLB
DATE:	6-21-87
4. CHECKED BY:	STC
DATE:	7-24-87

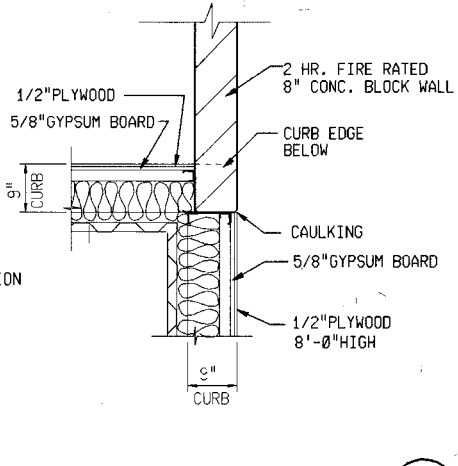

WALL INTERSECTION DETAIL
3/4" = 1'-0" (208)

NOTE: SEAL AROUND ALL SHEETROCK PENETRATION W/FIREPROOF SEALANT
NOTE: 2HR UL DESIGN #N501

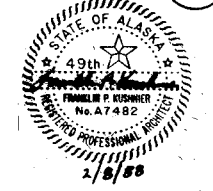

Scale	Date	Designer	Drafter	Checker	Approver	No.	Revisions	By	Date
AS SHOWN	2/5/88	FKK	FKK	FKK	FKK				


Donohue
Engineers & Architects
COMPUTER AIDED DESIGN/DRAFTING
REGISTERED PROFESSIONAL ENGINEERS
ENGINEERS

CONTRACT DRAWINGS
HAZARDOUS WASTE STORAGE FACILITY
ANCHORAGE REGIONAL LANDFILL SITE
ANCHORAGE, ALASKA


Sheet No. 15
File No. A-50870
Project No. 15286

AS-6
Drawing No.


221-16

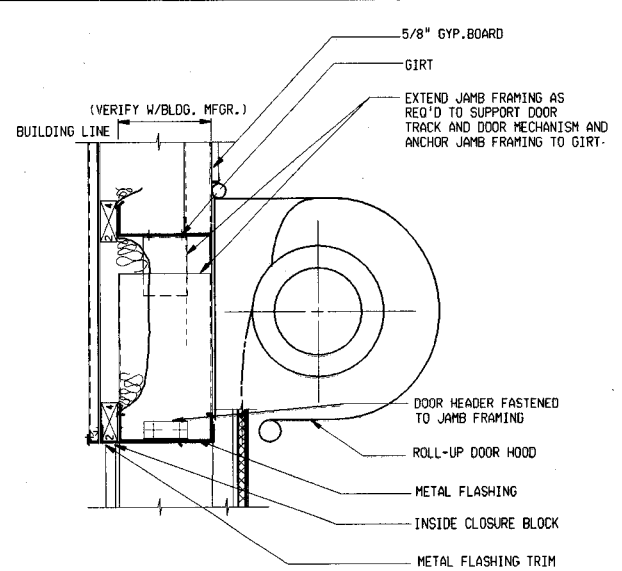

HEAD DETAIL

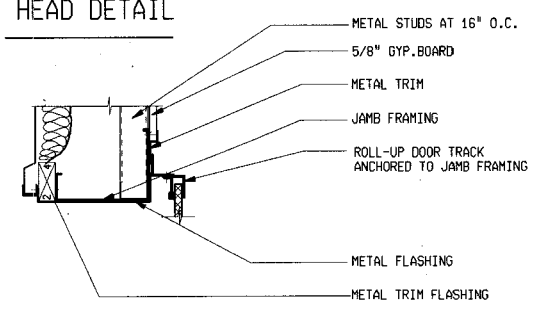


JAMB DETAIL

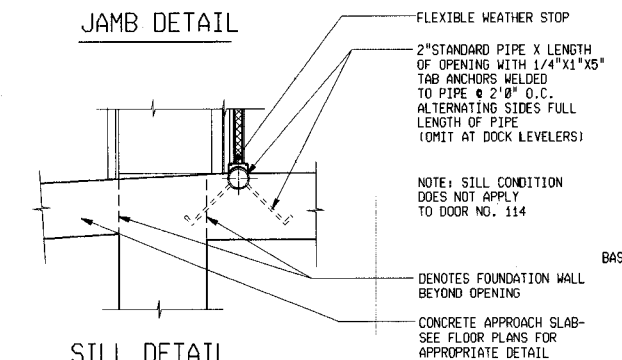


SILL DETAIL


TYP EXTERIOR COILING OVERHEAD DOOR DETAIL
1 1/2"=1'0"

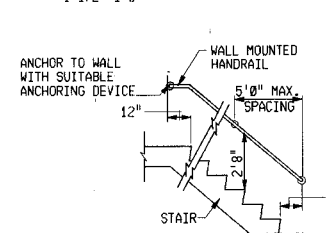

WALL MOUNTED HANDRAIL ELEVATION
1/4"=1'0"


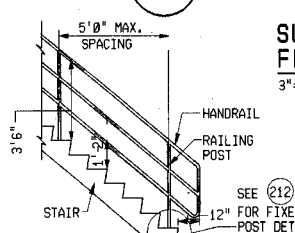


OPEN SIDE OF STAIR RAILING ELEVATION
1/4"=1'0"

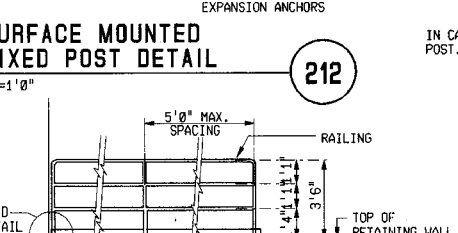


HORIZONTAL RAILING ELEVATION
1/4"=1'0"


RAILING DETAILS

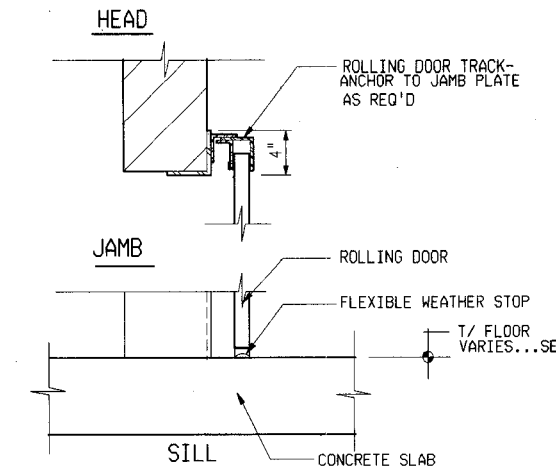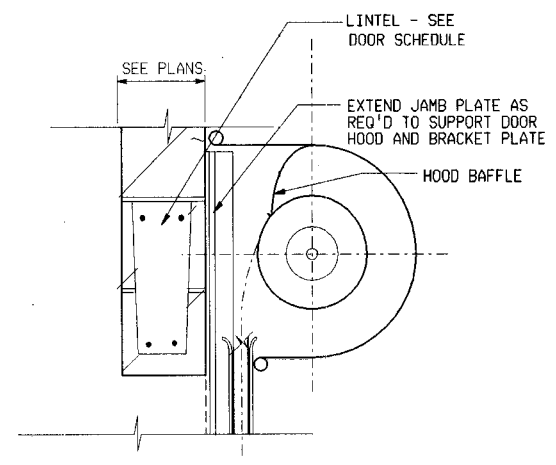


TYP INTERIOR COILING OVERHEAD DOOR DETAIL
1 1/2"=1'0"

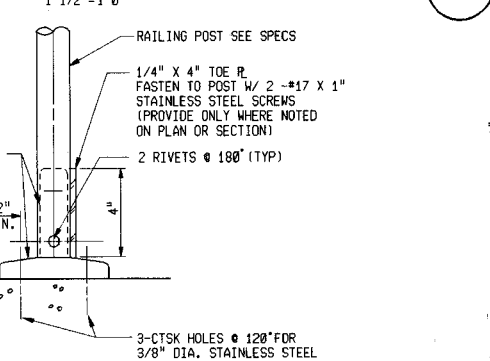


SURFACE MOUNTED FIXED POST DETAIL
3"=1'0"

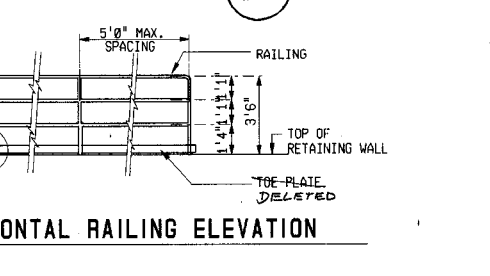


GUARD POST DETAIL
3/4"=1'0"

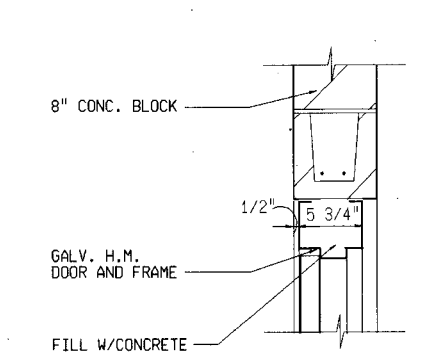


TYP INTERIOR H.M. DOOR DETAIL
1 1/2"=1'0"

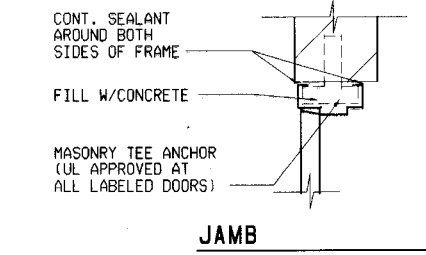


TYP INTERIOR H.M. DOOR DETAIL
1 1/2"=1'0"

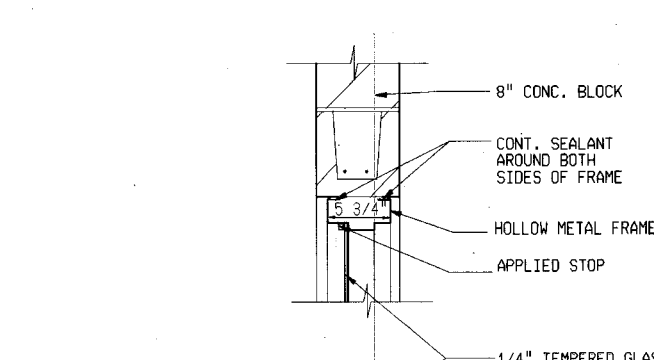


TYP INTERIOR WINDOW DETAIL
1 1/2"=1'0"

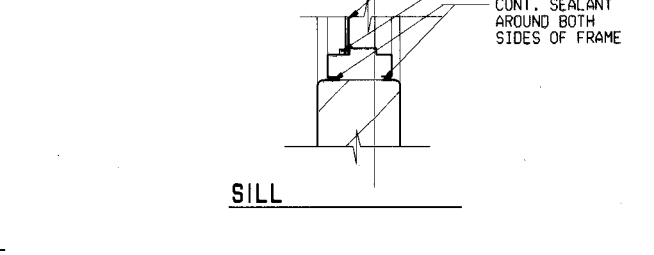


TYP INTERIOR WINDOW DETAIL
1 1/2"=1'0"

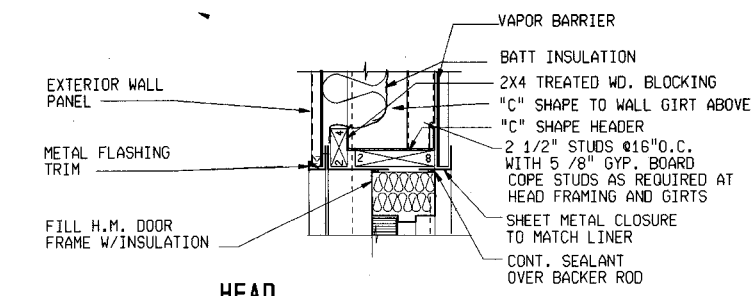

TYP EXTERIOR H.M. DOOR DETAIL
1 1/2"=1'0"

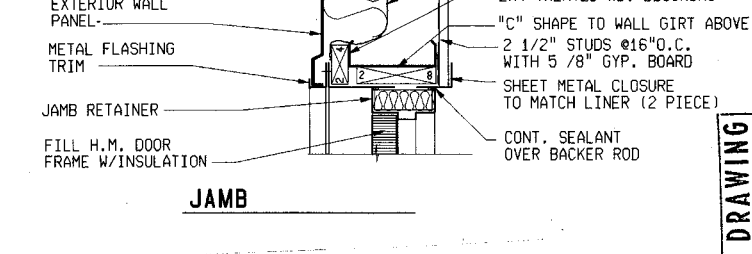

TYP EXTERIOR H.M. DOOR DETAIL
1 1/2"=1'0"

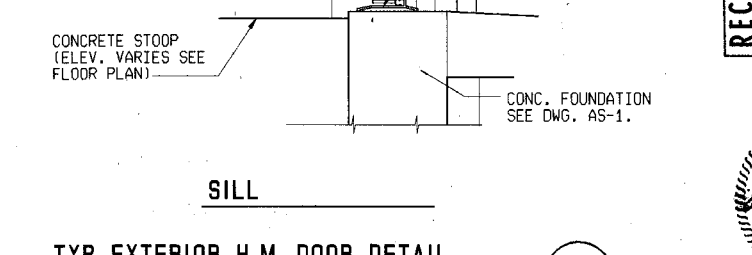

TYP EXTERIOR H.M. DOOR DETAIL
1 1/2"=1'0"

RECORD DRAWING
 1. INFORMATION OBTAINED FROM:
 - CONTRACT DOCUMENTS, SPECIFICATIONS, PERMITS,
 - AND REVISIONS, NOTED.
 2. CONSTRUCTION, CASUALTY, CONSTRUCTION
 CONSTRUCTION PERIOD: 1982-1983
 3. DRAWING REVISIONS BY: GJK
 DATE: 4-12-83
 4. CHECKED BY: JAC
 DATE: 7-22-83




Scale	AS SHOWN	By	KEH
Date	2/5/88	Revisions	
Designer	FKK	No.	
Drafter	AKK		
Checker	FKK		
Approver	KEH		

Donohue
 Engineers & Architects
 COMPUTER AIDED DESIGN/DRAFTING
 ENGINEERS


CONTRACT DRAWINGS
HAZARDOUS WASTE STORAGE FACILITY
ANCHORAGE REGIONAL LANDFILL SITE
 ANCHORAGE, ALASKA

Sheet No.	16
File No.	A-50869
Project No.	15286
Drawing No.	AS-7


221-15

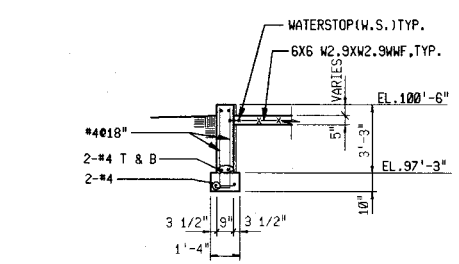


SECTION 1
1/4"=1'-0" AS-1

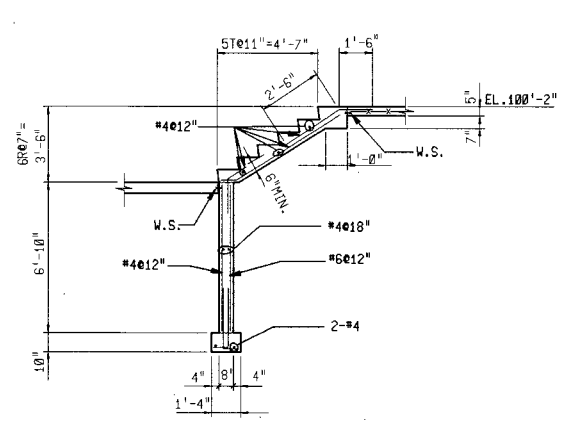

SECTION 5
1/4"=1'-0" AS-1

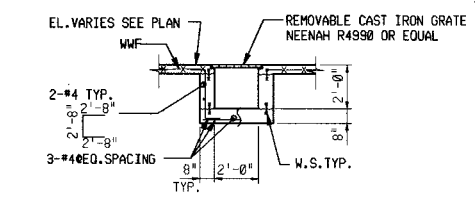


SECTION 2
1/4"=1'-0" AS-1

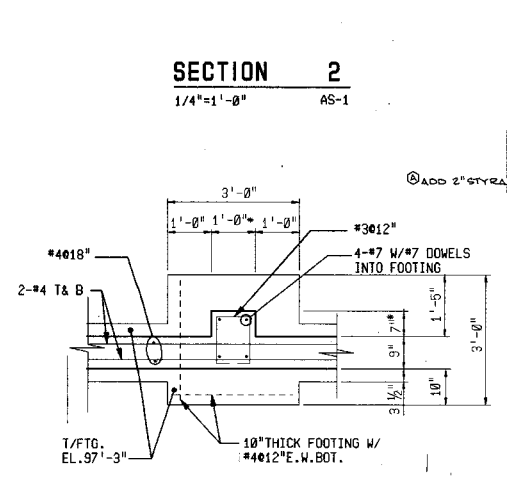


SECTION 6
1/4"=1'-0" AS-1

DETAIL 3
1/2"=1'-0" AS-1

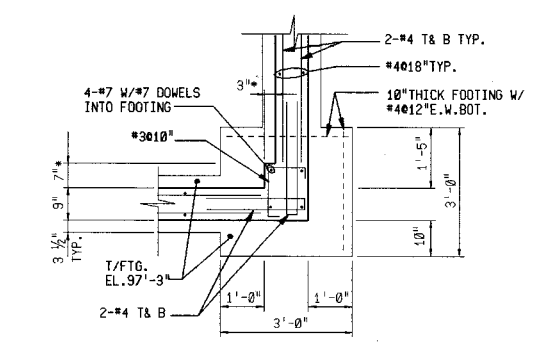


DETAIL 4
1/2"=1'-0" AS-1

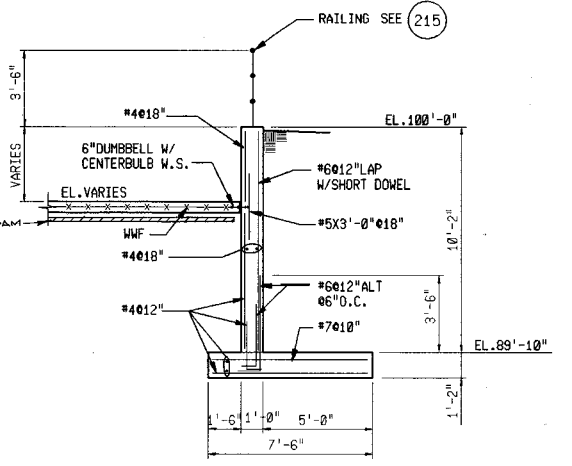


SECTION 9
1/4"=1'-0" AS-1

SECTION 6
1/4"=1'-0" AS-1


DETAIL 7
1/2"=1'-0" AS-1

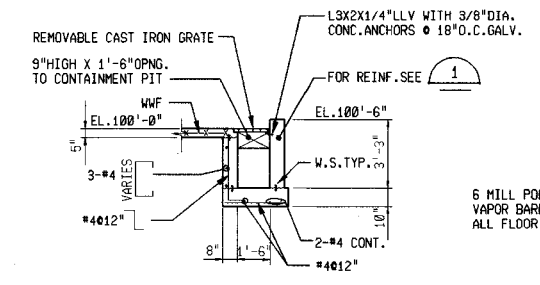


SECTION 8
1/4"=1'-0" AS-1

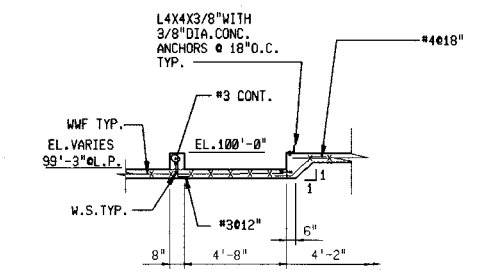


SECTION 9
1/4"=1'-0" AS-1

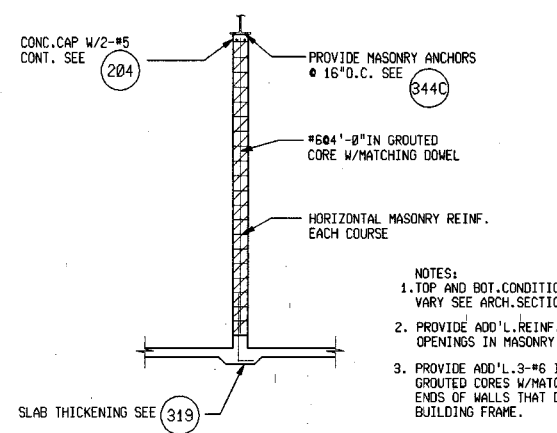


TYPICAL MASONRY REINFORCING 10
1/4"=1'-0" AS-1

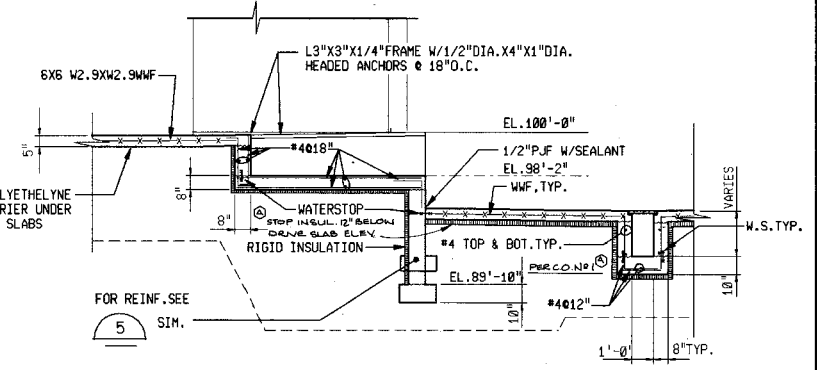


SECTION 11
1/4"=1'-0" AS-1

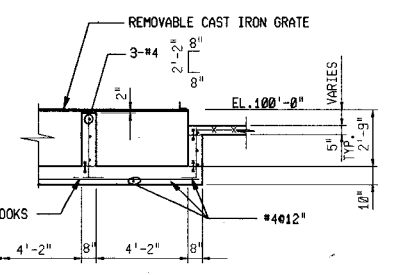

SECTION 12
1/4"=1'-0" AS-1

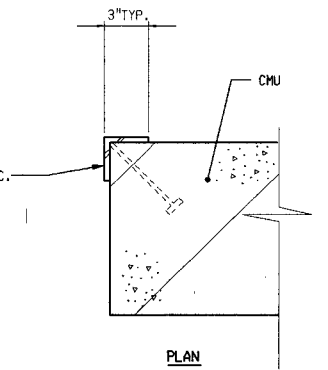


TYP. CORNER GUARD DETAIL 13
AS-2

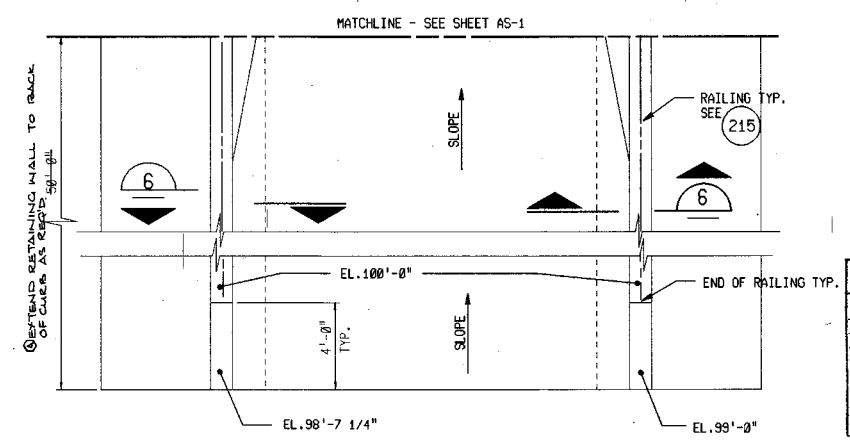

RETAINING WALL PLAN
1/4"=1'-0"

RECORD DRAWING
1. INFORMATION OBTAINED FROM CONTRACTOR'S RECORD DRAWINGS
2. CONTRACTOR: CIVIL CONSTRUCTION
CONSTRUCTION PERIOD: 1988-1991
3. DRAWING REVISIONS BY: GJB
DATE: 6-28-89
4. CHECKED BY: JRS
DATE: 7-24-89

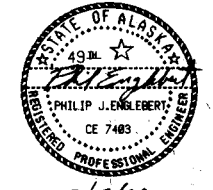

STRUCTURAL DETAILS

Scale	AS SHOWN	Date	2/5/88	Designer	AJB	Drafter	VEN	Checker	DLS	Approver	PJE	No.	Revisions	By	Date

Donohue
Engineers & Architects
COMPUTER AIDED DESIGN/DRAFTING
REGISTERED PROFESSIONAL ENGINEERS
ANCHORAGE, ALASKA

CONTRACT DRAWINGS
HAZARDOUS WASTE STORAGE FACILITY
ANCHORAGE REGIONAL LANDFILL SITE
ANCHORAGE, ALASKA

Sheet No.	17
File No.	A-58868
Project No.	15286
AS-8	
Drawing No.	

221-14

DESIGN CRITERIA

- DESIGN AND CONSTRUCT IN CONFORMANCE WITH THE UNIFORM BUILDING CODE, 1985 EDITION, WITH AMENDMENTS.
- SUPERIMPOSED DESIGN LOADS:
 - A. WIND LOAD: (100 MPH EXP. B PER UBC) 15 PSF
 - B. SNOW LOAD (GROUND): 50 PSF + DRIFT
 - C. SNOW LOAD (ROOF): 40 PSF
 - D. ROOFING DEAD LOAD: 10 PSF (ROOF SUPPORTED EQUIPMENT AND PIPING ADDITIONAL)
- MECHANICAL EQUIPMENT: VERIFY WITH EQUIPMENT SUPPLIER. (SEE EQUIPMENT SCHEDULES)
- STAIRS AND WALKWAYS: 100 PSF OR 1000 LBS CONCENTRATED
- FLOOR SLABS:
 - 1. LOADING DOCK HS20 TRUCK
 - 2. OTHER AREAS 250 PSF
- SEISMIC CRITERIA
 - 1. Z=1.0
 - 2. T=1.0
 - 3. K=1.0

FOUNDATIONS

- NET SOIL BEARING CAPACITIES PER GEOTECHNICAL INVESTIGATION BY: DOWL ENGINEERS 3000 PSF
- PLACE FOOTINGS ON UNDISTURBED EARTH OR STRUCTURAL FILL.
- PLACE FILL SIMULTANEOUSLY ON BOTH SIDES OF FREE-STANDING STRUCTURES.
- TO MINIMIZE LATERAL FORCES AGAINST THE STRUCTURE DUE TO WEDGING ACTION OF THE SOIL, BEGIN COMPACTION OF EACH LAYER AT THE STRUCTURE WALL.
- PROVIDE VAPOR BARRIER BELOW SLAB. CONCRETE

- REINFORCING STEEL
 - A. BARS: ASTM A615-GRADE 60
 - B. WELDED WIRE FABRIC (W/WF): ASTM A185
- UNLESS OTHERWISE SHOWN PROVIDE COVER FOR REINFORCEMENT AS FOLLOWS:
 - A. CAST AGAINST EARTH: 3 INCHES
 - B. EXPOSED TO EARTH OR WEATHER
 - 1. #6 THRU #18 BARS: 2 INCHES
 - 2. #5 BARS AND SMALLER: 1 1/2 INCHES
 - C. NOT EXPOSED TO EARTH OR WEATHER: 1 INCH
- PLACE DOWELS BEFORE PLACING CONCRETE.
- DO NOT WELD OR FIELD BEND REINFORCING BARS.
- CONCRETE
 - A. SLABS REINFORCED W/WWF AND WHERE NOTED: CLASS B F'c=3000 PSI
 - B. ALL LOCATIONS EXCEPT WHERE CLASS B IS SPECIFIED: CLASS A F'c=4000 PSI
- PROVIDE WATERSTOP IN CONSTRUCTION JOINTS IN LOCATIONS SHOWN OR NOTED ON THE DRAWINGS.
- UNLESS OTHERWISE NOTED, CONSTRUCTION JOINTS SHOWN ARE OPTIONAL. CONSTRUCTION JOINTS NOT SHOWN ON THE DRAWINGS ARE SUBJECT TO APPROVAL BY THE ENGINEER.
- CONSTRUCTION JOINTS SHALL HAVE KEYS OR ROUGHENED SURFACES. WHERE ROUGHENED SURFACE IS USED, THE SURFACE SHALL HAVE AN AMPLITUDE OF 1/4" MIN.
- PITCH ALL FLOORS TO FLOOR DRAINS & GUTTERS, MIN. 1/8"/FT. UNLESS NOTED OTHERWISE, MAINTAIN FLOOR SLAB THICKNESS AT MINIMUM INDICATED.
- CHAMFER EXPOSED EDGES OF CONCRETE 3/4" UNLESS OTHERWISE NOTED.

MASONRY

- MASONRY OPENINGS LESS THAN 4'-0" IN WIDTH THAT DO NOT HAVE A LINTEL SCHEDULED SHALL HAVE A BOND BEAM WITH 2-#4 BARS TOP & BOT. OR DOUBLE STEEL ANGLE LINTEL WITH A TOTAL WIDTH OF HORIZONTAL LEGS APPROXIMATELY 1" LESS THAN WALL THICKNESS.
- PROVIDE A MINIMUM OF 8" BEARING AT EACH END FOR LINTELS UNLESS NOTED OTHERWISE.
- PROVIDE HORIZONTAL AND VERTICAL MASONRY REINFORCEMENT IN WALLS AS DETAILED.
- BRACE MASONRY WALLS UNTIL LATERAL SUPPORT ANCHORAGE, MASONRY, BOND BEAMS AND CONC. CAPS HAVE BEEN IN PLACE A MINIMUM OF 7 DAYS.



METALS

- STEEL
 - A. STRUCTURAL STEEL: ASTM A36
 - B. MISCELLANEOUS STEEL: ASTM A36
 - C. STEEL PIPE AND TUBE: ASTM A53, A500, OR A501
 - D. BOLTED CONNECTIONS: ASTM A325
- WELD STRUCTURAL STEEL WITH E70 ELECTRODES IN ACCORDANCE WITH A.W.S. REQUIREMENTS.

MISCELLANEOUS

- FOR ADDITIONAL OPENINGS, ANCHORS AND EMBEDDED ITEMS SEE ARCHITECTURAL, PLUMBING, HVAC & ELECTRICAL DRAWINGS.
- VERIFY PERTINENT EXISTING CONDITIONS AND DIMENSIONS BEFORE STARTING CONSTRUCTION AND/OR FABRICATION.

LINTEL SCHEDULE				
MARK	DESCRIPTION	LOCATION	TYPE	REMARKS
L-1	8"x8" BOND BEAM WITH 2-#4 TOP & BOT.	OPENING 6'-0" WIDE OR LESS	☑	8" BEARING EACH END
L-2	8"x16" BOND BEAM WITH 2-#4 TOP & BOT.	OPENINGS OVER 6'-0" WIDE	☑	8" BEARING EACH END
L-3	6"x8" BOND BEAM WITH 2-#4 TOP & BOT.	OPENINGS IN 6" CMU	☑	8" BEARING EACH END

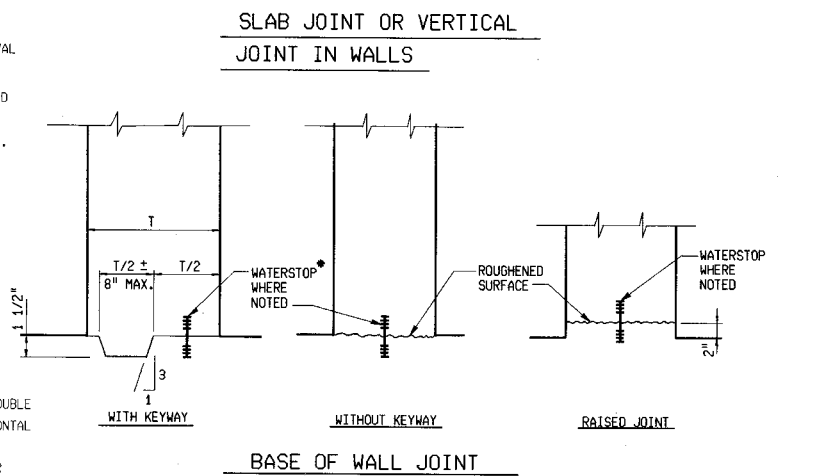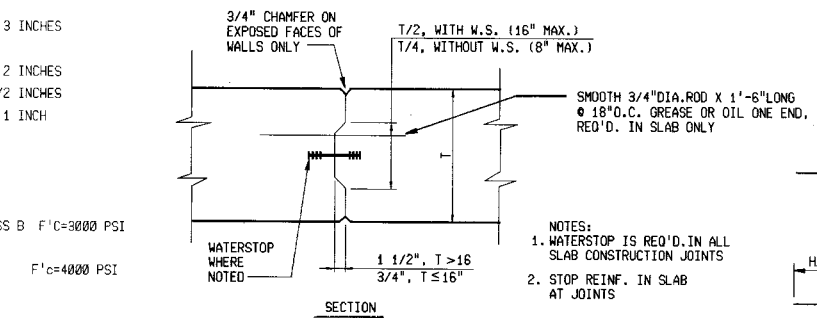


TYPICAL CONSTRUCTION JOINT DETAILS 301


MINIMUM REINFORCEMENT BAR SPLICE AND ANCHORAGE LENGTH (INCHES) 302

BAR SIZE	LAPPED SPLICE LENGTH		EMBEDMENT LENGTH		COMPRESSION LAP LENGTH
	TOP BARS	OTHERS	TOP BARS	OTHERS	
3	17	12	12	12	12
4	23	16	14	12	12
5	29	21	17	12	15
6	34	25	20	14	18
7	44	31	26	19	21
8	57	41	34	24	24
9	73	52	43	31	27
10	92	66	54	39	31
11	113	81	66	48	34


- NOTES:
- TOP BARS ARE HORIZONTAL BARS SO PLACED THAT MORE THAN 12" OF CONCRETE IS CAST IN THE MEMBER BELOW THE BAR.
 - FOR BARS SPACED LESS THAN 6" O.C., INCREASE LENGTH BY 25%.
 - WHEN LAPPING TWO DIFFERENT SIZE BARS USE THE LAP LENGTH OF THE SMALLER BAR UNLESS NOTED OTHERWISE.
 - EMBEDMENT LENGTH IS MINIMUM LENGTH OF EMBEDMENT FOR STRAIGHT DOWELS WHERE END HOOK IS NOT SHOWN, UNLESS OTHERWISE NOTED.
 - COMPRESSION LAP LENGTH FOR VERTICAL COLUMN BARS ONLY
 - HOOKS SHALL BE ACI STANDARD UNLESS OTHERWISE NOTED.

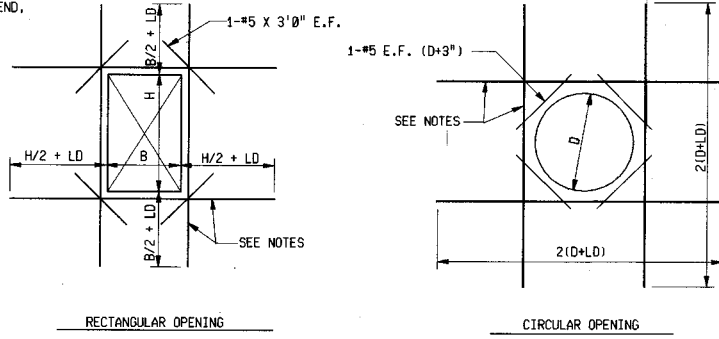

TYPICAL ADDITIONAL REINFORCEMENT AT OPENINGS IN WALLS AND SLABS 303

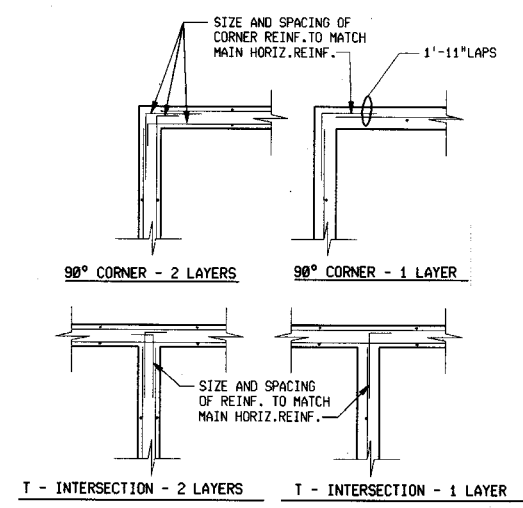


HORIZONTAL REINFORCEMENT DETAIL 307

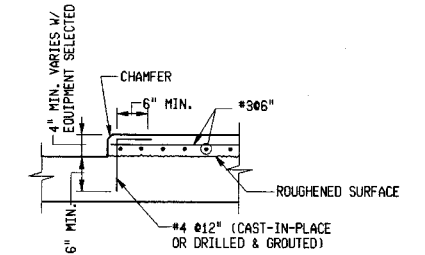

EQUIPMENT PAD DETAIL 317A

- NOTES:
- FOR EQUIPMENT PAD WITH ANCHOR BOLTS SEE 317C
 - VERIFY PAD SIZE WITH EQUIPMENT SUPPLIED.


- NOTES:
- THESE DETAILS APPLY TO ALL OPENINGS IN CONCRETE WALLS AND SLABS WHEN LARGEST OPENING DIMENSION IS GREATER THAN TWO TIMES SECTION THICKNESS OR GREATER THAN REINFORCING SPACING IN THE SECTION, UNLESS OTHERWISE INDICATED IN THE DRAWINGS.
 - THE AREA OF ADDITIONAL REINFORCEMENT REQUIRED IN EACH FACE ON EACH SIDE OF AN OPENING SHALL EQUAL OR EXCEED ONE-HALF OF THE AREA OF THE INTERCEPTED BARS IN EACH FACE, IN EACH DIRECTION, RESPECTIVELY WITH A MINIMUM OF 1-#5 BAR EACH FACE.
 - PLACE THE ADDED BARS IN THE SAME LAYERS AS THE WALL OR SLAB REINFORCING.
 - LD=EMBEDMENT LENGTH. SEE 302

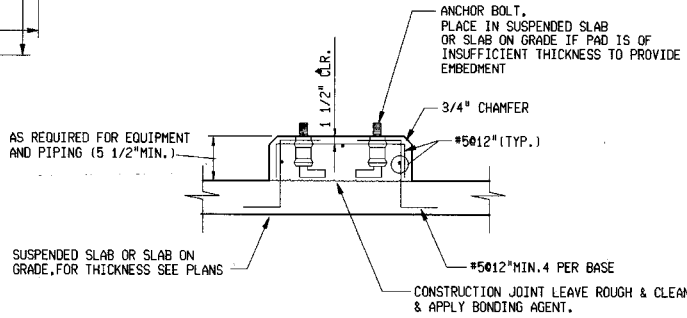

EQUIPMENT PAD DETAIL 317C

- VERIFY PAD SIZE WITH EQUIPMENT SUPPLIED.

RECORD DRAWING	
1. INFORMATION OBTAINED FROM:	CONTRACTOR: PHILIP J. ENLEBERT (NO REVISIONS NOTED)
2. CONTRACTOR: CHANGE CONSTRUCTION	CONSTRUCTION PERIOD: 1988-1989
3. DRAWING REVISIONS BY:	DATE: 12-18-89
4. CHECKED BY:	DATE: 7-24-87

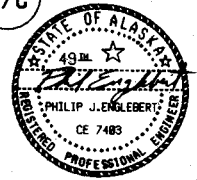

STRUCTURAL DETAILS 2/0/88


Scale	None
Date	2/5/88
Designer	A.B.
Drafter	VEN
Checker	DLS
Approver	PJE
No.	
Revisions	
By	
Date	

Donohue
Engineers & Architects
COMPUTER AIDED DESIGN/DRAFTING
REGISTERED PROFESSIONAL ENGINEERS


CONTRACT DRAWINGS
HAZARDOUS WASTE STORAGE FACILITY ANCHORAGE REGIONAL LANDFILL SITE
ANCHORAGE, ALASKA

Sheet No.	18
File No.	A-58867
Project No.	15286
Drawing No.	AS-9


221-13

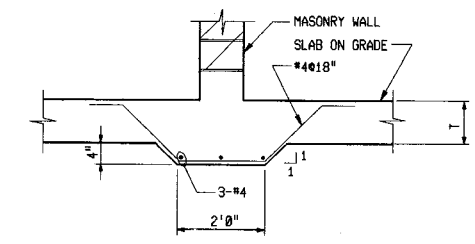

SLAB THICKENING AT INTERIOR PARTITION WALL 319

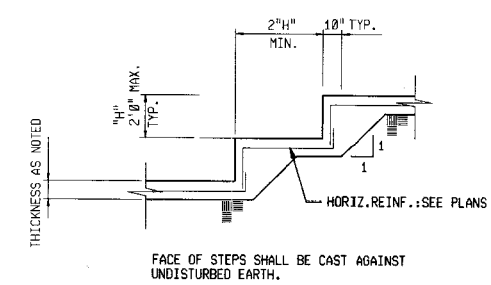


STEPPED WALL FOOTING DETAIL 330A

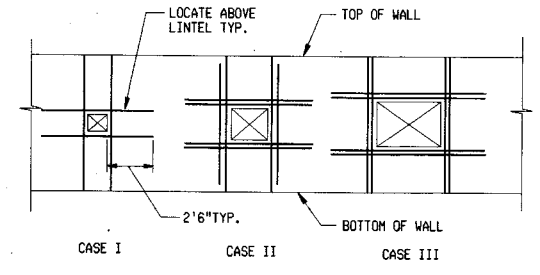


- NOTES:
1. ALL REINF. SHOWN TO BE #5 BARS.
 2. CASE I APPLIES TO ALL OPENINGS GREATER THAN 100 SQ. INCHES WITH LEAST DIMENSION LESS THAN 2'-0".
 3. CASE II APPLIES TO ALL OPENINGS WITH LEAST DIMENSION GREATER THAN OR EQUAL TO 2'-0" BUT LESS THAN 4'-0".
 4. CASE III APPLIES TO ALL OPENINGS WITH LEAST DIMENSION GREATER THAN OR EQUAL TO 4'-0".


TYPICAL ADDITIONAL MASONRY REINF. AT OPENINGS DETAIL 345B

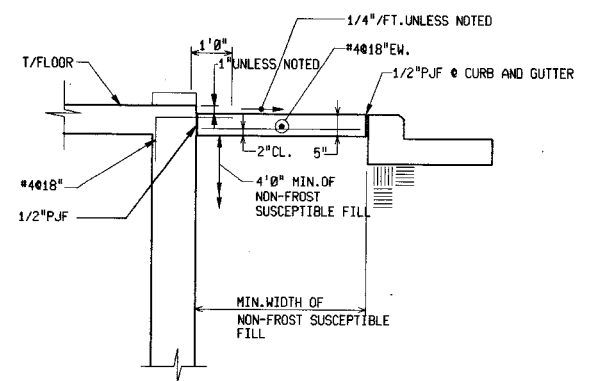


DOOR STOOP 320B

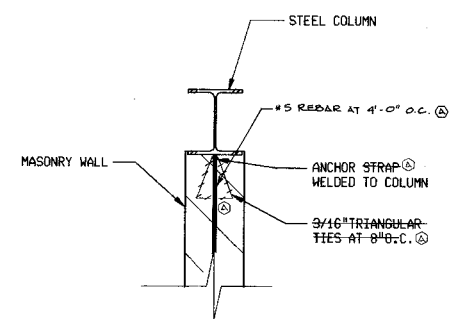


MASONRY WALL ANCHOR DETAIL 344C

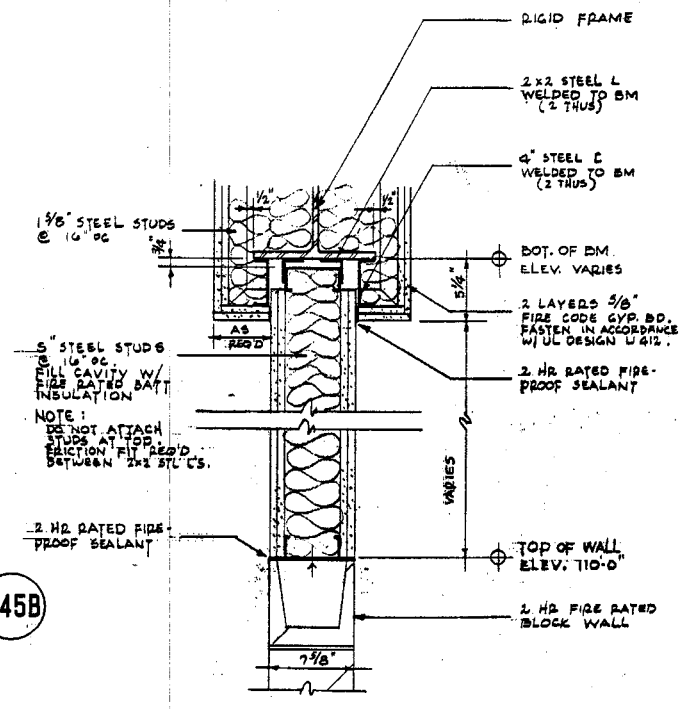


REVISION TO DETAIL 204
STUD WALL BETWEEN MASONRY WALL AND RIGID FRAME AT STORAGE BAYS.

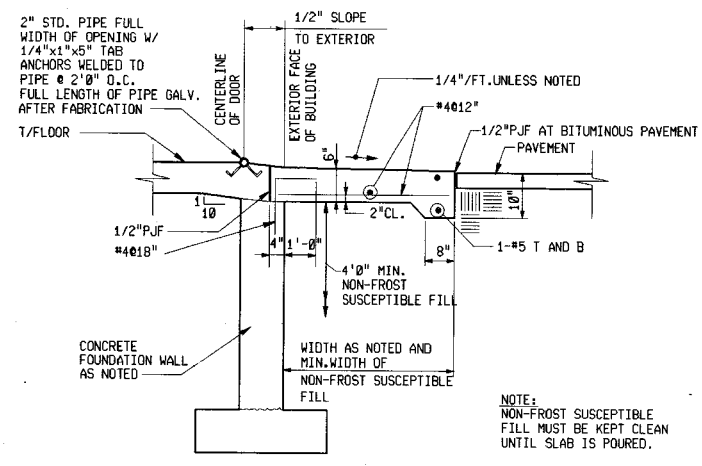

APPROACH SLAB 321B

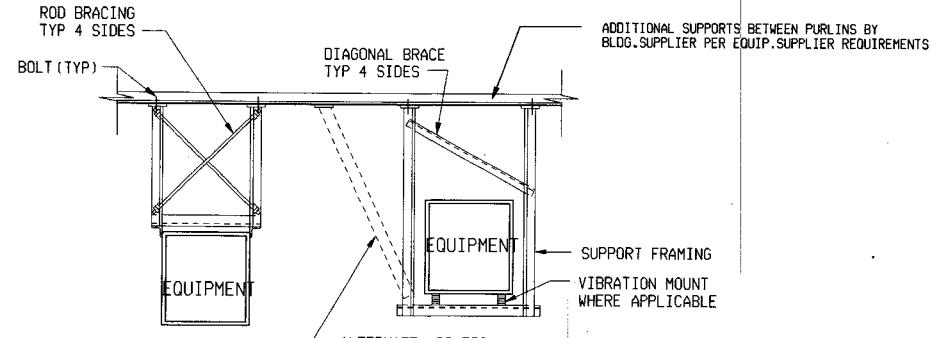

SUSPENDED EQUIPMENT
DETAIL A DETAIL B

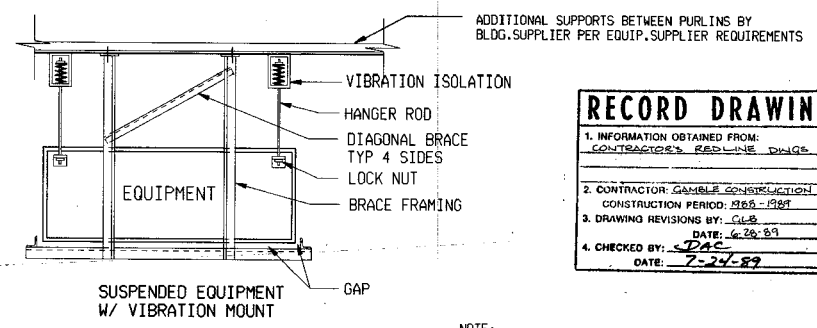

SUSPENDED EQUIPMENT W/ VIBRATION MOUNT
DETAIL C

MECHANICAL EQUIPMENT SEISMIC DETAILS 398B

RECORD DRAWING

1. INFORMATION OBTAINED FROM: CONTRACTOR'S REDLINE DRAWING

2. CONTRACTOR: GAMBLE CONSTRUCTION
CONSTRUCTION PERIOD: 1985-1987

3. DRAWING REVISIONS BY: CLS
DATE: 6-28-89

4. CHECKED BY: DAC
DATE: 7-24-89



2/8/88

Scale	None	Date	2/5/88	Designer	AJB	Drafter	VEN	Checker	DLS	Approver	PJE	No.	Revisions	By	Date

Donohue
Engineers & Architects
COMPUTER AIDED DESIGN/DRAFTING
REGISTERED PROFESSIONAL ENGINEERS

CONTRACT DRAWINGS
HAZARDOUS WASTE STORAGE FACILITY
ANCHORAGE REGIONAL LANDFILL SITE
ANCHORAGE, ALASKA

Sheet No.	19
File No.	A-50866
Project No.	15286
Drawing No.	AS-10


221-12

DRAWING NUMBER

NUMBER

REFERENCE FILES
R1=052: [340001] BORDER REF (L-V-11-20)
R2=052: [340001] JPLN1.ARC
R3=

W/P SCALE - 4
PLOT NAME - PFP1
(FULL SIZE)
W/P SCALE - 1/4"=1'-0"
PLOT NAME - PFP1
(FULL SIZE)

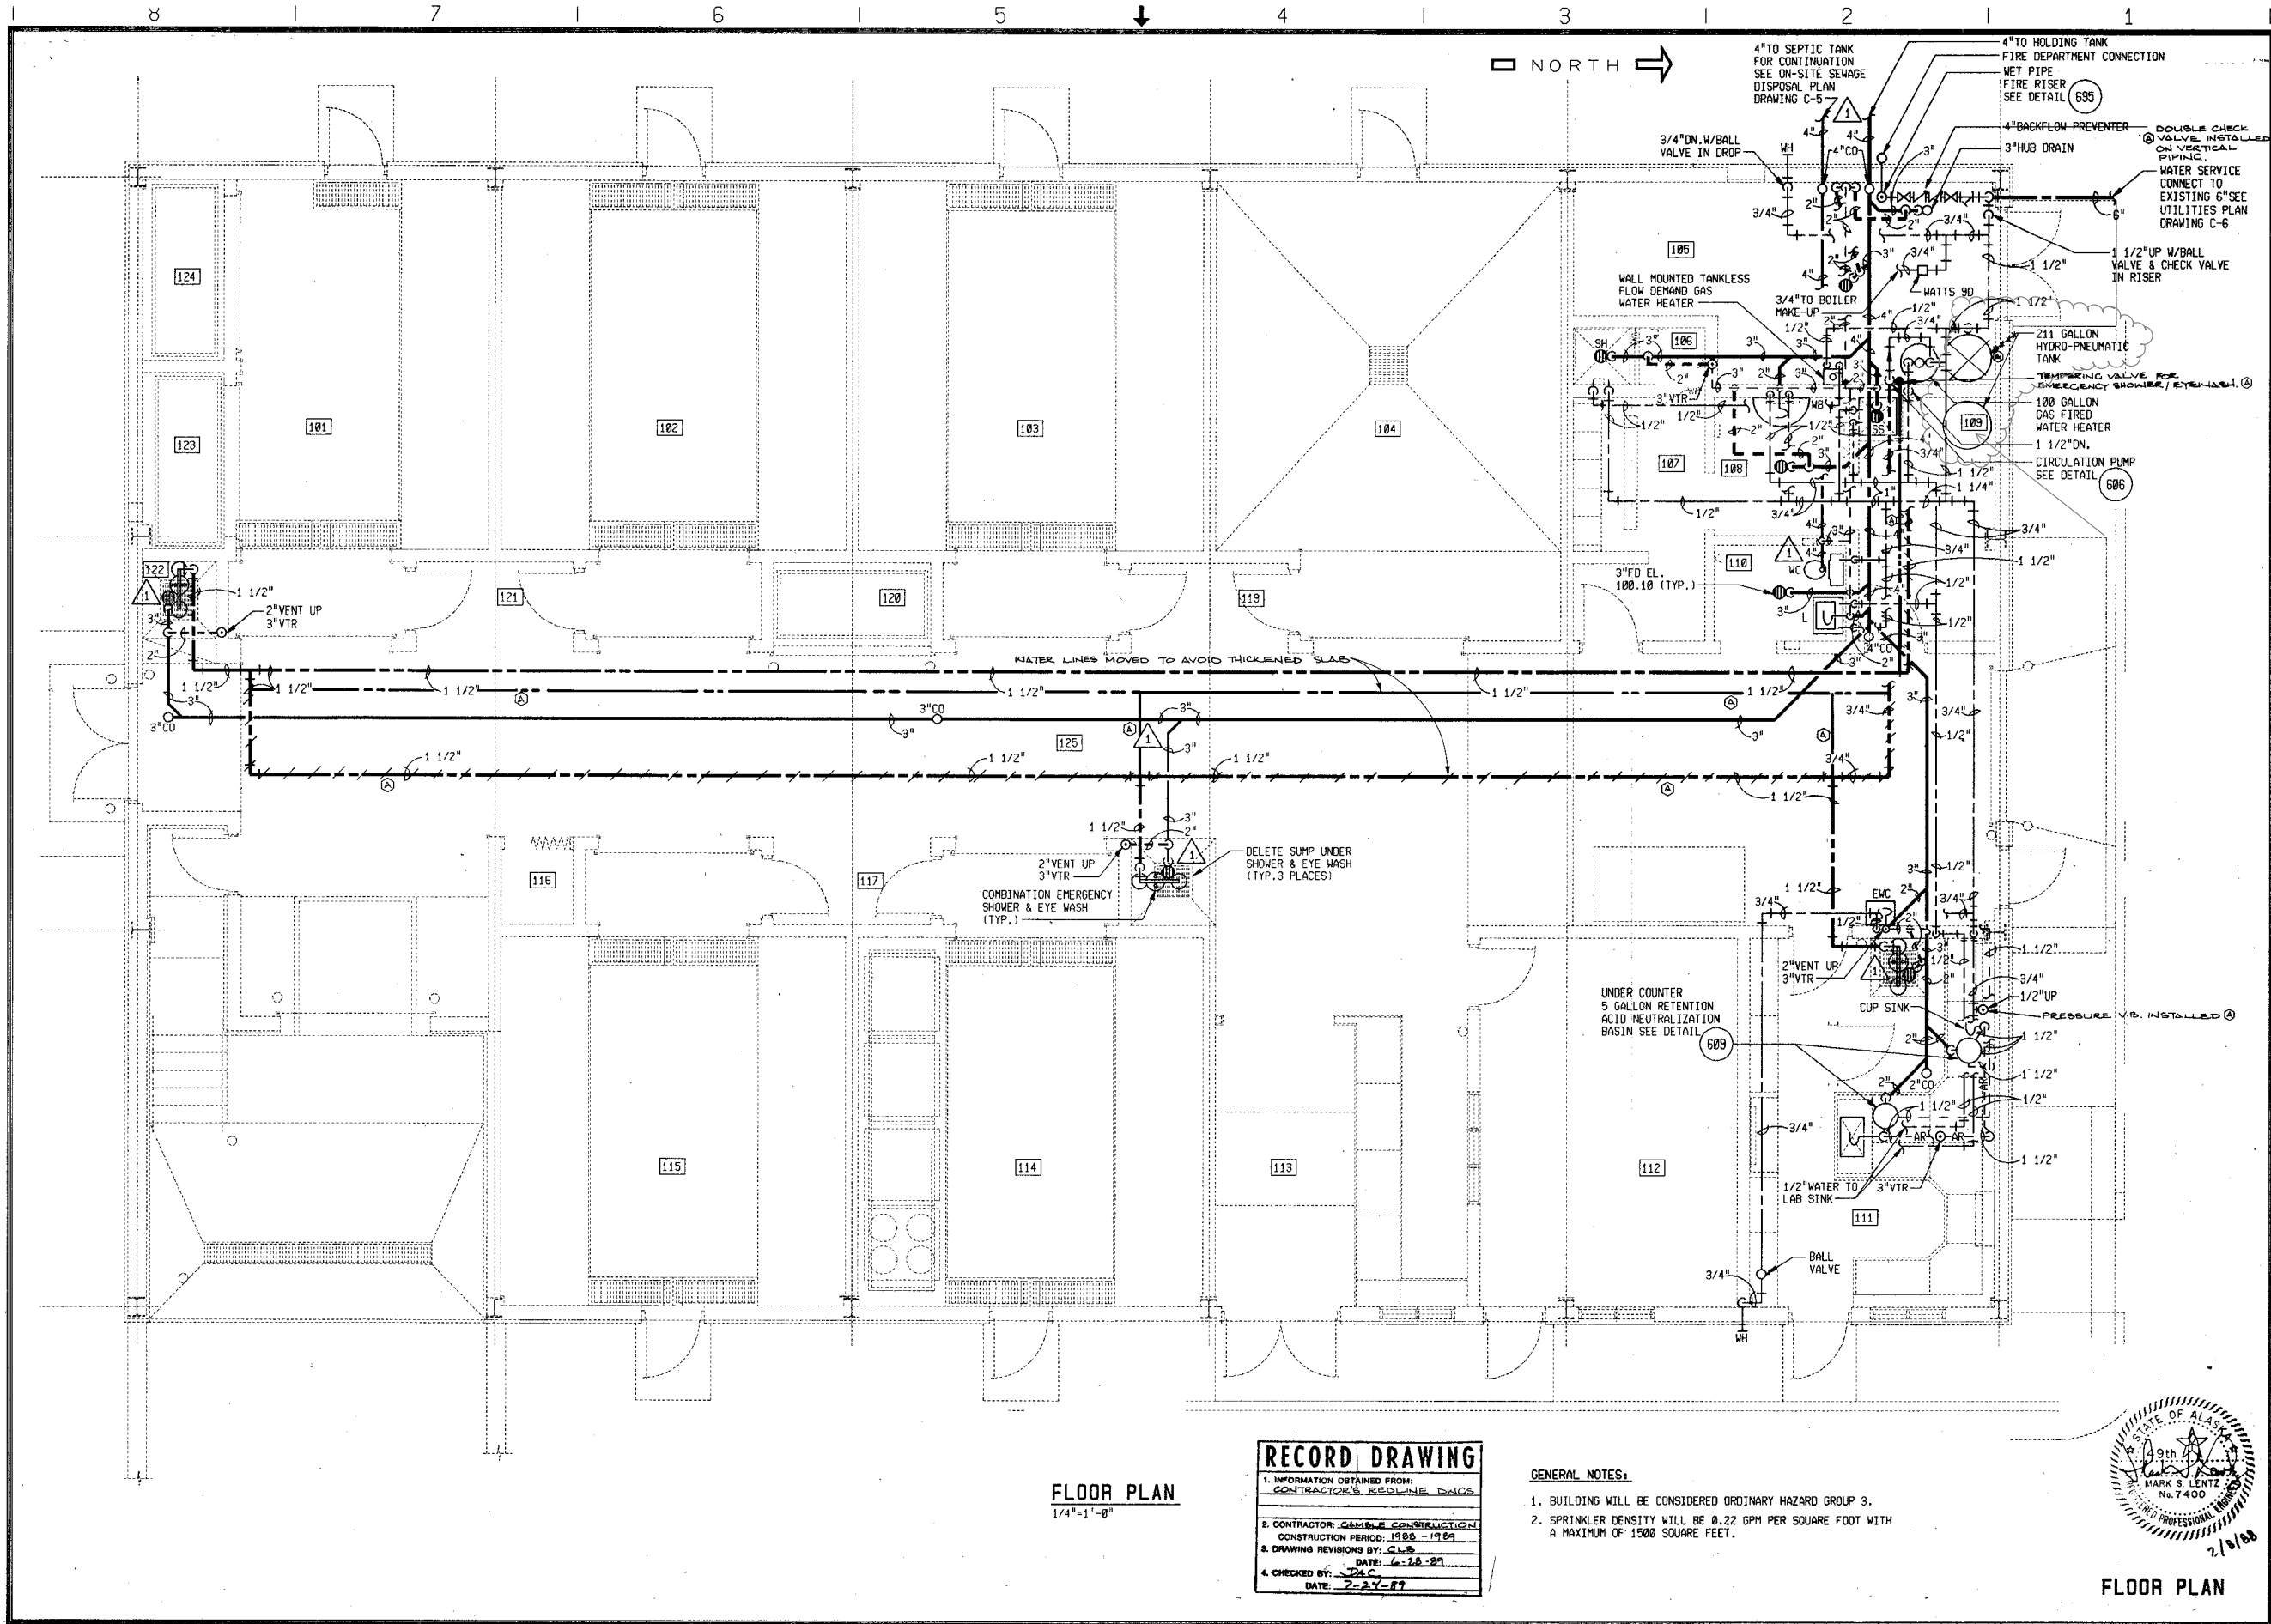

FLOOR PLAN
1/4"=1'-0"

RECORD DRAWING	
1. INFORMATION OBTAINED FROM:	CONTRACTOR'S REDLINE DWGS
2. CONTRACTOR:	GAMBLE CONSTRUCTION
CONSTRUCTION PERIOD:	1988 - 1989
3. DRAWING REVISIONS BY:	CLB
DATE:	6-28-89
4. CHECKED BY:	DLC
DATE:	7-24-89

GENERAL NOTES:

- BUILDING WILL BE CONSIDERED ORDINARY HAZARD GROUP 3.
- SPRINKLER DENSITY WILL BE 0.22 GPM PER SQUARE FOOT WITH A MAXIMUM OF 1500 SQUARE FEET.



FLOOR PLAN

Scale	Date	Designer	Drafter	Checker	Approver	No.	Revisions	By	Date
1/4"=1'-0"	2/5/88	WJB	CSO	MSL	MSL				

Donohue
Engineers & Architects
COMPUTER AIDED DESIGN/DRAFTING
ENGINEERS

CONTRACT DRAWINGS
HAZARDOUS WASTE STORAGE FACILITY
ANCHORAGE REGIONAL LANDFILL SITE
ANCHORAGE, ALASKA

Sheet No.	20
File No.	A-50865
Project No.	15286
Drawing No.	P/FP-1


221-11

DRAWING NUMBER


DRAWING NUMBER

DRAWING NUMBER


8 7 6 5 4 3 2 1

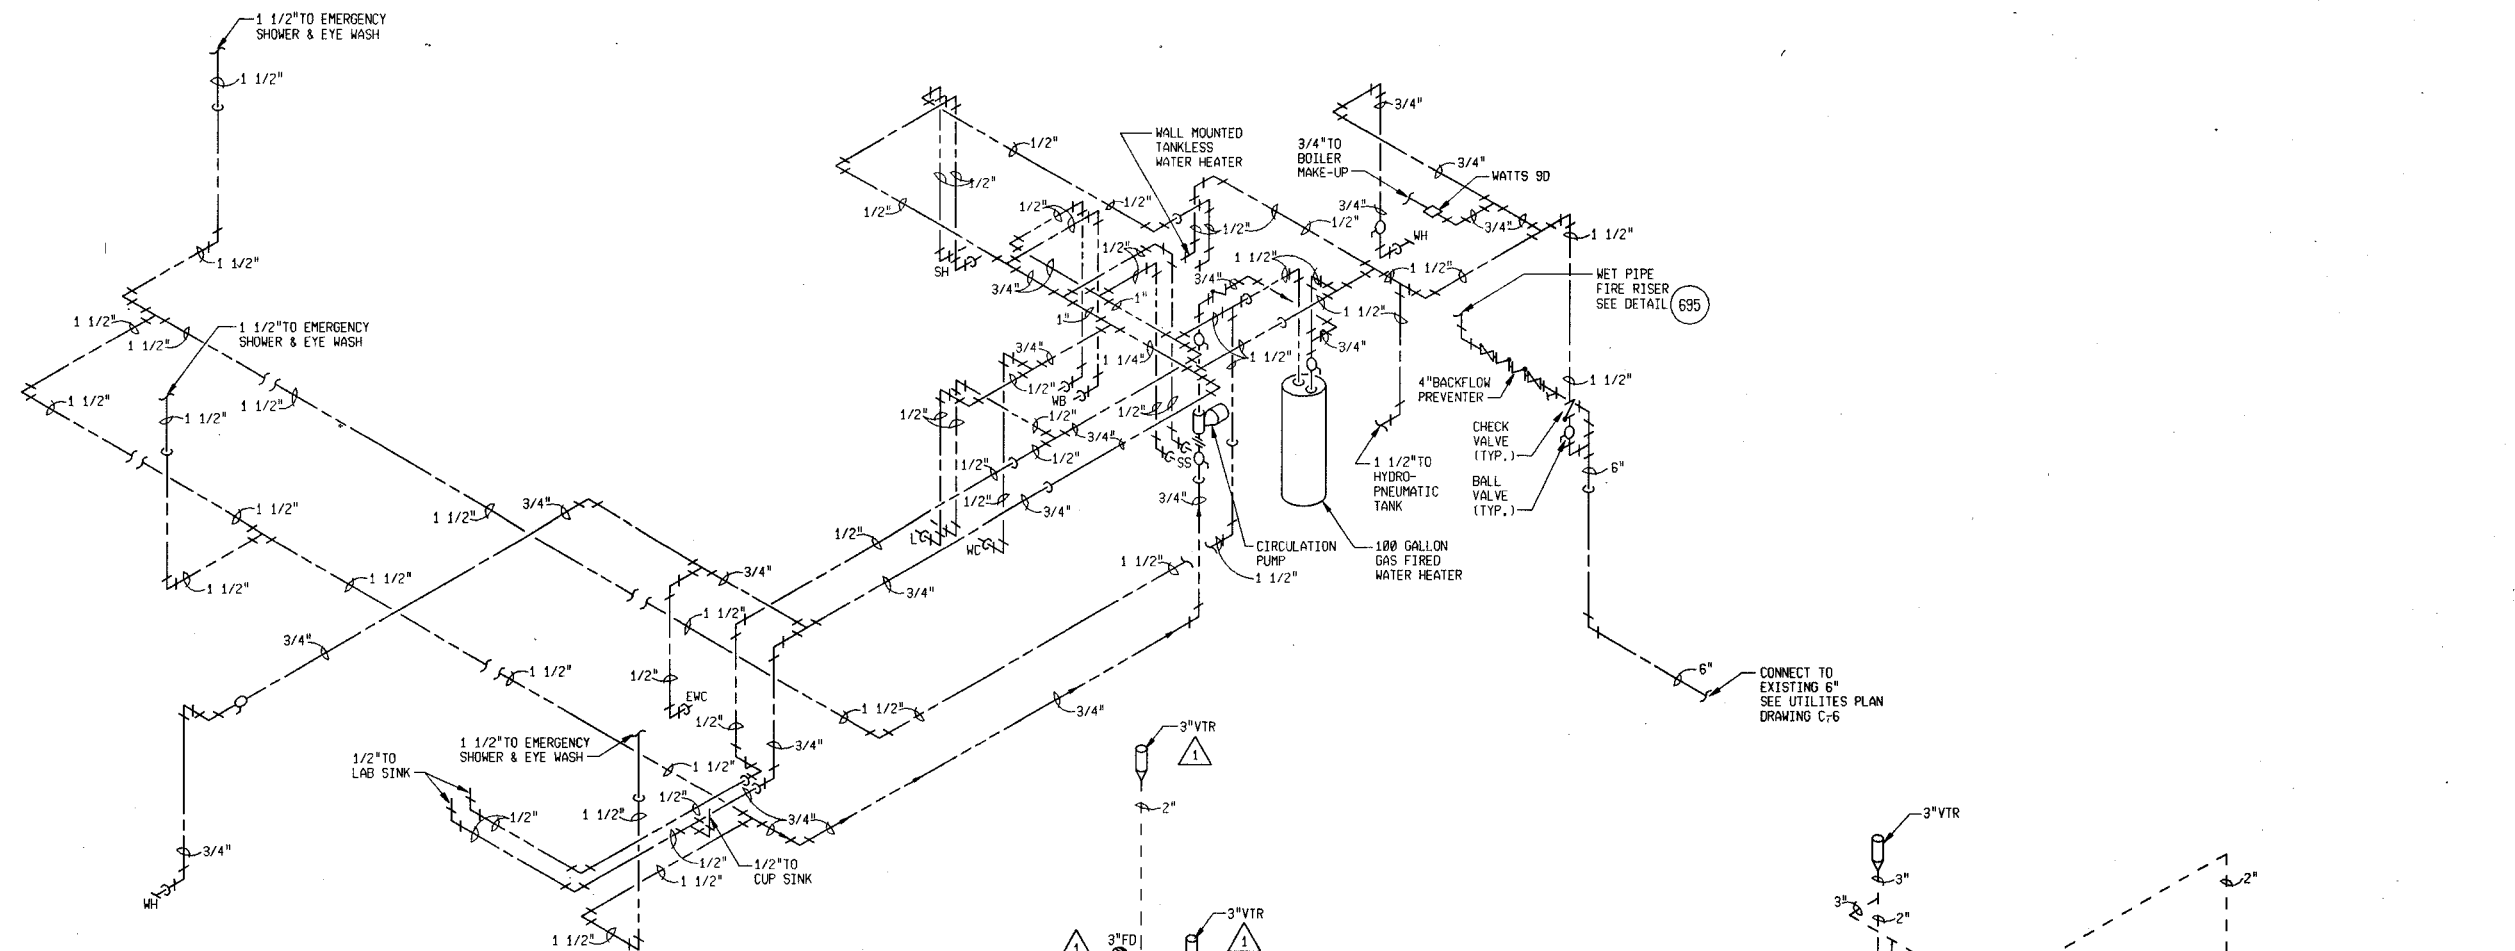

WATER PIPING SCHEMATIC
NTS

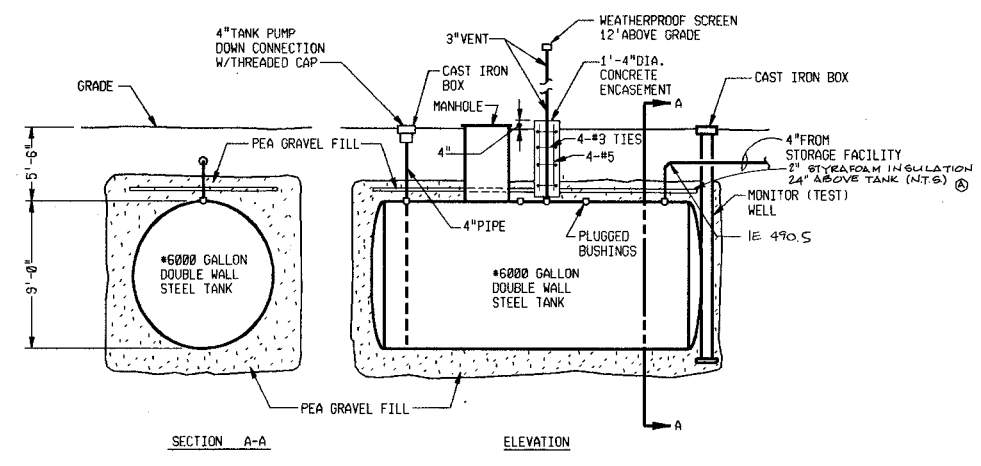

HOLDING TANK DETAIL
NTS **603**

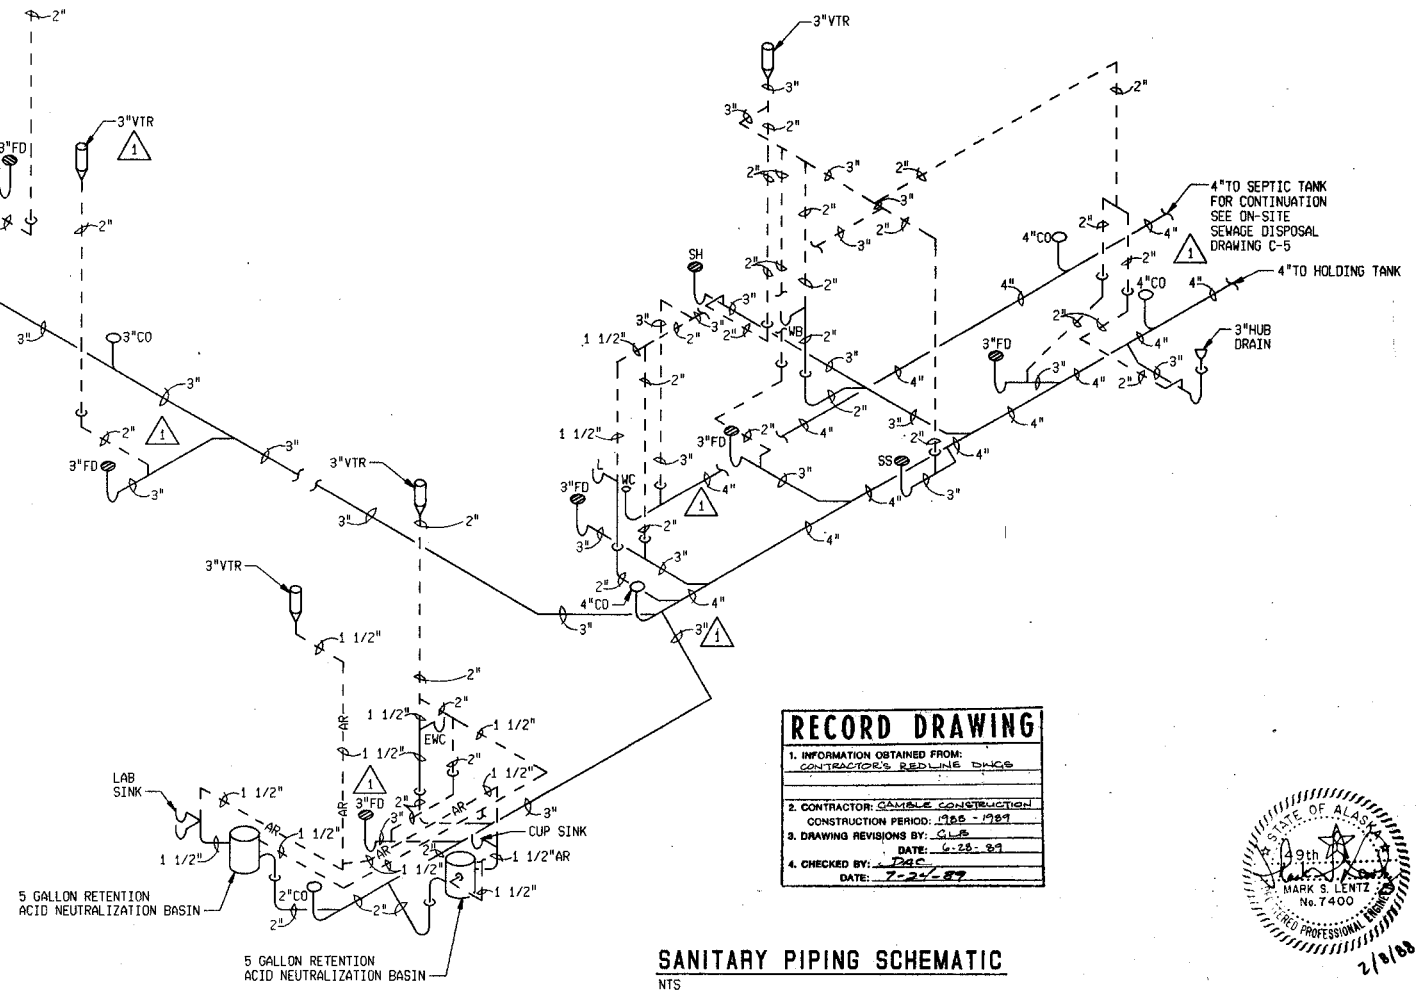

SANITARY PIPING SCHEMATIC
NTS

RECORD DRAWING	
1. INFORMATION OBTAINED FROM:	CONTRACTOR'S REDLINE SINCE
2. CONTRACTOR:	GAMBLE CONSTRUCTION
CONSTRUCTION PERIOD:	1985 - 1987
3. DRAWING REVISIONS BY:	SLB
DATE:	6-28-87
4. CHECKED BY:	PLB
DATE:	7-21-87



SCHEMATICS

Scale	Date	Designer	Checker	Approver	No.	Revisions	By	Date
AS SHOWN	2/5/88	KUB	USD	MSL				
AS SHOWN	2/5/88	KUB	USD	MSL				
Donohue
Engineers & Architects
COMPUTER AIDED DESIGN/DRAFTING
REGISTERED PROFESSIONAL ENGINEERS

CONTRACT DRAWINGS
HAZARDOUS WASTE STORAGE FACILITY
ANCHORAGE REGIONAL LANDFILL SITE
ANCHORAGE, ALASKA


Sheet No.	21
File No.	A-50864
Project No.	15286
Drawing No.	P/FP-2

221-10


8 | 7 | 6 | 5 | 4 | 3 | 2 | 1

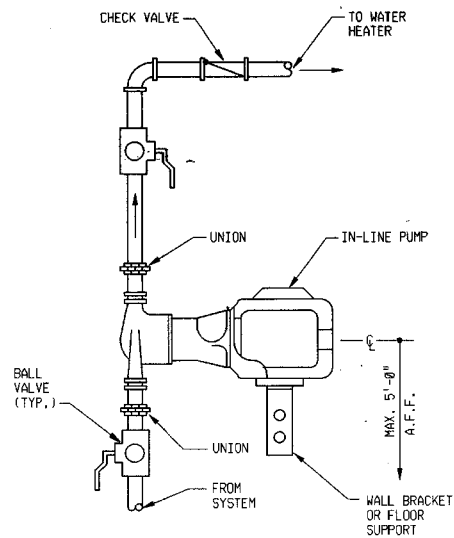


DOMESTIC HOT WATER CIRCULATION PUMP DETAIL (606)
N.T.S.

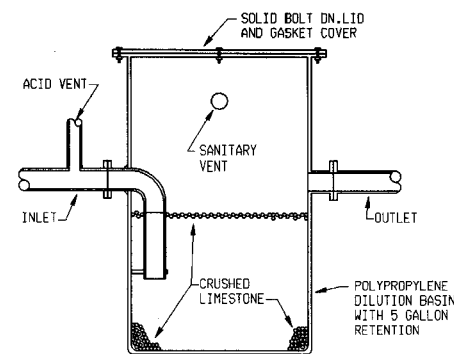

NEUTRALIZATION BASIN DETAIL (609)
N.T.S.

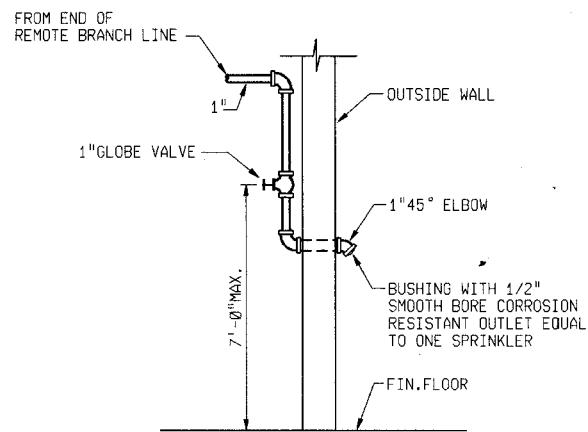


INSPECTORS TEST CONNECTION FOR WET PIPE SPRINKLER SYSTEM (690)
NTS

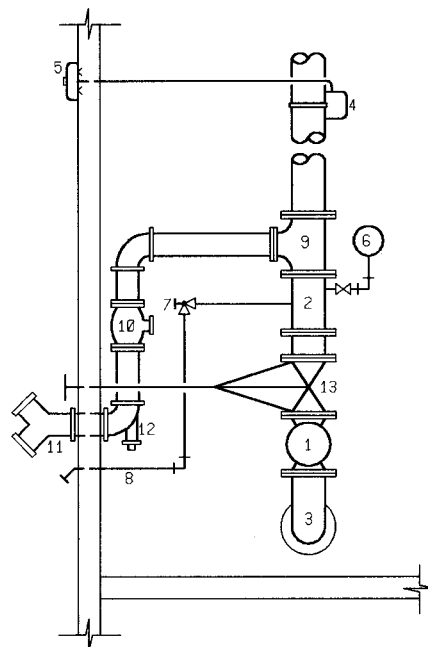

1. CHECK VALVE
2. TEE CONNECTION
3. FROM BACKFLOW PREVENTER
4. WATER FLOW INDICATOR
5. ELECTRIC ALARM VALVE
6. WATER PRESSURE GAGES (WITH SHUT-OFF COCKS)
7. MAIN DRAIN VALVE
8. MAIN DRAIN LINES TO OUTSIDE OF BLDG. (4'-0" MINIMUM LENGTH INSIDE OF BLDG.)
9. TEE FOR FIRE DEPARTMENT CONNECTION
10. CHECK VALVE
11. FIRE DEPARTMENT CONNECTION
12. BALL DRIP
13. INDICATOR VALVE

RISER DIAGRAM FOR WET-PIPE ALARM VALVE (695)
NTS

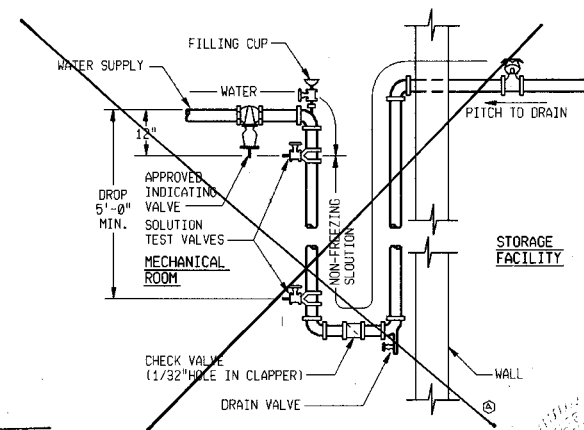

GLYCOL FILL DETAIL (696)
NTS OMIT CO. #1

RECORD DRAWING	
1. INFORMATION OBTAINED FROM:	CONTRACTOR'S RECORDS
2. CONTRACTOR:	GAMES CONSTRUCTION
CONSTRUCTION PERIOD:	1988 - 1989
3. DRAWING REVISIONS BY:	CLB
DATE:	6-28-89
4. CHECKED BY:	DAC
DATE:	7-24-89

STANDARD DETAILS

Scale	1/4"=1'-0"	By	
Date	2/5/88	Revisions	
Designer	KJB	No.	
Drafter	DSO	MSL	
Checker	MSL	MSL	
Approver	MSL		

Donohue
Engineers & Architects
COMPUTER AIDED DESIGN/DRAFTING
REGISTERED PROFESSIONAL ENGINEERS
DOWLE ENGINEERS


CONTRACT DRAWINGS
HAZARDOUS WASTE STORAGE FACILITY
ANCHORAGE REGIONAL LANDFILL SITE
ANCHORAGE, ALASKA

Sheet No.	22
File No.	A-50863
Project No.	15286

P/FP-3

Drawing No.

221-9

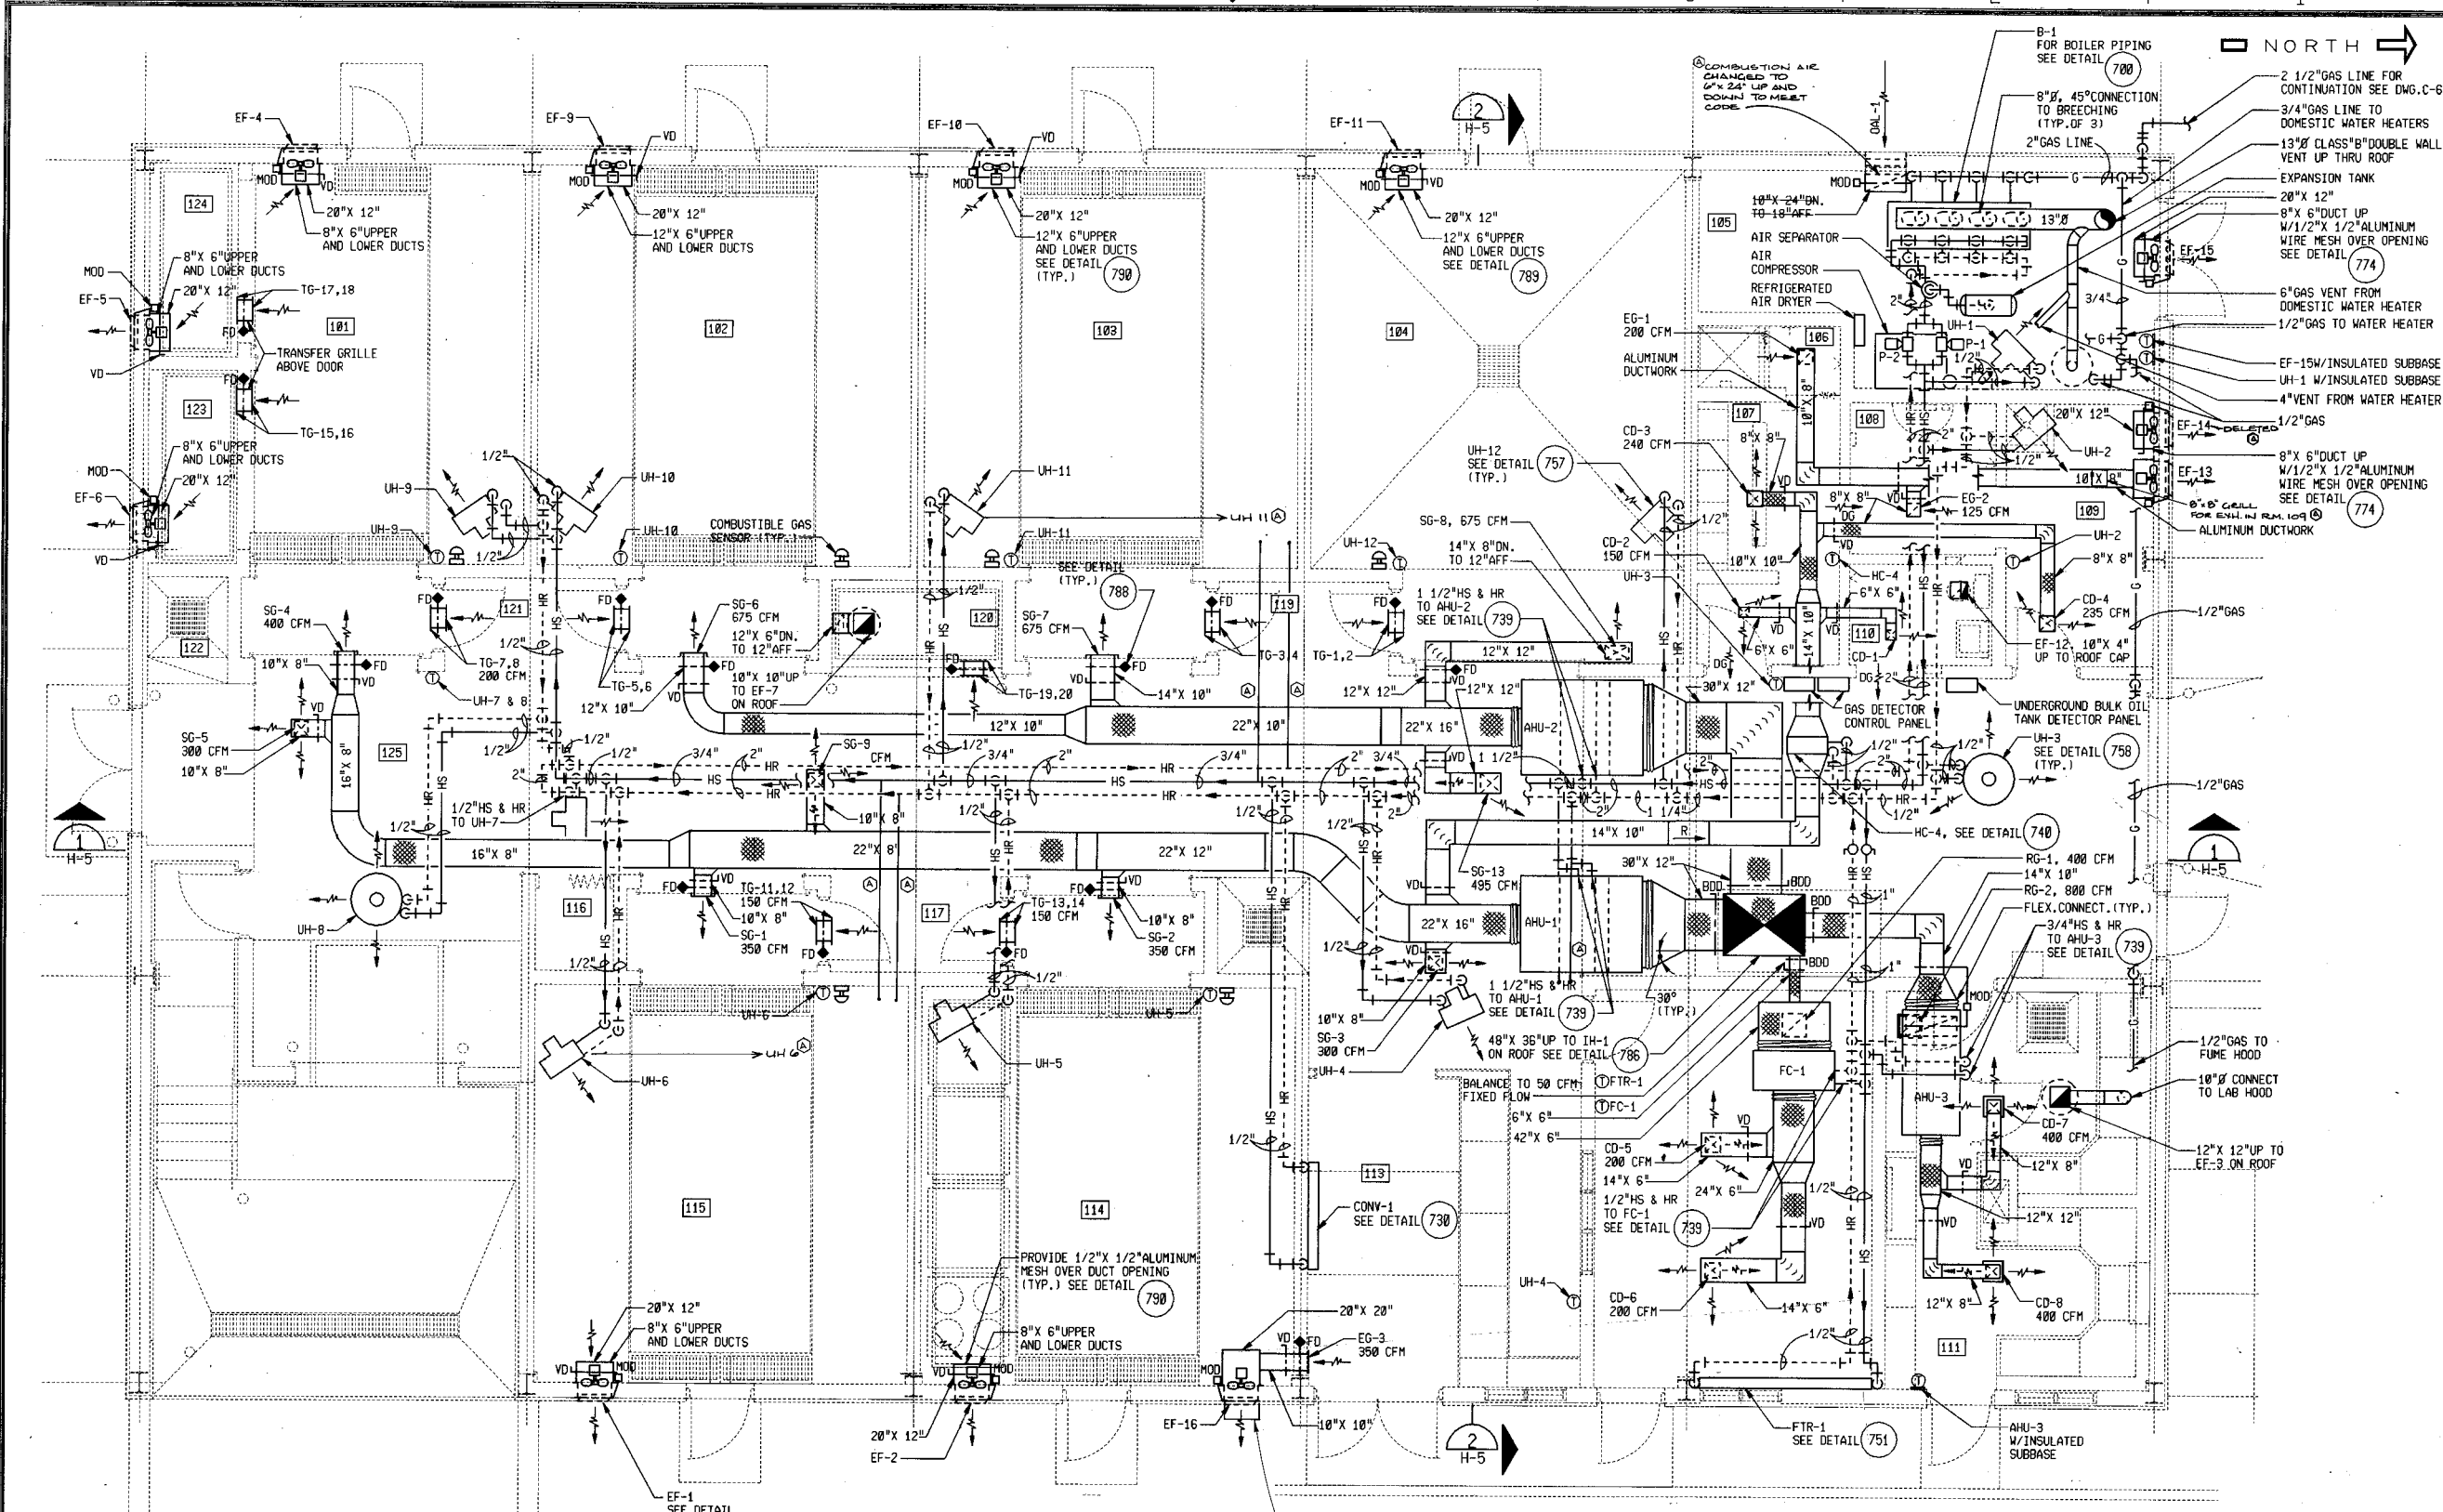

FLOOR PLAN
1/4"=1'-0"


RECORD DRAWING

1. INFORMATION OBTAINED FROM:
CONTRACTOR'S REDLINE DWGS

2. CONTRACTOR GAMBLE CONSTRUCTION
CONSTRUCTION PERIOD: 1988-1989

3. DRAWING REVISIONS BY: CLS
DATE: 6-28-89

4. CHECKED BY: DAC
DATE: 7-27-89

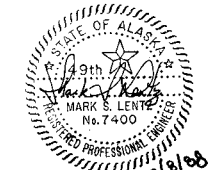

FLOOR PLAN

Scale	1/4"=1'-0"	Date	2/5/88	Designer	ROD	Checker	MSL	Approver	MSL	No.	Revisions	By	Date
A.S. BUILT PER CONTRACTORS REDLINE DWGS DAC 6-28-89													

Donohue
Engineers & Architects
COMPUTER AIDED DESIGN/DRAFTING
ENGINEERS

CONTRACT DRAWINGS
HAZARDOUS WASTE STORAGE FACILITY
ANCHORAGE REGIONAL LANDFILL SITE
ANCHORAGE, ALASKA

Sheet No.	23
File No.	A-50862
Project No.	15286
H-1	
Drawing No.	

221-8

8 | 7 | 6 | 5 | 4 | 3 | 2 | 1

AIR HANDLING UNIT SCHEDULE																
TAG NO.	MANUFACTURER MODEL NO. OR EQUAL	FAN DATA				FILTER DATA		COIL 1		MOTOR DATA				REMARKS		
		SCFM	TSP (IN.WG)	ESP (IN.WG)	BHP	RPM	AREA (SQ.FT.)	TYPE	APD (DIRTY) (IN.WG)	TYPE	TAG NO.	HP	VOLT		PHASE	RPM
AHU-1	TRANE CLIMATE CHANGER 6A	2700	1.81	1.24	1.3	1081	6.94	TA	.5	HOT WATER	HC-1	1 1/2	208	3	1750	
AHU-2	TRANE CLIMATE CHANGER 6W	2520	1.79	1.31	1.3	2046	6.94	TA	.5	HOT WATER	HC-2	1 1/2	208	3	1750	
AHU-3	TRANE CLIMATE CHANGER 3A	800	1.27	1.1	0.3	1328	3.46	TA	.5	HOT WATER	HC-3	1/2	208	3	1750	

BOILER SCHEDULE										
TAG NO.	MANUFACTURER MODEL NO. OR EQUAL	SERVICE & LOCATION	BOILER TYPE	FUEL TYPE	FUEL TRAIN	MIN. FUEL PRESS.	INPUT (MBH)	OUTPUT (MBH) NET (IBR)	STACK SIZE (IN.)	REMARKS

HOT WATER UNIT HEATER SCHEDULE														(CAPACITY BASED ON 60° F EAT)			
TAG NO.	MANUFACTURER MODEL NO. OR EQUAL	TYPE	OUTPUT (MBH)	MOUNT. HEIGHT (FT.)	HYDRONIC COIL DATA				AIR DATA				MOTOR DATA				REMARKS
					GPM	WPD (FT.)	EWT (°F)	LWT (°F)	SCFM	THROW	EAT (°F)	LAT (°F)	HP	VOLT	PHASE	RPM	
UH-1	TRANE 38-S	HORIZ.	9.7	8.0	1.0	.05	180	160	543	18	60	76	1/20	120	1	1550	
UH-2	TRANE 18-S	HORIZ.	3.6	8.0	0.5	.01	180	160	280	12	60	72	1/25	120	1	1050	
UH-3	TRANE 42-P-L	VERT.	7.8	13.0	0.75	.03	180	160	436	—	60	77	1/25	120	1	1150	
UH-4	TRANE 20-W2	HORIZ.	5.3	13.0	0.40	.01	180	155	315	12	60	76	1/25	120	1	1050	PROVIDE WITH LOUVER FIN DIFFUSER
UH-5	TRANE 20-W2	HORIZ.	7.0	13.0	0.67	.03	180	160	315	12	60	81	1/25	120	1	1050	PROVIDE WITH LOUVER FIN DIFFUSER
UH-6	TRANE 20-W2	HORIZ.	10.5	13.0	1.1	.05	180	160	543	18	60	80	1/20	120	1	1550	PROVIDE WITH LOUVER FIN DIFFUSER
UH-7	TRANE 20-W2	HORIZ.	7.8	13.0	0.75	.03	180	160	315	12	60	83	1/25	120	1	1050	PROVIDE WITH LOUVER FIN DIFFUSER
UH-8	TRANE 42-P-L	VERT.	7.8	13.0	0.75	.03	180	160	436	—	60	77	1/25	120	1	1150	PROVIDE WITH LOUVER FIN DIFFUSER
UH-9	TRANE 38-S	HORIZ.	11.5	13.0	1.1	.05	180	160	543	18	60	80	1/20	120	1	1550	PROVIDE WITH LOUVER FIN DIFFUSER
UH-10	TRANE 20-W2	HORIZ.	7.0	13.0	0.67	.03	180	160	315	12	60	81	1/25	120	1	1050	PROVIDE WITH LOUVER FIN DIFFUSER
UH-11	TRANE 20-W2	HORIZ.	7.0	13.0	0.67	.03	180	160	315	12	60	81	1/25	120	1	1050	PROVIDE WITH LOUVER FIN DIFFUSER
UH-12	TRANE 20-W2	HORIZ.	7.0	13.0	0.67	.03	180	160	315	12	60	81	1/25	120	1	1050	PROVIDE WITH LOUVER FIN DIFFUSER, PROVIDE MOTOR FOR CLASS I DIV. II ENVIRONMENT

FAN COIL SCHEDULE														
TAG NO.	MANUFACTURER MODEL NO. OR EQUAL	TYPE	CFM	HEATING COIL DATA					MOTOR DATA				REMARKS	
				EAT (°F)	LAT (°F)	MBH	WPD (IN.WG)	GPM	EWT (°F)	WATTS	VOLT	PHASE		RPM
FC-1	TRANE C3400-04	RECESS HORIZ.	420	59	106	12.1	1.2	1.0	180	130	120	1	1200	MEDIUM SPEED

FINNED TUBE RADIATION SCHEDULE														(CAPACITY BASED ON 65° F EAT.)		
TAG NO.	MANUFACTURER MODEL NO. OR EQUAL	CAPACITY (BTUH/LF.)	FLOW (GPM)	AWT (°F)	ELEMENT DATA				ENCLOSURE DATA				FINISH	VALVE Cv	REMARKS	
					ROWS	FIN MATL.	TUBE SIZE	SERIES (FPF)	ACTIVE LENGTH (FT)	TYPE	HEIGHT (IN)	DEPTH (IN)				LENGTH (IN)
FTR-1	TRANE MODEL 10S	810	0.7	170	1	ALUM.	3/4"	58	6.5	10S	10	4	102	12 1/8 IN	BAKED ENAMEL	5.3

HOT WATER COIL SCHEDULE																		
TAG NO.	MANUFACTURER MODEL NO. OR EQUAL	CAPACITY (MBH)	WIDTH (IN.)	LENGTH (IN.)	AIR DATA				HYDRONIC DATA				NO. ROWS	FINS PER FT.	FIN SERIES	TURBS	VALVE Cv	REMARKS
					SCFM	APD (IN.WG)	EAT (°F)	LAT (°F)	FACE VELOCITY (FPM)	GPM	WPD (FT)	EWT (°F)						
HC-1	TRANE TYPE W	242.0	18	45	2700	.13	-23	60	480	26.7	.7	180	160	2	102	PF	NO	
HC-2	TRANE TYPE W	226.0	18	45	2520	.11	-23	60	448	25.0	.6	180	160	2	98	PF	NO	
HC-3	TRANE TYPE W	93	18	24	800	.05	-23	85	267	10.3	.2	180	160	2	110	PF	YES	
HC-4	TRANE P-2	23	12	18	755	.12	60	84	503	1.1	.1	180	160	2	80	PF	NO	4.0

RECORD DRAWING

1. INFORMATION OBTAINED FROM: CONTRACTOR'S RECORD, DINGS

2. (NO REVISIONS NOTED)

3. CONSTRUCTION PERIOD: 08/01/08 - 08/01/08

4. DRAWING REVISIONS BY: DAC DATE: 6-28-09

5. CHECKED BY: DAC DATE: 7-24-09

CIRCULATING PUMP SCHEDULE														
TAG NO.	MANUFACTURER MODEL NO. OR EQUAL	SERVICE	TYPE	CAPACITY (GPM)	DISCH. HEAD (FT.)	NPSH (FT.)	MIN. EFF. (%)	SIZE (IN.)		MOTOR DATA				REMARKS
								SUCTION	DISCH.	HP	VOLT	PHASE	RPM	
P-1 & 2	BELL & GOSSETT SERIES 80, 2 X 2 X 9-1/2B	HOT WATER	VERT. IN-LINE	75	70	—	54	2	2	5	208	3	1750	

CONVECTOR SCHEDULE													
TAG NO.	MANUFACTURER MODEL NO. OR EQUAL	CAPACITY (MBH)	EWT (°F)	GPM	ENCLOSURE DATA			ELEMENT DATA				REMARKS	
					HEIGHT (IN)	WIDTH (IN)	DEPTH (IN)	ROWS	TUBE IN	SERIES FPF	WPD (FT)		VALVE Cv
CONV-1	TRANE MODEL AG	10.1	180	1.1	26	62	6	1	1"	—	.27	4.0	

EXHAUST FAN SCHEDULE													
TAG NO.	MANUFACTURER MODEL NO. OR EQUAL	TYPE	AIR DATA			FAN RPM	TIP SPEED (FPM)	MOTOR DATA				DAMPER	REMARKS
			SCFM	ESP (IN.WG)	BHP			HP	VOLT	PHASE	RPM		
EF-1	GREENHECK SDE-14-32-B	WALL CENTRIF.	500	.375	.07	1140	4176	1/4	120	1	1140	MOD	PROVIDE ALUMINUM WHEEL W/TEFC MOTOR
EF-2	GREENHECK SDE-14-32-B	WALL CENTRIF.	500	.32	.07	1140	4176	1/4	120	1	1140	MOD	PROVIDE ALUMINUM WHEEL W/TEFC MOTOR
EF-3	GREENHECK SDE-12-24-E	ROOF UPPLAST	800	.625	.15	1380	4019	1/4	120	1	1750	MOD	PROVIDE ALUMINUM WHEEL
EF-4	GREENHECK SDE-14-32-B	WALL CENTRIF.	400	.32	.07	1050	2980	1/6	120	1	1050	MOD	PROVIDE ALUMINUM WHEEL
EF-5 & 6	GREENHECK SDE-12-24-E	WALL CENTRIF.	100	.25	.016	1050	3299	1/20	120	1	1050	MOD	PROVIDE ALUMINUM WHEEL W/TEFC MOTOR
EF-7	GREENHECK SDE-12-24-E	ROOF CENTRIF.	100	.25	.032	1050	3299	1/20	120	1	1050	MOD	PROVIDE ALUMINUM WHEEL W/TEFC MOTOR
EF-9 & 10	GREENHECK SDE-14-32-A	WALL CENTRIF.	830	.32	.24	590	4170	1/3	120	1	1750	MOD	PROVIDE ALUMINUM WHEEL W/2 SPEED TEFC MOTOR
EF-11	GREENHECK SDE-14-32-A	WALL CENTRIF.	860	.32	.24	1200	4170	1/4	120	1	1750	MOD	PROVIDE ALUMINUM WHEEL W/TEFC MOTOR CLASS I, DIV. II ENVIRONMENT
EF-12	GREENHECK CPS-17	CEILING CENTRIF.	50	.23	—	1050	—	63 WATTS	120	1	1550	BDD	PROVIDE WITH ROOF JACK
EF-13	GREENHECK SDE-12-32-B	WALL CENTRIF.	325	.30	.037	1140	3581	1/6	120	1	1050	MOD	PROVIDE ALUMINUM WHEEL
EF-14	GREENHECK SDE-12-24-E	WALL CENTRIF.	210	.21	.02	860	2632	1/20	120	1	860	MOD	PROVIDE ALUMINUM WHEEL
EF-15	GREENHECK SDE-14-24-B	WALL CENTRIF.	520	.27	.03	1140	4176	1/6	120	1	1140	MOD	PROVIDE ALUMINUM WHEEL
EF-16	GREENHECK SDE-12-32-B	WALL CENTRIF.	350	.32	.06	1140	4176	1/4	120	1	1050	MOD	PROVIDE ALUMINUM WHEEL W/TEFC MOTOR

WALL LOUVER SCHEDULE									
TAG NO.	MANUFACTURER MODEL NO. OR EQUAL	SERVICE	AIR FLOW (SCFM)	WIDTH (INCHES)	HEIGHT (INCHES)	BLADE DEPTH (INCHES)	MAX. APD. (IN.WG)	MAX. FACE VEL. (FPM)	REMARKS

AIR INLET AND OUTLET SCHEDULE											
TAG NO.	MANUFACTURER MODEL NO. OR EQUAL	SERVICE	AIR FLOW (SCFM)	SIZE (INCHES)	MAX. APD. (IN.WG)	MAX. NC.	PATTERN	DAMPER	FINISH	MATERIAL	MOUNTING
SG-6,7,8	TITUS 122-RS5	SUPPLY AIR	SEE PLAN	16 X 10	.05	35	1-WAY	YES	ALUMINUM	EXTRUDED ALUMINUM	DUCT MOUNT
CD-1,2	TITUS TDC	SUPPLY AIR	SEE PLAN	6 X 6	.09	35	4-WAY	NO	ALUMINUM	EXTRUDED ALUMINUM	LAY-IN CEILING
CD-3 THRU CD-6	TITUS TDC	SUPPLY AIR	SEE PLAN	9 X 9	.04	35	4-WAY	NO	ALUMINUM	EXTRUDED ALUMINUM	LAY-IN CEILING
CD-7,8	TITUS TDC	SUPPLY AIR	SEE PLAN	12 X 12	.04	35	4-WAY	NO	ALUMINUM	EXTRUDED ALUMINUM	LAY-IN CEILING
EG-1 & 2	TITUS 50# CORE 50	EXHAUST AIR	SEE PLAN	8 X 8	.02	35	—	NO	ALUMINUM	EXTRUDED ALUMINUM	LAY-IN CEILING
EG-3	TITUS 50# CORE 50	EXHAUST AIR	SEE PLAN	10 X 10	.06	35	—	NO	ALUMINUM	EXTRUDED ALUMINUM	WALL
RG-1,2	TITUS 10# CORE 10	RETURN AIR	SEE PLAN	14 X 14	.08	35	—	NO	ALUMINUM	EXTRUDED ALUMINUM	LAY-IN CEILING
TG-1 THRU TG-20	TITUS 10# CORE 10	TRANSFER AIR	—	14 X 14	.006	35	—	NO	ALUMINUM	EXTRUDED ALUMINUM	WALL

INTAKE OR EXHAUST HOOD SCHEDULE								
TAG NO.	MANUFACTURER MODEL NO. OR EQUAL	SCFM	APD (IN.WG)	APPROX. HEIGHT (IN.)	APPROX. SIZE (IN.) (THROAT)	MAXIMUM THROAT VEL. (FPM)	DAMPER	CURB



SCHEDULES

Scale: NONE Date: 2/5/08 Designer: RCD Drafter: DSD Checker: HSL Approver: HSL

NO AS-BUILT REVISIONS

REVISIONS


By: [Signature] Date: [Date]

Donohue Engineers & Architects
COMPUTER AIDED DESIGN/DRAFTING
ENGINEERS

CONTRACT DRAWINGS
HAZARDOUS WASTE STORAGE FACILITY
ANCHORAGE REGIONAL LANDFILL SITE
ANCHORAGE, ALASKA

Sheet No. 24
File No. A-50851
Project No. 15286
H-2
Drawing No.

221-7

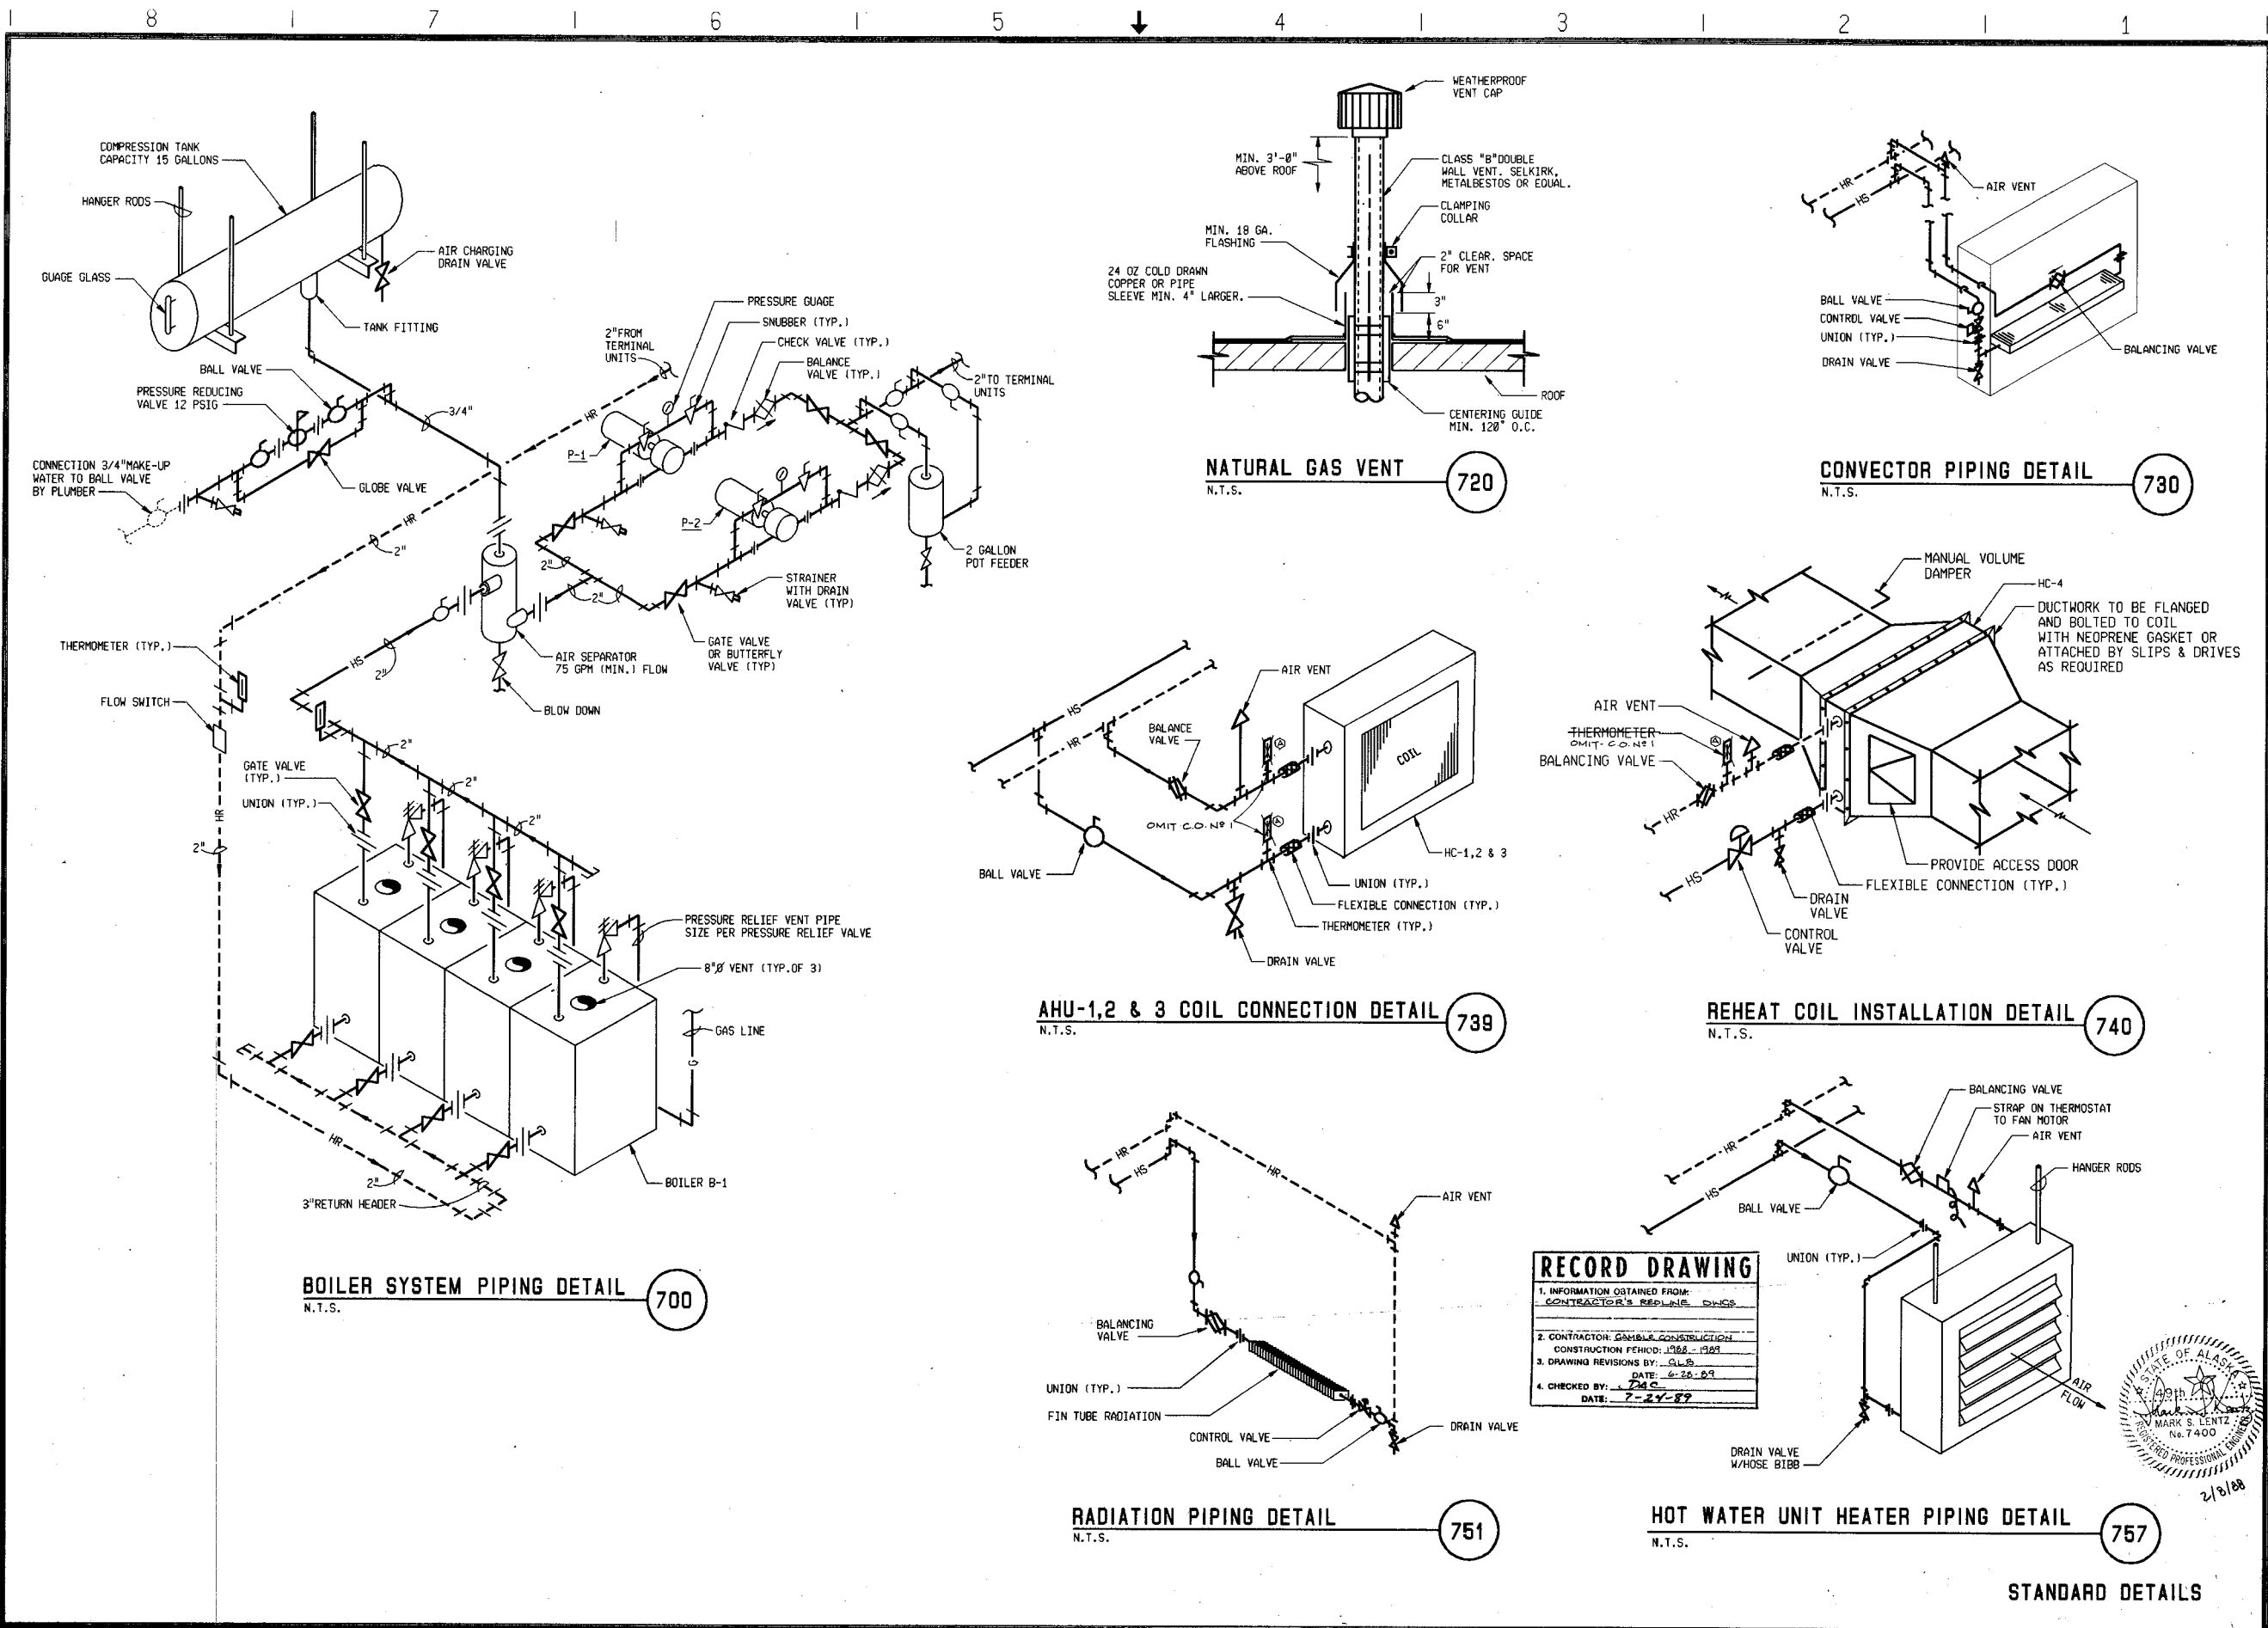


RECORD DRAWING

1. INFORMATION OBTAINED FROM:
CONTRACTOR'S RECORDS, OHS

2. CONTRACTOR: GAMBLE CONSTRUCTION
CONSTRUCTION PERIOD: 1988 - 1989

3. DRAWING REVISIONS BY: G.L.S.
DATE: 6-20-89

4. CHECKED BY: J.M.C.
DATE: 7-24-89

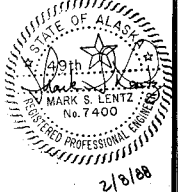

Scale	AS SHOWN	No.	Revisions	By	Date
Date	2/5/88				
Designer	RCD				
Drafter	USD				
Checker	HSL				
Approver	HSL				


Donohue
Engineers & Architects
COMPUTER AIDED DESIGN/DRAFTING
REGISTERED PROFESSIONAL ENGINEERS

CONTRACT DRAWINGS
HAZARDOUS WASTE STORAGE FACILITY
ANCHORAGE REGIONAL LANDFILL SITE
ANCHORAGE, ALASKA


Sheet No.	25
File No.	A-58868
Project No.	15286
H-3	
Drawing No.	

STANDARD DETAILS


221-6

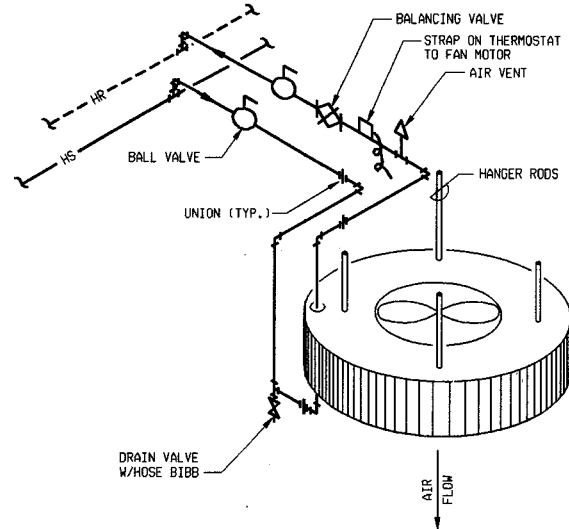


HOT WATER UNIT HEATER PIPING DETAIL 758
N.T.S.

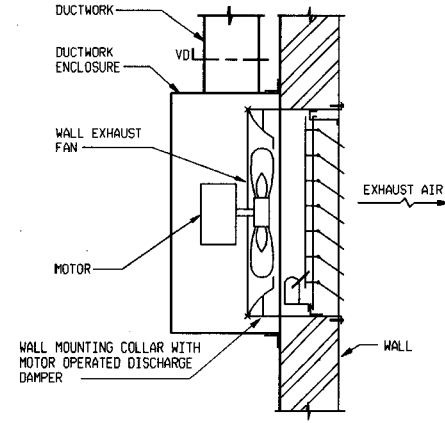


PROPELLER EXHAUST FAN DETAIL 774
N.T.S.

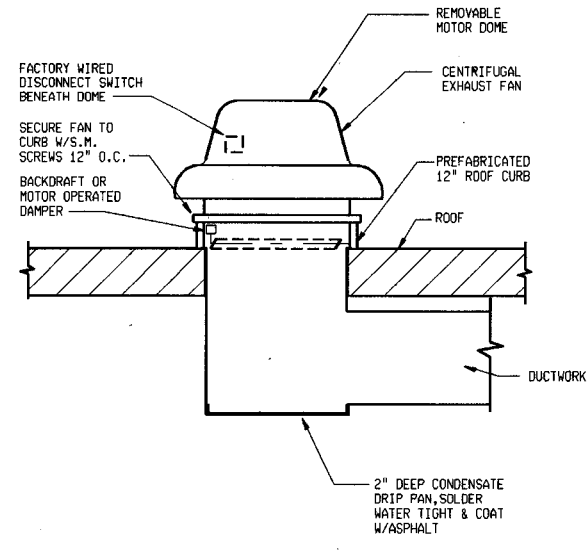


POWER ROOF EXHAUST FAN WITH DUCTWORK 775
N.T.S.

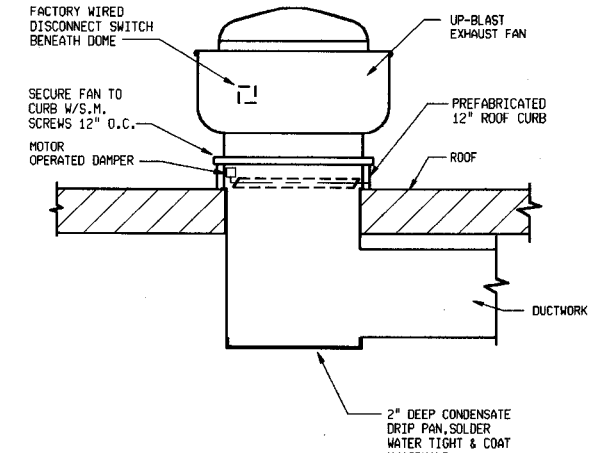


POWER ROOF EXHAUST FAN WITH DUCTWORK 778
N.T.S.

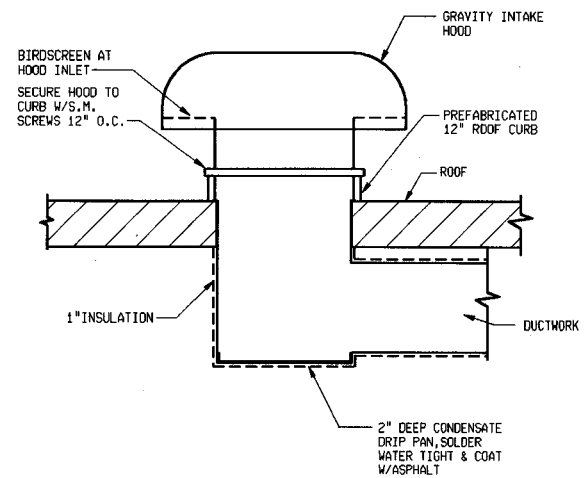


GRAVITY INTAKE HOOD WITH DUCTWORK 786
N.T.S.

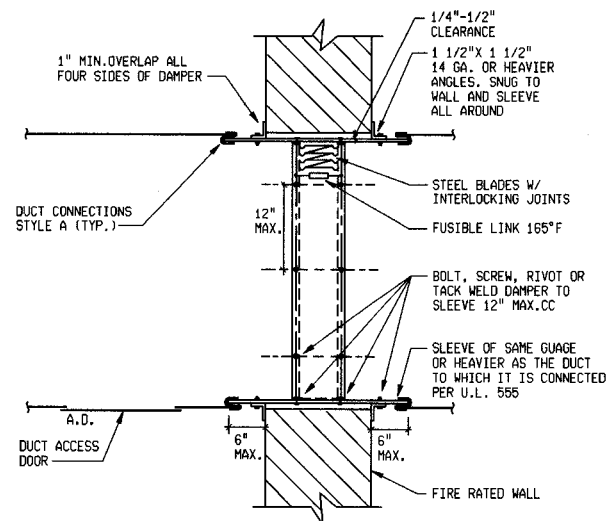


FIRE DAMPER AT WALL DETAIL 788
N.T.S.

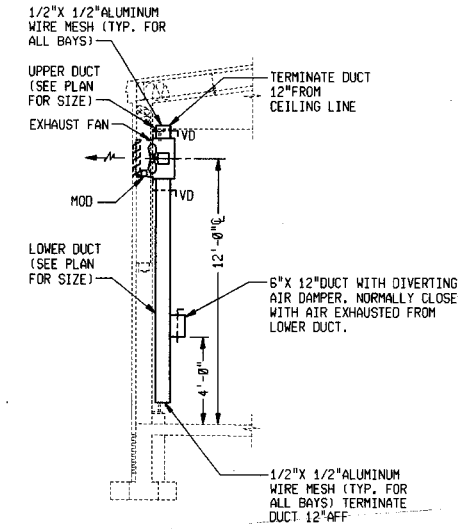

EXHAUST DUCT DETAIL 789
1/4"=1'-0"

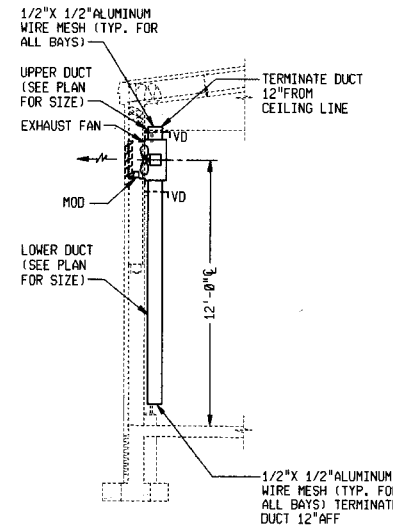

EXHAUST DUCT DETAIL 790
1/4"=1'-0"

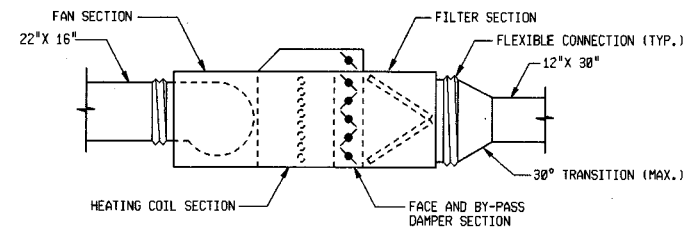

AHU-1 & AHU-2 CONFIGURATION 791
1/2"=1'-0"

RECORD DRAWING	
1. INFORMATION OBTAINED FROM:	CONTRACTOR'S RECORD BOOKS (NO REVISIONS NOTED)
2. CONTRACTOR'S CHANGE CONSTRUCTION	CONSTRUCTION PERIOD: 1988 - 1989
3. DRAWING REVISIONS BY:	DATE: 6-28-89
4. CHECKED BY:	DATE: 7-24-89



STANDARD DETAILS

AS SHOWN	Date	Designer	Checker	Approver	No.	Revisions	By	Date
	2/5/88	RD	DSO	MSL				

Donohue
Engineers & Architects
COMPUTER AIDED DESIGN/DRAFTING
REGISTERED PROFESSIONAL ENGINEERS

CONTRACT DRAWINGS
HAZARDOUS WASTE STORAGE FACILITY
ANCHORAGE REGIONAL LANDFILL SITE
ANCHORAGE, ALASKA






Sheet No.	26
File No.	A-50859
Project No.	15286
Drawing No.	H-4

221-5

DRAWING NUMBER

DATE: 8/10/88
 PLOT SCALE: 4
 PLOT NAME: H5
 (FULL SIZE)


DATE: 7-24-89
 PLOT SCALE: 4
 PLOT NAME: H5
 (FULL SIZE)

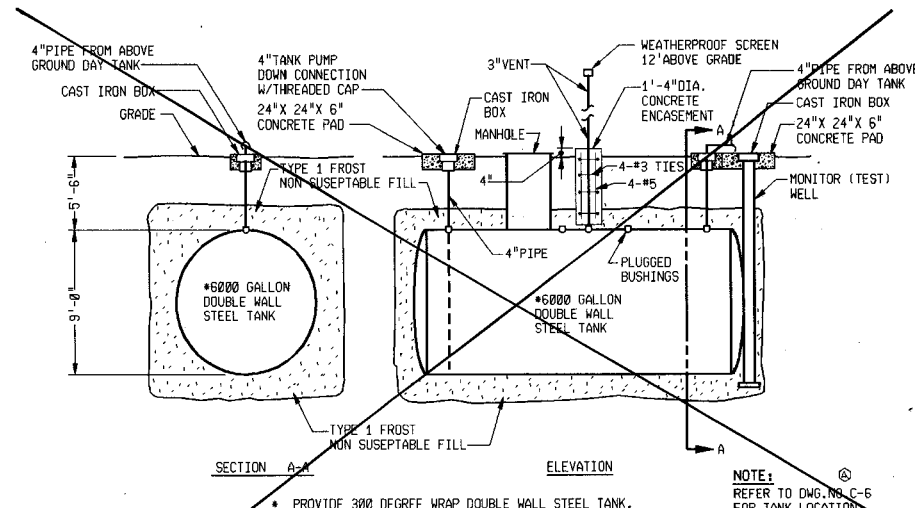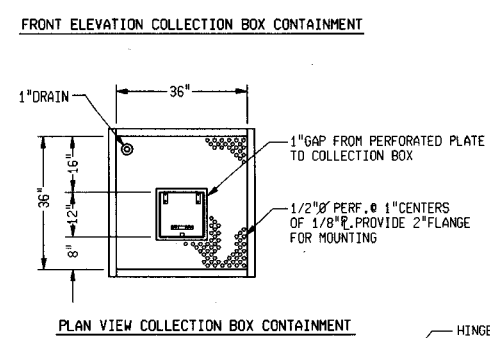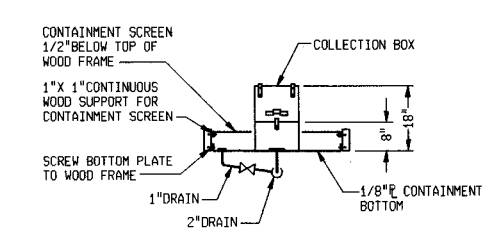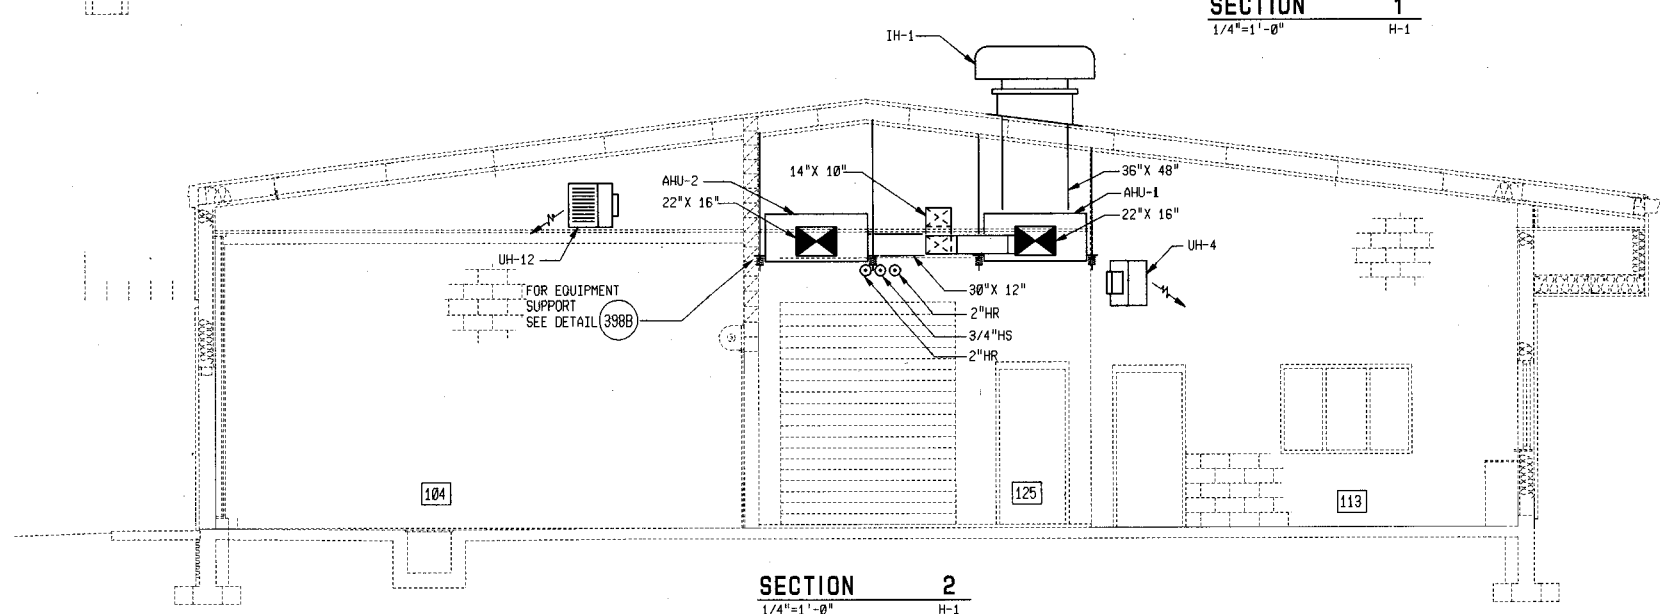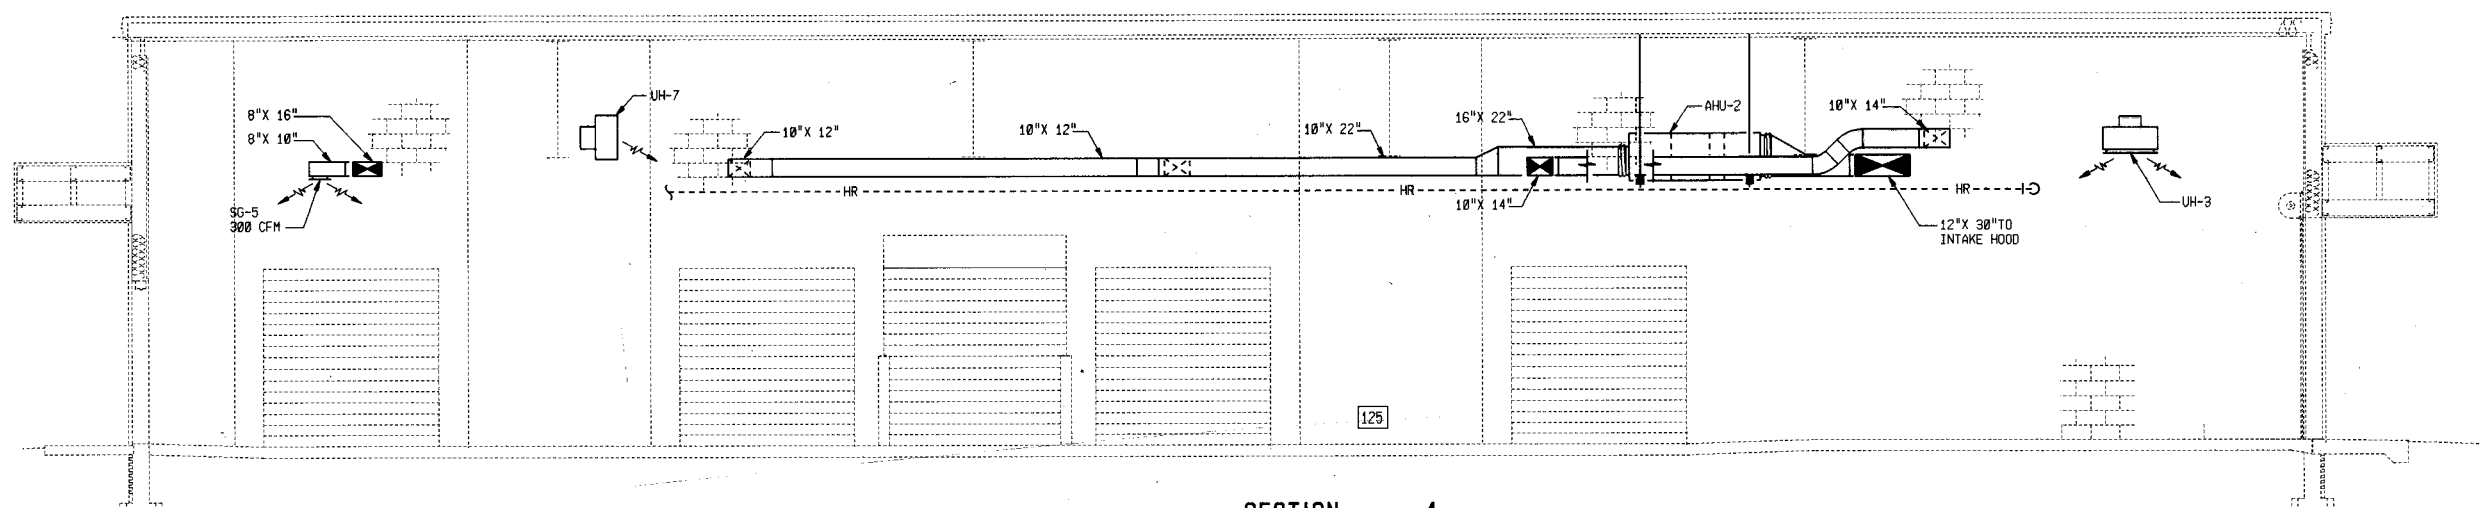


WASTE OIL UNDERGROUND STORAGE TANK 793
 NTS OMT-CO-NP1

RECORD DRAWING

- INFORMATION OBTAINED FROM: CONTRACTOR'S RECORD DRAWING
- CONTRACTOR: GAMBLE CONSTRUCTION
CONSTRUCTION PERIOD: 1982-1989
- DRAWING REVISIONS BY: G.L.B.
DATE: 6-29-89
- CHECKED BY: D.A.C.
DATE: 7-24-89

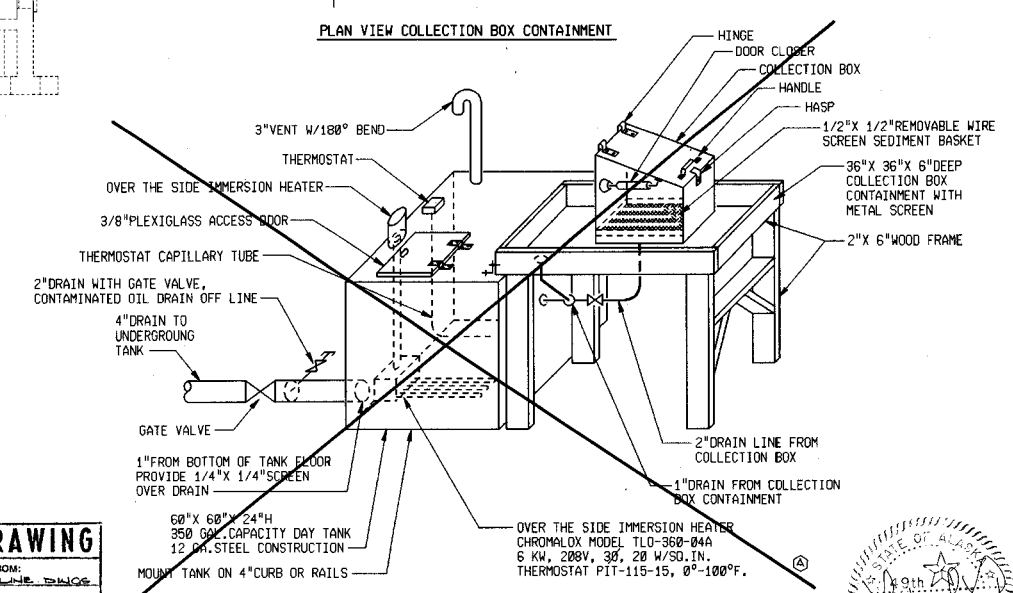

WASTE OIL DAY TANK DETAIL 792
 NTS OMT-CO-NP1

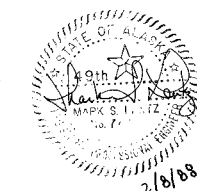


Donohue Engineers & Architects
 COMPUTER AIDED DESIGN/DRAFTING
 ENGINEERS

Scale	AS SHOWN	Date	2/5/88	Designer	RCO	Drafter	DSJ	Checker	HSL	Approver	HSL	No.	Revisions	By	Date

CONTRACT DRAWINGS
HAZARDOUS WASTE STORAGE FACILITY
ANCHORAGE REGIONAL LANDFILL SITE
 ANCHORAGE, ALASKA

Sheet No. 27
 File No. A-58858
 Project No. 15286
H-5
 Drawing No.

221-4

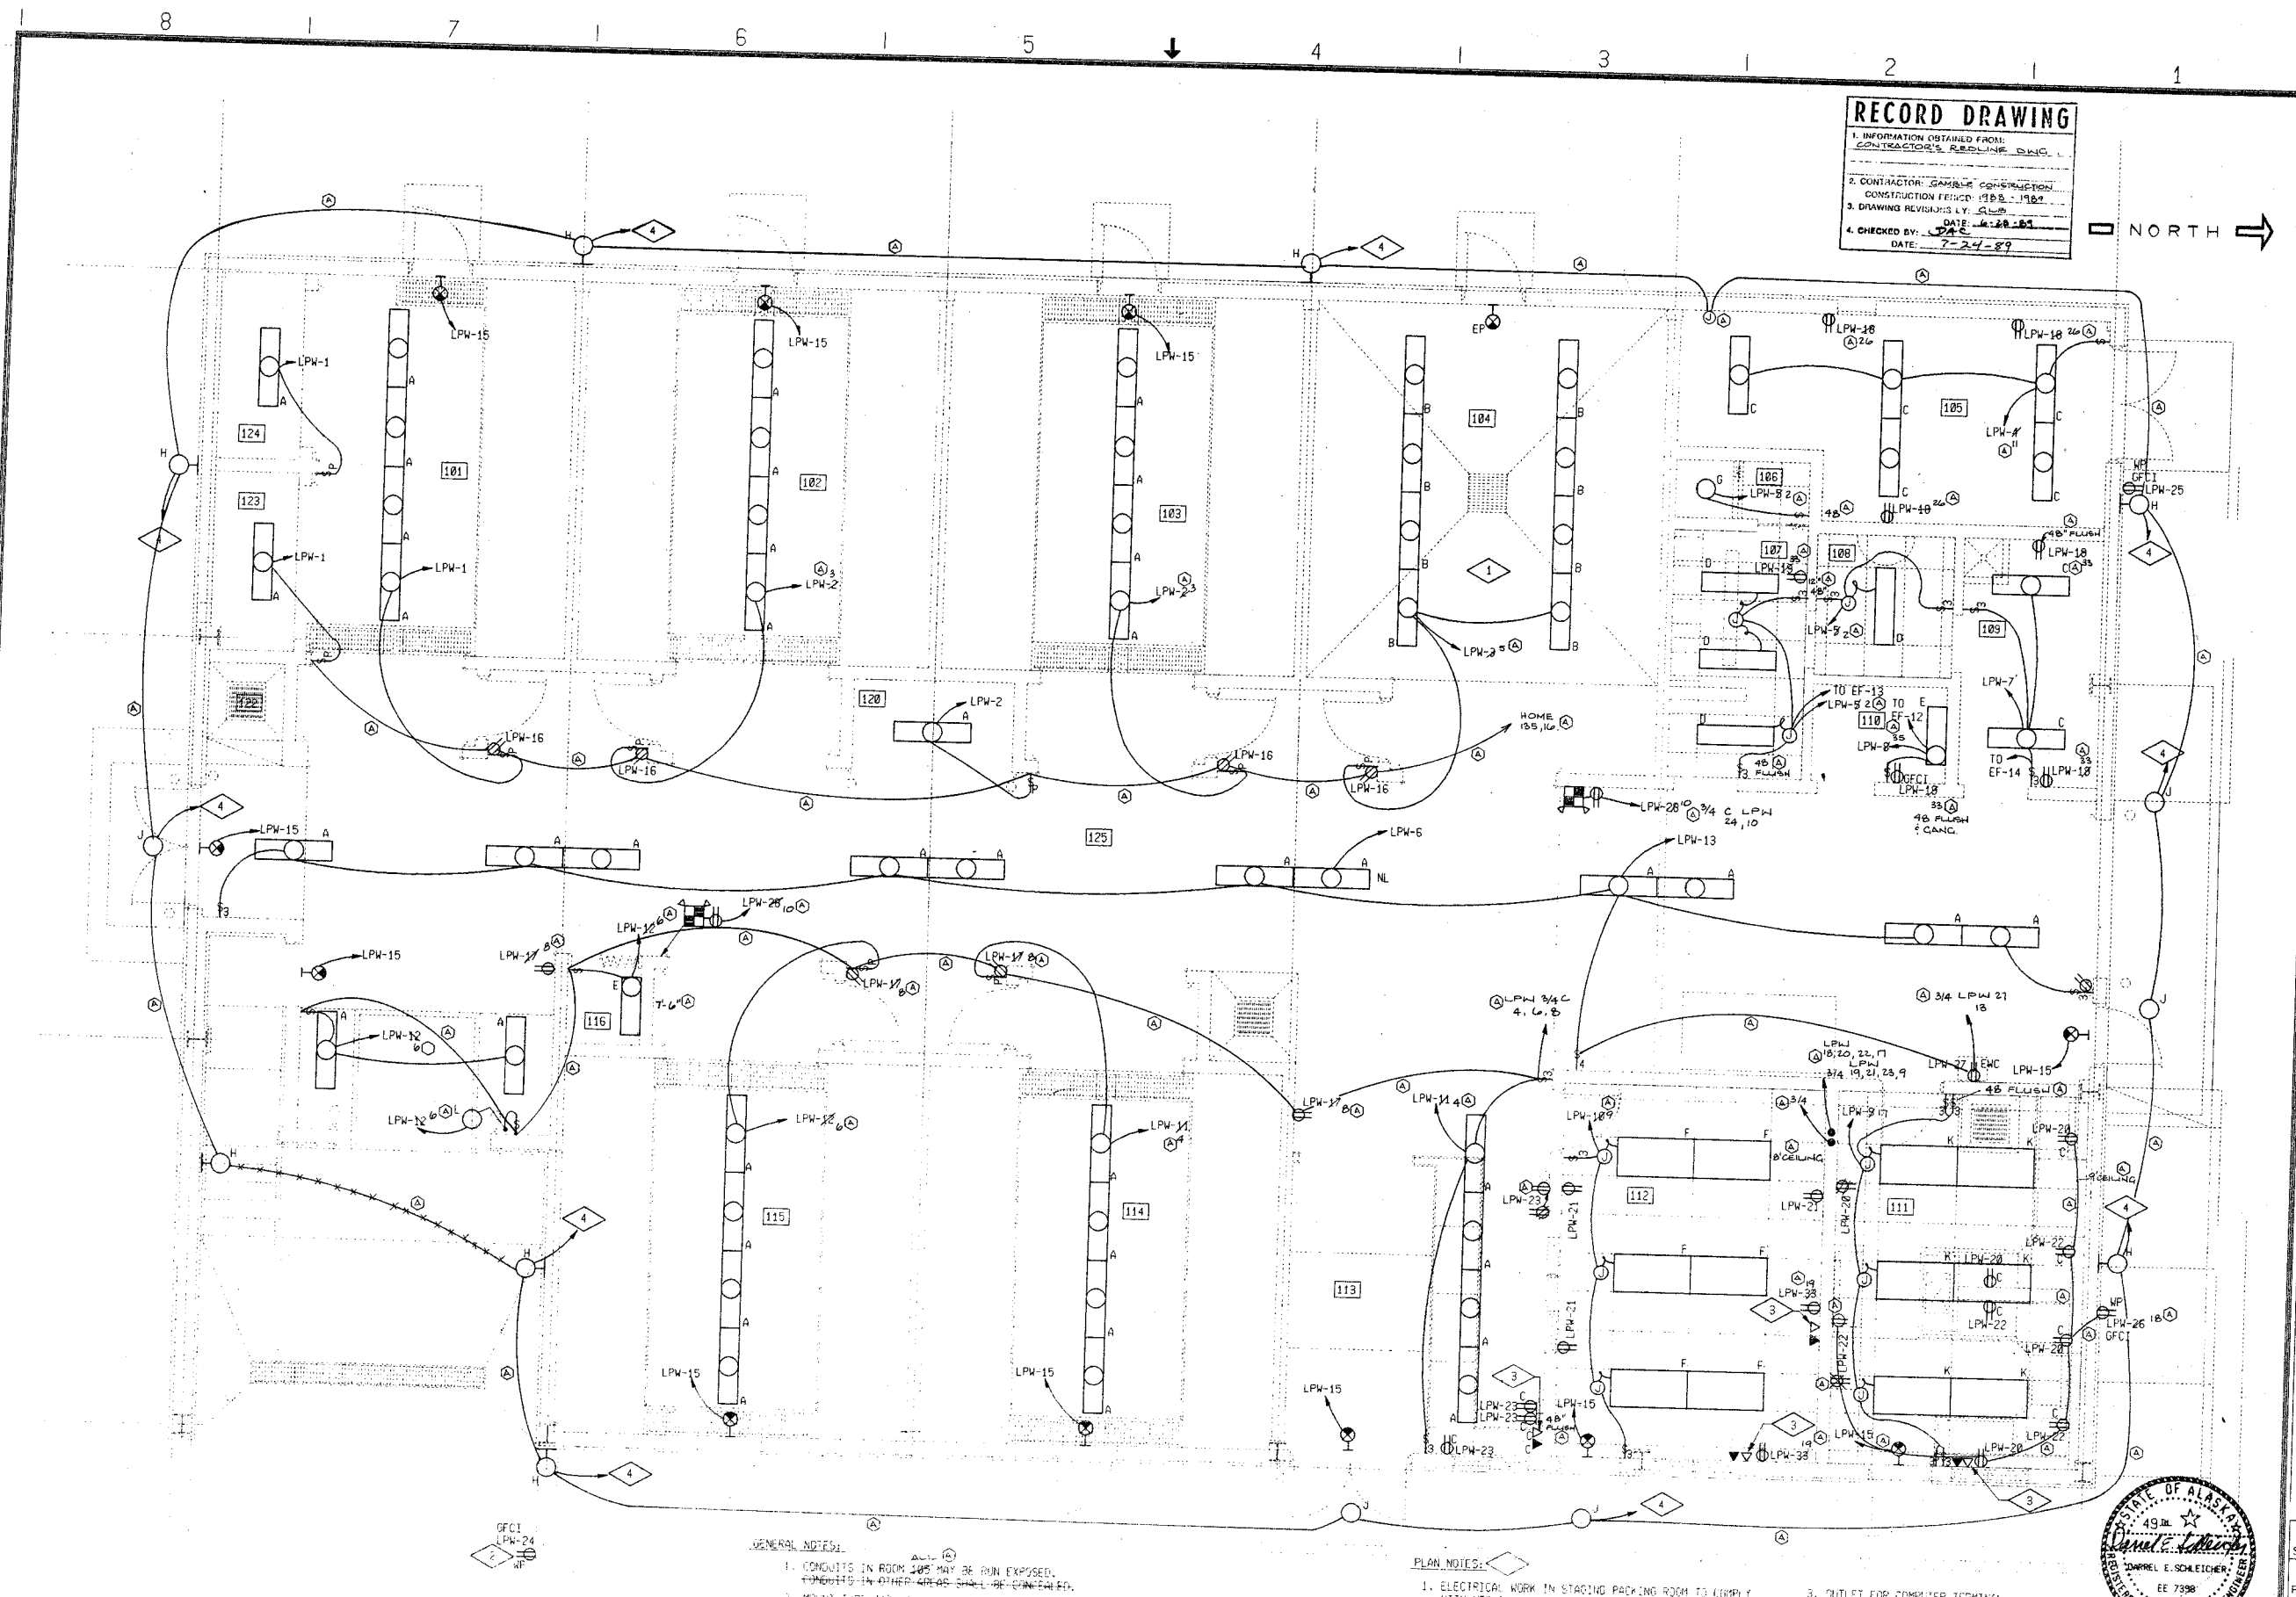

RECORD DRAWING

1. INFORMATION OBTAINED FROM:
CONTRACTOR'S REVISIONS D.W.G.

2. CONTRACTOR: GAMBLE CONSTRUCTION
CONSTRUCTION PERIOD: 1988 - 1989

3. DRAWING REVISIONS BY: CLM
DATE: 6-28-89

4. CHECKED BY: JAE
DATE: 7-24-89



REFERENCE FILES
 PL-052; L340001; BORDER; REF (LV=11-20)
 PS-052; L340001; PLM; ARC


W/P: 3/000
 PLOT SCALE: 1/4"=1'-0"
 PLOT NAME: E1
 FULL SIZE: 1/4"=1'-0"

GENERAL NOTES:

- CONDUITS IN ROOM 205 MAY BE RUN EXPOSED. CONDUITS IN OTHER AREAS SHALL BE CONCEALED.
- MOUNT TYPE 'M' FIXTURES IN ROOM 125 AT 10' W. REF.

PLAN NOTES:

- ELECTRICAL WORK IN STAGING PARKING ROOM TO COMPLY WITH NEC CLASS 1, DIVISION 1, GROUP 2 & 3 HAZARDOUS CLASSIFIED LOCATION REQUIREMENTS BELOW 5'2" AND CLASS 1, DIVISION 2 ABOVE 5'2".
- LOCATE TRUCK HEATER OUTLET 20' W. EAST OF BLDG. ON TOP OF CONCRETE CURB.
- OUTLET FOR COMPUTER TERMINAL.
- TO TIME CLOCK, SEE OUTSIDE LIGHTING RISER DIAGRAM, DRAWING E-2.

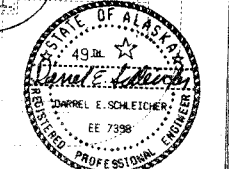

FLOOR PLAN

LIGHTING FLOOR PLAN

Donohue Engineers & Architects
 ENGINEERS

CONTRACT DRAWINGS
HAZARDOUS WASTE STORAGE FACILITY
ANCHORAGE REGIONAL LANDFILL SITE
 ANCHORAGE, ALASKA


Scale	1/4"=1'-0"
Date	2/5/88
Designer	JCM
Draftsman	MRJ
Checker	MRN
Approver	JUS
By	JAE
Date	11/29/89

Sheet No. 28
 File No. A-58957
 Project No. 15286
 Drawing No. **E-1**


221-3

REFERENCE FILES
R1=05213340001.DWG.PLAN.ARC
R2=05213340001.PLAN.ARC
R3=

NO. 8000
PLOT SCALE-4
PLOT NAME-E2
(FULL SIZE)

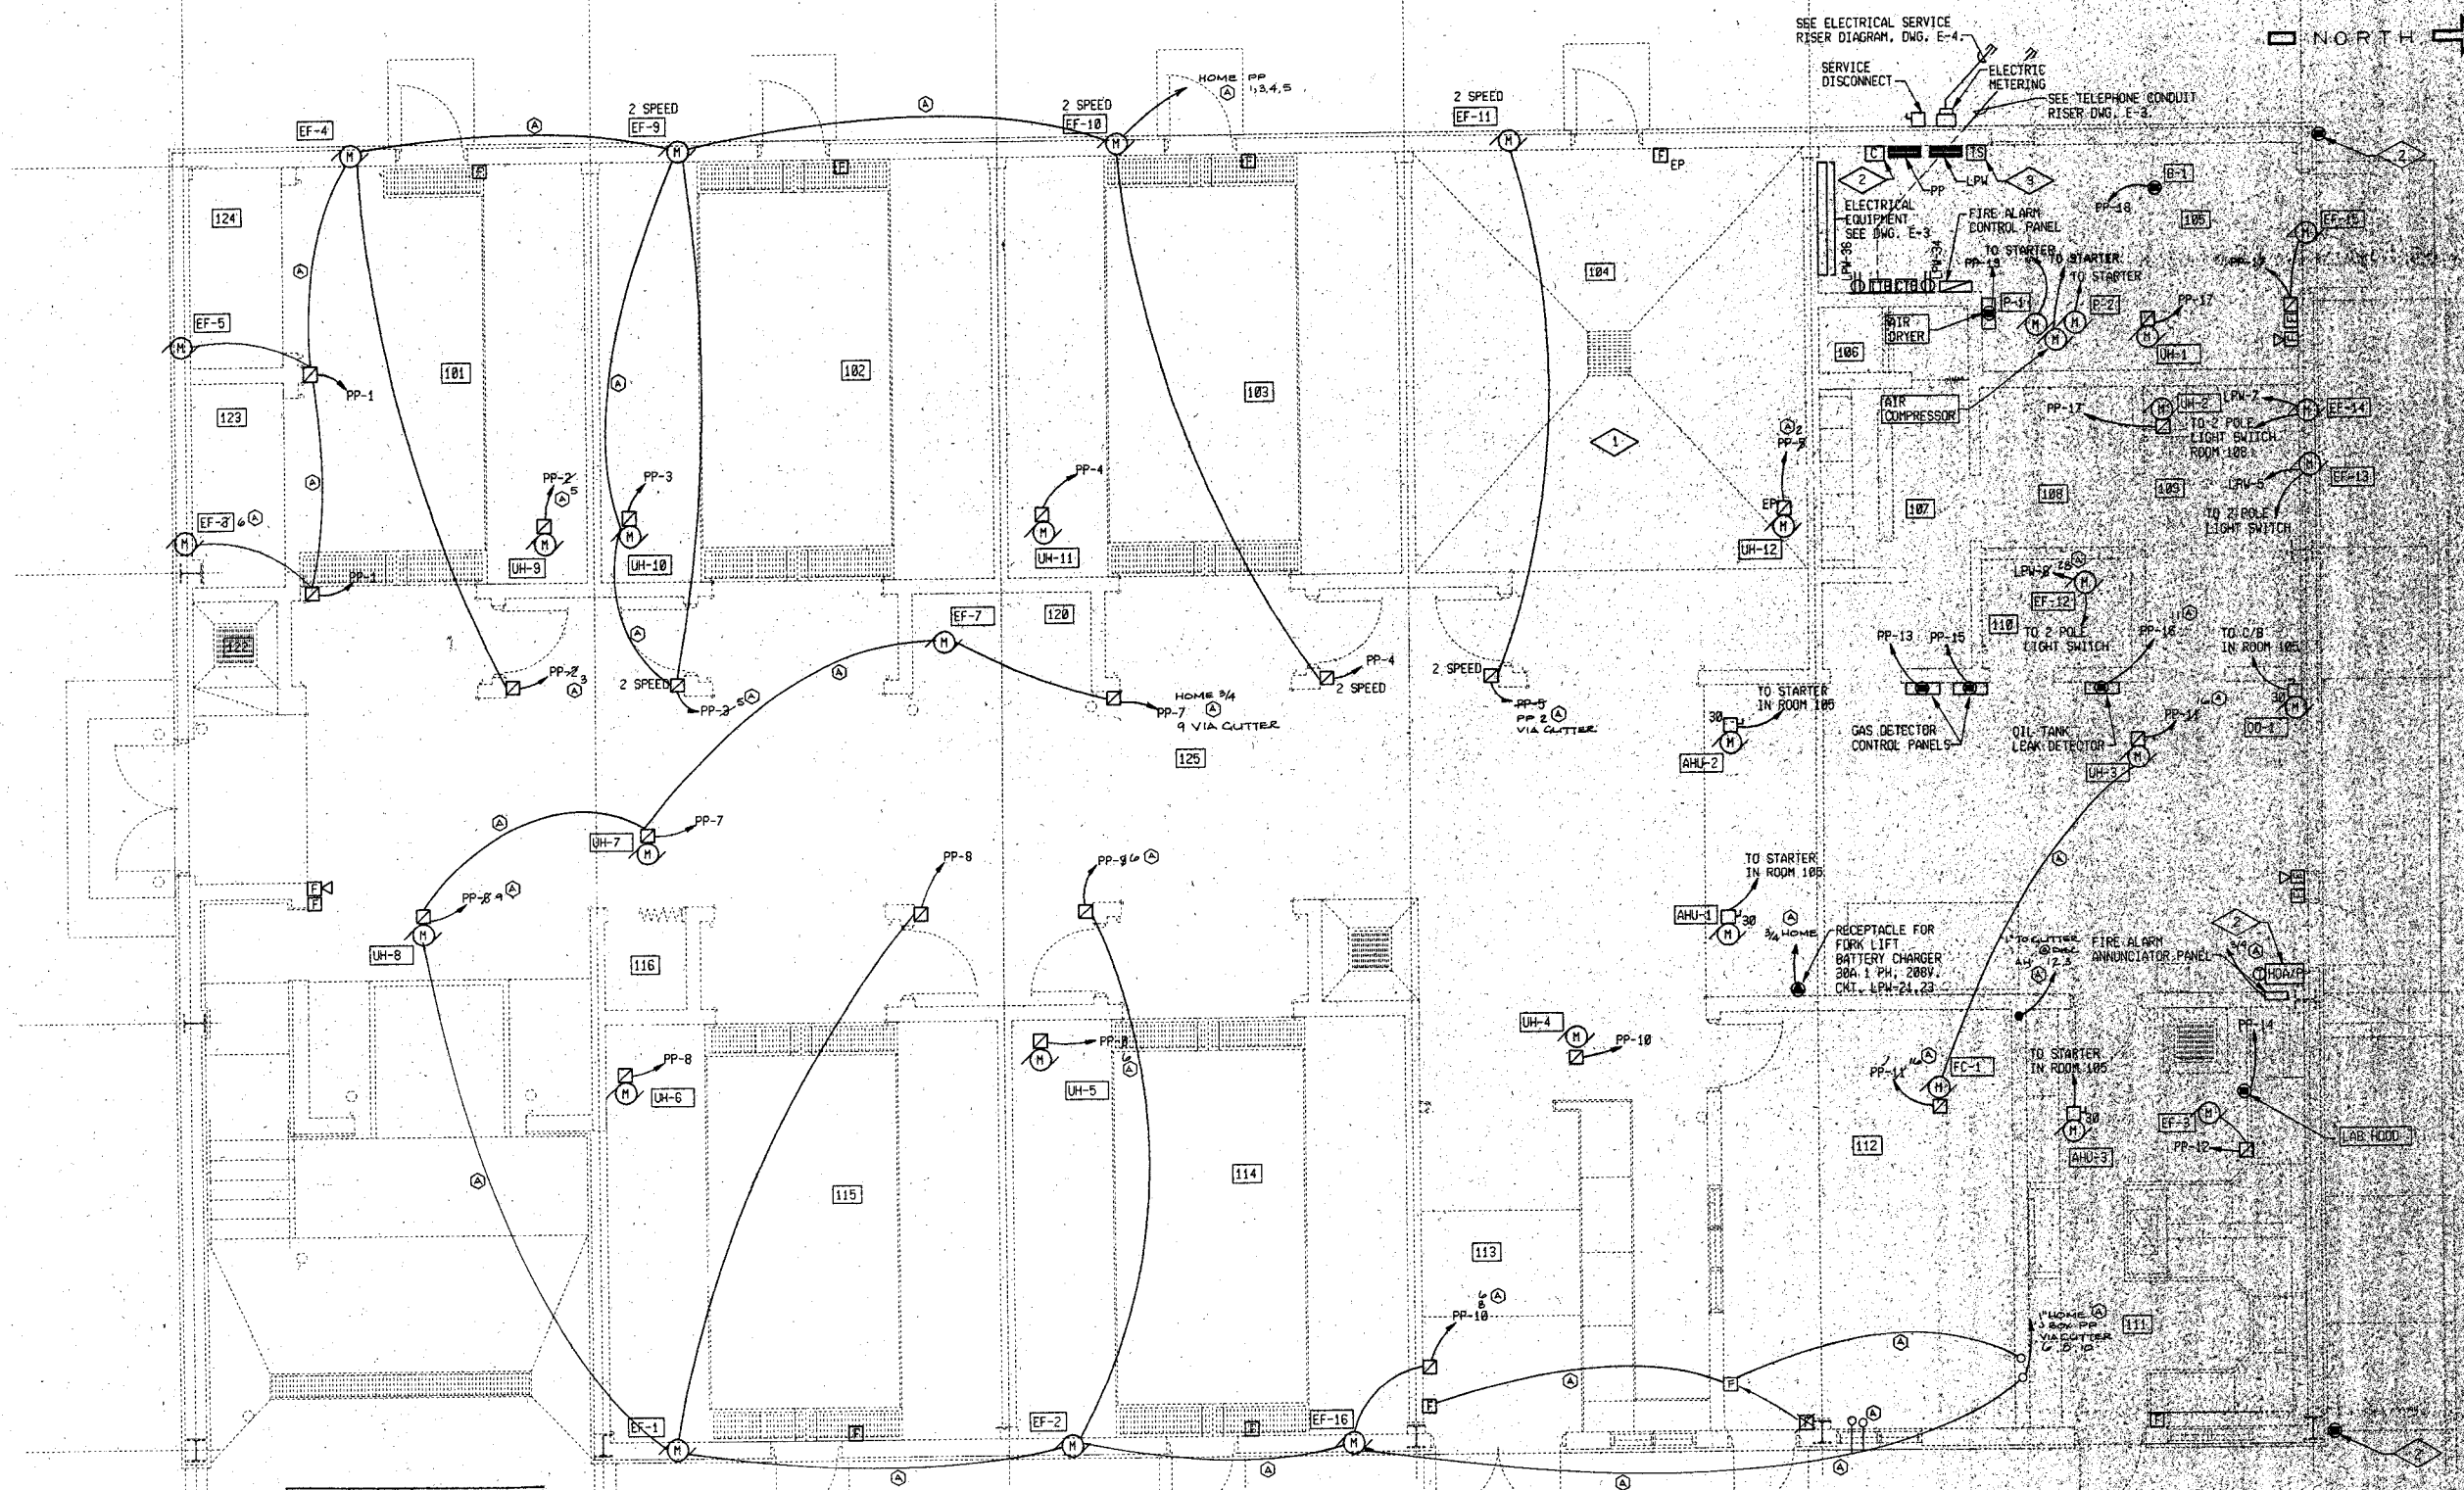

RECORD DRAWING
1. INFORMATION OBTAINED FROM:
CONTRACTORS & SUPPLIERS
2. CONTRACTOR: GAMMA CONSTRUCTION
CONSTRUCTION PERIOD: 1988-1989
3. DRAWING REVISIONS BY: GCS
DATE: 6-21-89
4. CHECKED BY: DAC
DATE: 7-24-89

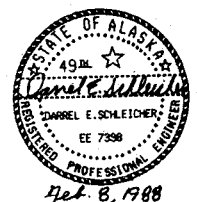

FLOOR PLAN
1/4"=1'-0"

PLAN NOTES:

- ELECTRICAL WORK IN STAGING PACKING ROOM TO COMPLY WITH NEC CLASS 1, DIVISION 1, GROUP C & D HAZARDOUS CLASSIFIED LOCATION REQUIREMENTS BELOW 8'0" AND CLASS 1, DIVISION 2 ABOVE 8'0".
- SEE GUTTER AND DOWN SPOUT HEAT TRACE RISER DIAGRAM DWG. E-2.
- TIME CLOCK, SEE OUTSIDE LIGHTING RISER DIAGRAM, DRAWING E-3.

GENERAL NOTES:

- MANUAL STARTERS TO BE MOUNTED AT 60" AFF.

POWER FLOOR PLAN

Donohue
Engineers & Architects
COMPUTER AIDED DESIGN/GRAPHICS
REGISTERED PROFESSIONAL ENGINEERS


CONTRACT DRAWINGS
HAZARDOUS WASTE STORAGE FACILITY
ANCHORAGE REGIONAL LANDFILL SITE
ANCHORAGE, ALASKA

Scale: 1/4"=1'-0"
Date: 7/27/89
Designer: JPM
Checker: JRM
Approver: JSS
By: Date

Sheet No. 29
Plot No. 4-5089
Project No. 15286
E-2
Drawing No.


DESIGN: F1VE85213340001.PLAN.P 221-3-EL01

221-2

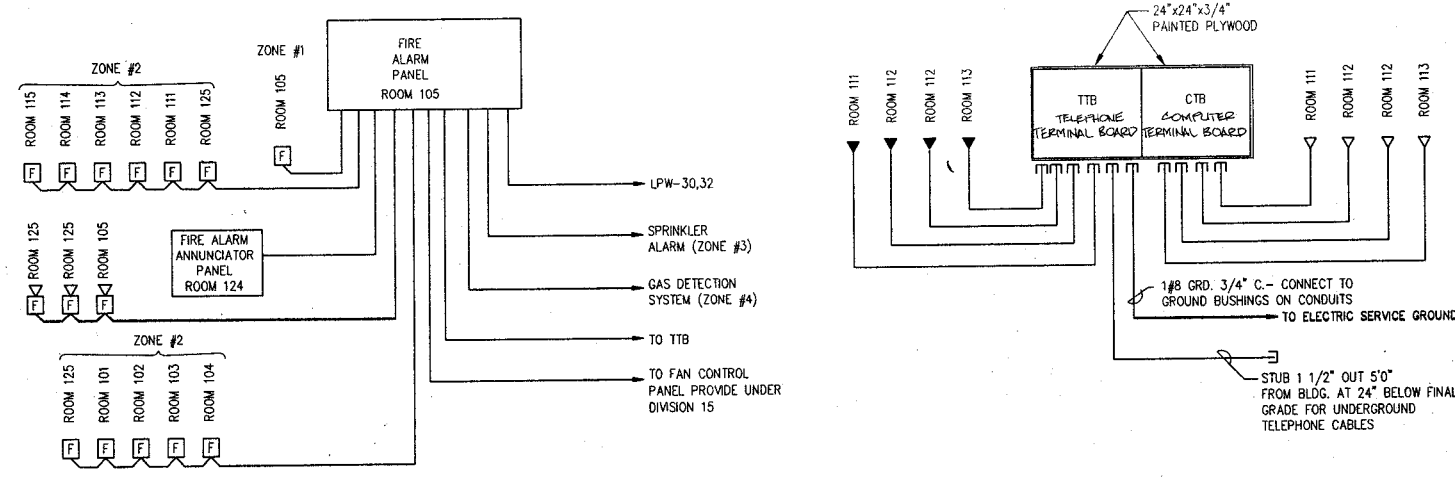


FIRE ALARM RISER

TELEPHONE CONDUIT RISER

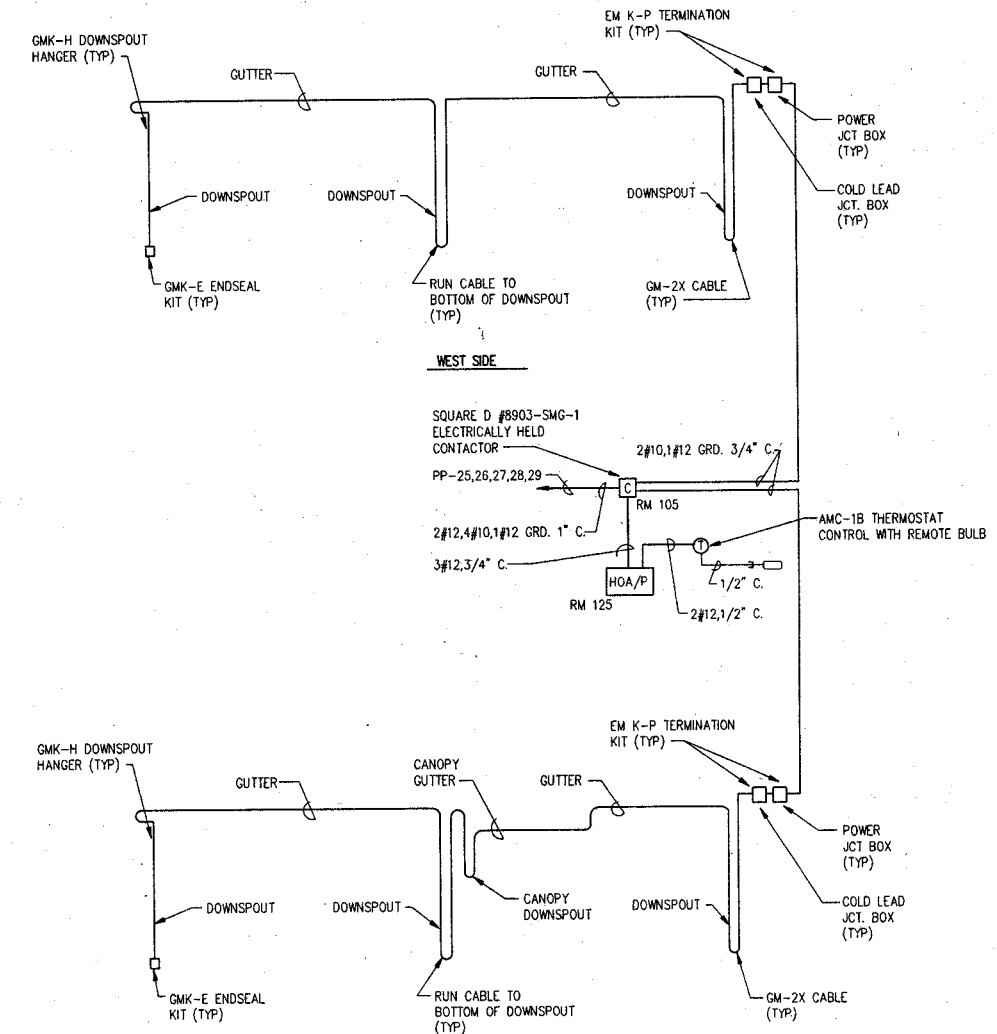

GUTTER AND DOWNSPOUT HEAT TRACE RISER DIAGRAM

LIGHTING FIXTURE SCHEDULE						
FIX. DES.	LAMPS		DESCRIPTION/CATALOG NO.	FINISH	LENS	MOUNTING
	NO.	ORD. ABB.				
A	2	F40CW	1X4 ENCLOSED AND GASKETED FLUORESCENT DAYBRITE CAT. NO. R41241 OR EQUAL	HIGH IMPACT THERMOPLASTIC	HIGH IMPACT ACRYLIC	MOUNT ON UNISTRUT CHANNEL @ 120" AFF EXCEPT AS NOTED
B	2	F40CW	1X4 ENCLOSED AND GASKETED FLUOR. SUITABLE FOR CLASS I, DIVISION 2 AREA KEENE CAT. NO. HPFVC240 OR EQUAL	-	CLEAR PLATE	MOUNT ON UNISTRUT CHANNEL @ 120" AFF
C	2	F40CW	1X4 INDUSTRIAL FLUORESCENT DAYBRITE CAT. NO. 40211W-4 OR EQUAL	WHITE POLYESTER POWDER COATING	-	SWIVEL HANGER AND STEM FOR 80" MTG. HGT.
D	2	F40CW	1X4 LAY-IN TROFFER DAYBRITE CAT. NO. CG142-C02A-120 OR EQUAL	BAKED WHITE ENAMEL	PRISMATIC ACRYLIC	RECESSED
E	2	F30T12/CW	3' WALL MOUNT FLUORESCENT DAYBRITE CAT. NO. A2230W OR EQUAL	BAKED WHITE ENAMEL	PRISMATIC ACRYLIC	WALL MOUNT @ 76" AFF
F	2	F40CW	2X4 LAY-IN TROFFER DAYBRITE CAT. NO. CG242-C02D-120 OR EQUAL	BAKED WHITE ENAMEL	PRISMATIC ACRYLIC	RECESSED
G	1	75A	INCANDESCENT SHOWER LIGHT MARKSTONE CAT. NO. WS4042 OR EQUAL	ALUMINUM	DROP WHITE GPAL	RECESSED
H	1	70LU	70W HPS WALL PACK JPL CAT. NO. WS2-P-70-120-HPF-PC OR EQUAL	DARK BRONZE ENAMEL	POLYCARBONATE	WALL MOUNT @ 120" AFF UNLESS NOTED OTHERWISE
J	1	LU70	70W HPS SURFACE MOUNT FIXTURE KENALL CAT. NO. 5320-9051 OR EQUAL	BRONZE	POLYCARBONATE	SURFACE CEILING
K	3	F40CW	2X4 LAY-IN TROFFER DAYBRITE CAT. NO. CG243-C02D-120 OR EQUAL (2 LEVEL SWITCHING)	BAKED WHITE ENAMEL	PRISMATIC ACRYLIC	RECESSED
L	1	50LU	50W HPS DOCK LIGHT HUBBEL CAT. NO. NRG-931-D60 OR EQUAL	BLACK POLYCARBONATE	GLASS	WALL MOUNT AT 76" AFF
⊠			WITH UNIT EMERGENCY BATTER LIGHT ELS CAT. NO. B12D-192-2 OR EQUAL	GRAY	-	WALL MOUNT AT 80" AFF
⊗			WITH UNIT EXIT LIGHT - 6" RED LETTERS WITH BATTERY PACK DEVINE CAT. NO. UB1200RW/DVUB180EM OR EQUAL	MATTE BLACK ENAMEL	STENCIL	DOUBLE OR SINGLE FACED ARROWS AND MTG-AS SHOWN ON PLANS
⊗			WITH UNIT SELF LUMINOUS UNIVERSAL MOUNT EXIT SIGL. ARROWS AS INDICATED. SRDI CAT. #411 OR EQUAL	ABS PLASTIC	-	WALL MOUNTED ABOVE DOOR

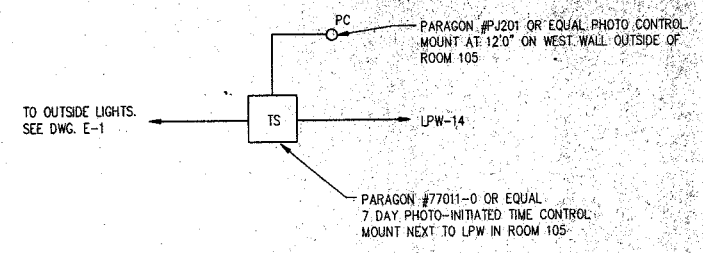

OUTSIDE LIGHTING RISER DIAGRAM


RECORD DRAWING

1. INFORMATION OBTAINED FROM: CONTRACTOR'S RECORDING DWGS (NO REVISIONS NOTED)

2. CONTRACTOR: GAMBLE CONSTRUCTION CONSTRUCTION PERIOD: MAR. 1989

3. DRAWING REVISIONS BY: GLE DATE: 6/29/89

4. CHECKED BY: DAC DATE: 7-24-89

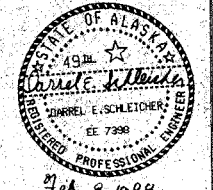

SCHEDULES AND DETAILS

Donohue
Engineers & Architects
COMPUTER AIDED DESIGN/DRAFTING
REGISTERED PROFESSIONAL ENGINEERS

CONTRACT DRAWINGS
HAZARDOUS WASTE STORAGE FACILITY
ANCHORAGE REGIONAL LANDFILL SITE
ANCHORAGE, ALASKA


Scale: NINE
Date: 7/5/88
Designer: JAM
Draftsman: MKJ
Checker: MKW
Approver: DAS

NO AS-BUILT REVISIONS
By: []
Date: []

Sheet No. []
File No. []
Project No. []
Drawing No. **E-3**

DESIGN FILE
221-2
JUL 21 1988

221-1

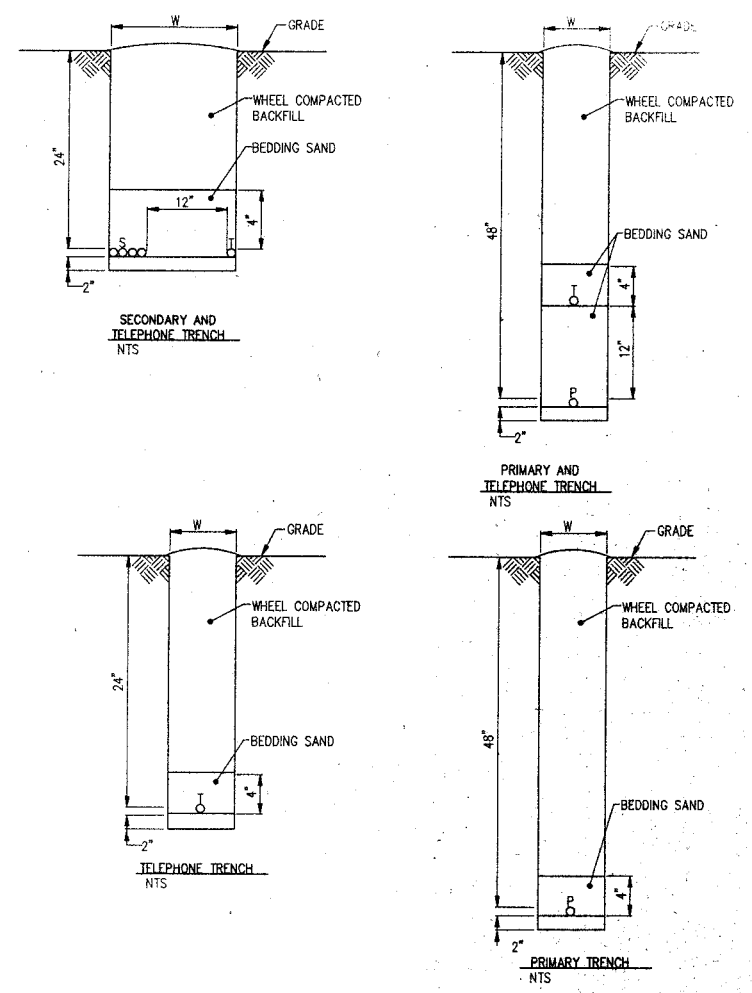

TRENCH DETAILS
NTS


SURFACE MOUNTED
120 / 208 V, 3 PHASE, 4 WIRE

CKT. NO.	TRIP/P	DESCRIPTION	PHASE			DESCRIPTION	TRIP/P	CKT. NO.
			A	B	C			
1	20/1	EF-5, EF-6	390			EF-4, UH-9	20/1	2
3	20/1	EF-9, UH-10	840			EF-10, UH-11	20/1	4
5	20/1	EF-11, UH-12	710			UH-8 EF #2 UH #6	20/1	6
7	20/1	EF-7, UH-7	370			EF-1, UH-6	20/1	8
9	20/1	EF-2, UH-5 UH #8	710			EF-16, UH-4	20/1	10
11	20/1	UH-3 FC-1 OIL TANK LEAK DET.	305			EF-3	20/1	12
13	20/1	GAS DETECTOR	250			LAB HOOD	20/1	14
15	20/1	GAS DETECTOR CONTROL PANEL	250			OIL TANK LEAK DETECTOR UH # FC-1	20/1	16
17	20/1	UH-2, UH-3, EF-15	755			BOILER B-1	20/1	18
19	20/1	AIR DRYER	250			SPARE	20/1	20
21	30/2	BATTERY CHARGER	2000			SPARE	20/1	22
23	30/2	BATTERY CHARGER	2000			SPARE	20/1	24
25	30/2	EAST GUTTER HEAT TRACE	1000			WEST GUTTER HEAT TRACE	30/2	26
27	1	EAST GUTTER HEAT TRACE	1000			WEST GUTTER HEAT TRACE	1	28
29	20/1	GUTTER HEAT TRACE CONTROL	250			SPARE	20/1	30
31			6670					32
33	100/3	FEEDER TO PANEL LPW	5770			OVERHEAD DOOR OPERATOR	15/3	34
35			500					36
37			14374					38
39	225/3	FEEDER TO 208V WIREWAY	14374			BLANK		40
41			26714	28244	25504			42

TOTAL LOAD = 805 KVA

SURFACE MOUNTED
120 / 208 V, 3 PHASE, 4 WIRE

CKT. NO.	TRIP/P	DESCRIPTION	PHASE			DESCRIPTION	TRIP/P	CKT. NO.
			A	B	C			
1	20/1	LIGHTING RMS. 101, 123, 124	600			LIGHTING RMS. 102, 103, 120	20/1	2
3	20/1	LIGHTING RM. 104-102, 103, 120	800			LIGHTING RM. 106-113, 114	20/1	4
5	20/1	LIGHTING RM. 106, 107, 108, EF-13	500			NIGHT LIGHT RM. 125	20/1	6
7	20/1	LIGHTING RM. 109, EF-14 13	400			LIGHTING RM. 110, EF-12 RECEPT.	20/1	8
9	20/1	LIGHTING RM. 111	600			LIGHTING RM. 112-BAH, LTC	20/1	10
11	20/1	LIGHTING RMS. 113, 114-105	800			LIGHTING RMS. 115, 116 LOAD DOCK	20/1	12
13	20/1	LIGHTING RM. 125	1000			OUTSIDE LIGHTING	20/1	14
15	20/1	EXIT LIGHTING	560			RECEPTACLES RM. 125	20/1	16
17	20/1	RECEPTACLE RM. 125 LTC RM. 112	720			RECEPTACLES RM. 105-EXTERIOR	20/1	18
19	20/1	RECEPTACLES RM. 107, 109, 110	900			RECEPTACLES RM. 111	20/1	20
21	20/1	RECEPTACLES RM. 112	360			RECEPTACLES RM. 111	20/1	22
23	20/1	RECEPTACLES RM. 113	720			RECEPTACLES RM. 111	20/1	24
25	20/1	EXTERIOR RECEPTACLE	300			EXTERIOR RECEPTACLE 105	20/1	26
27	20/1	EWV RECEPTACLE	200			BATTERY LIGHTS	20/1	28
29	20/1	SPARE	100			FACE	20/1	30
31	20/1	SPARE	250			FACE	20/1	32
33	20/1	RECEPTACLES RM. 112-109, 107, 110	360			RECEPTACLE CTB	20/1	34
35	20/1	SPARE	250			RECEPTACLE TTB	20/1	36
37		SPACE				SPACE		38
39		SPACE				SPACE		40
41		SPACE				SPACE		42

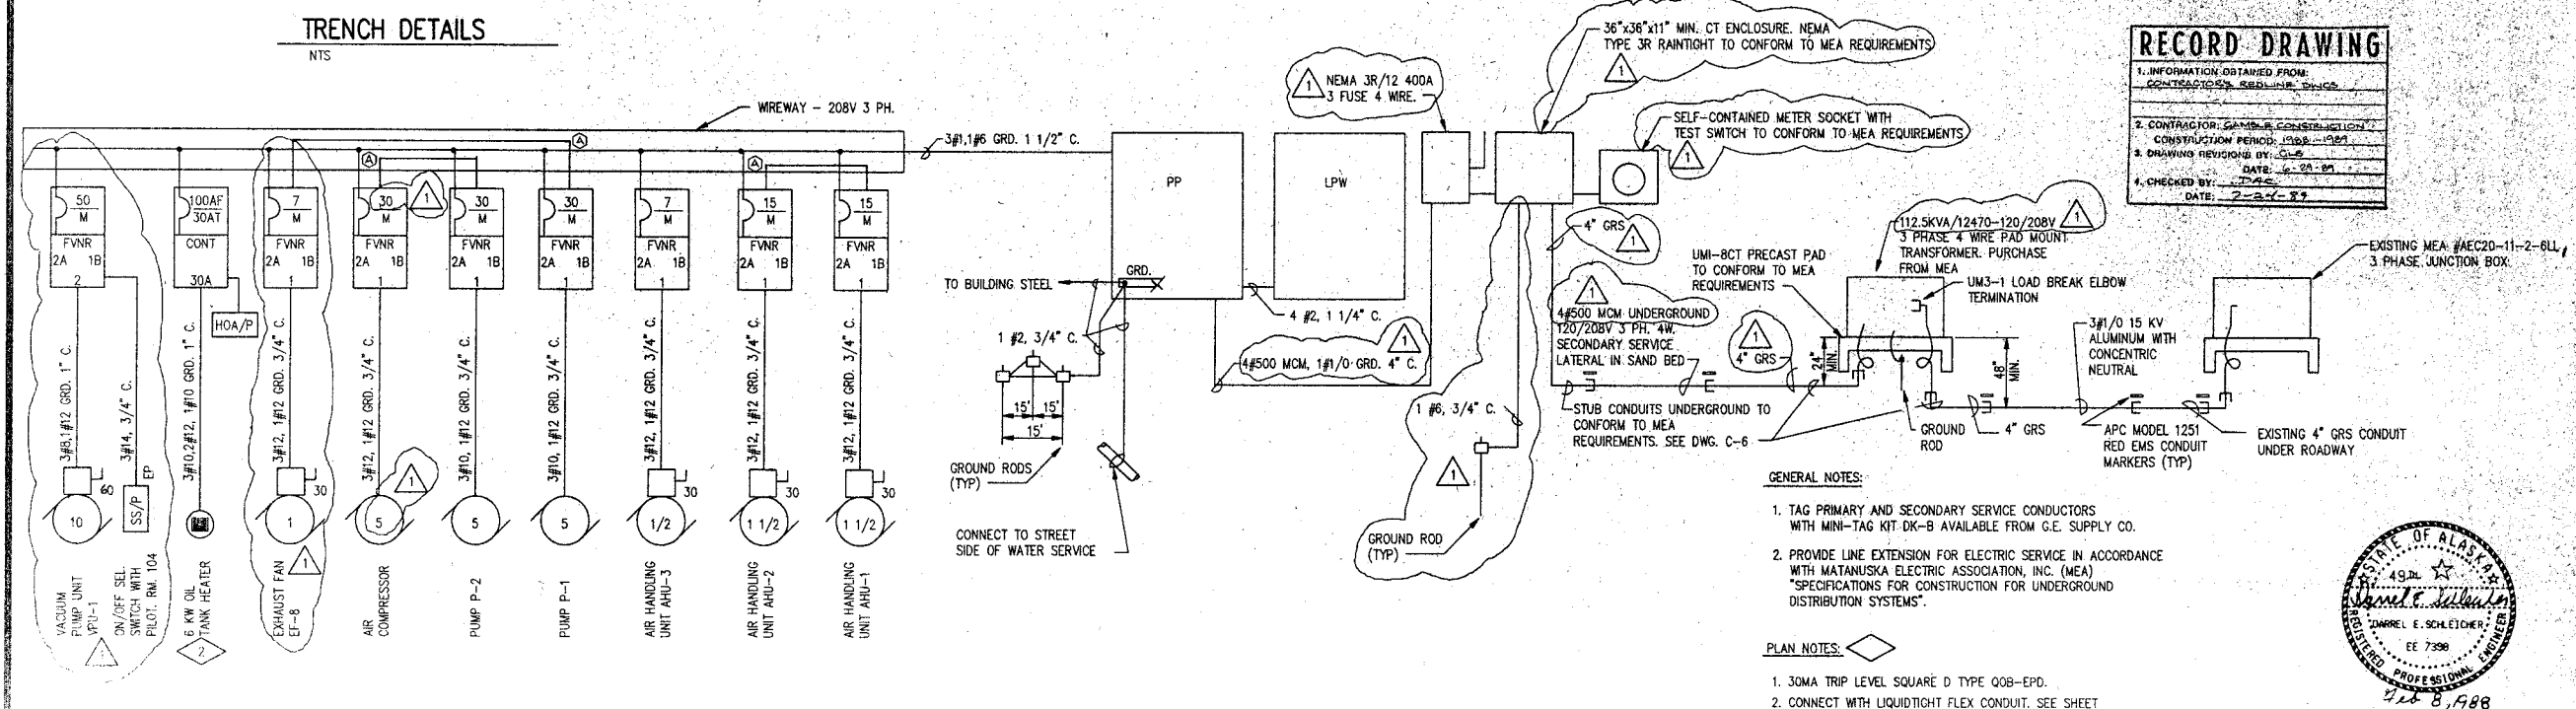

DISTRIBUTION ONE-LINE DIAGRAM & ELECTRICAL SERVICE RISER DIAGRAM

RECORD DRAWING

1. INFORMATION OBTAINED FROM:
CONTRACT NO. 58-1-10-3-10

2. CONTRACTOR: GAMBRE CONSTRUCTION


3. CONSTRUCTION PERIOD: 1968-1969

4. DRAWING REVISIONS BY: GLE
DATE: 10-28-89

5. CHECKED BY: TAE
DATE: 2-24-89

- GENERAL NOTES:**
- TAG PRIMARY AND SECONDARY SERVICE CONDUCTORS WITH MINI-TAG KIT DK-B AVAILABLE FROM G.E. SUPPLY CO.
 - PROVIDE LINE EXTENSION FOR ELECTRIC SERVICE IN ACCORDANCE WITH MATANUSKA ELECTRIC ASSOCIATION, INC. (MEA) "SPECIFICATIONS FOR CONSTRUCTION FOR UNDERGROUND DISTRIBUTION SYSTEMS".

- PLAN NOTES:**
- 30MA TRIP LEVEL SQUARE D TYPE QOB-EPD.
 - CONNECT WITH LIQUIDTIGHT FLEX CONDUIT. SEE SHEET C-6 FOR LOCATION.

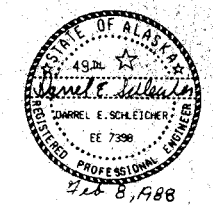

Donohue
Engineers & Architects
COMPUTER AIDED DESIGN/DRIFTING

CONTRACT DRAWINGS
HAZARDOUS WASTE STORAGE FACILITY
ANCHORAGE REGIONAL LANDFILL SITE
ANCHORAGE, ALASKA

Scale	NONE	Date	2/5/88	Designer	JOM	Checker	MRW	Approver	DJS	Revisions	By	Date

Sheet No. 31
File No. A-50854
Project No. 15266
Drawing No. E-4

DESIGN FILE 221-1