


0 1 2 MI. 4 MI.

VERIFY SCALES
BAR IS ONE INCH ON ORIGINAL DRAWING
0 1"
IF NOT ONE INCH ON THIS SHEET, ADJUST SCALES ACCORDINGLY

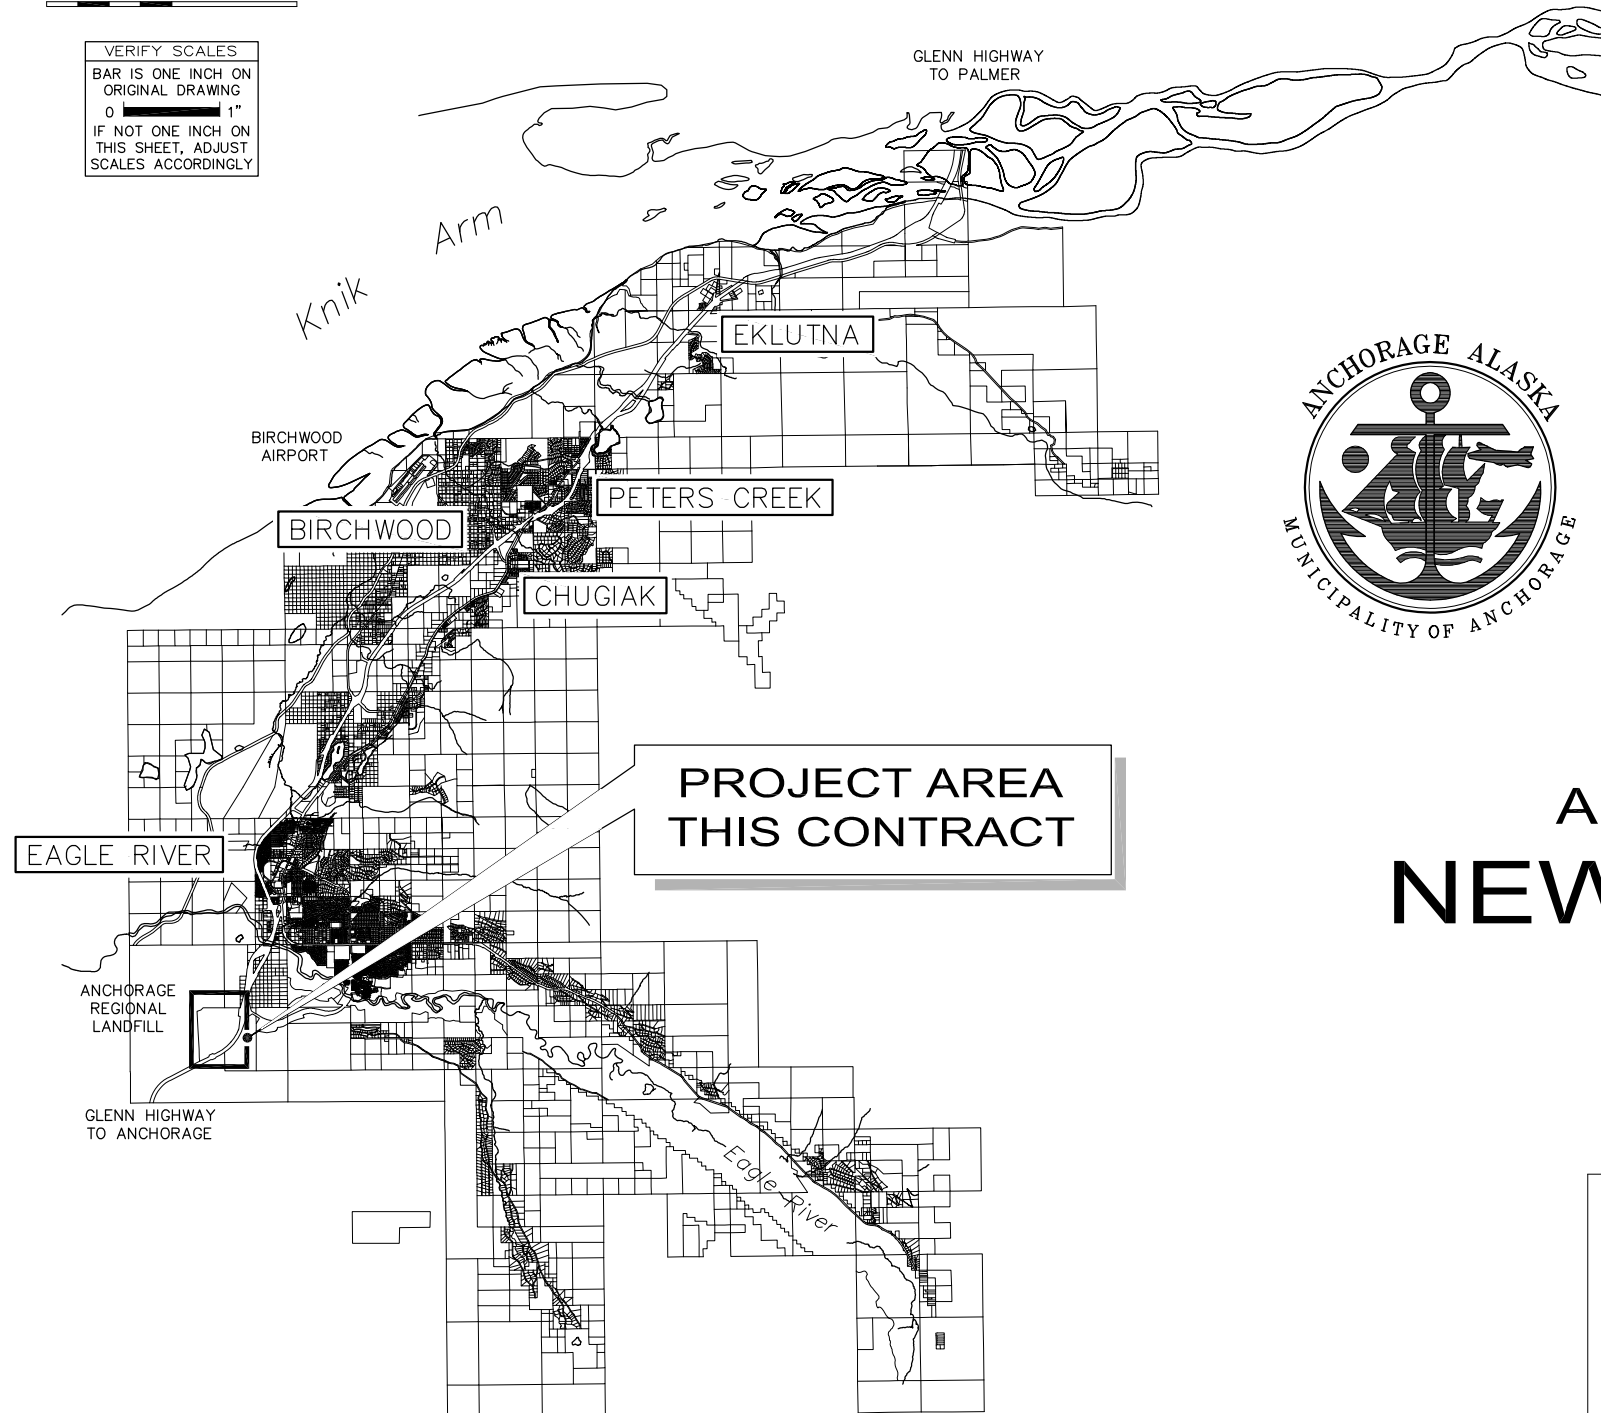

MUNICIPALITY OF ANCHORAGE SOLID WASTE SERVICES

Eagle River, Alaska




ANCHORAGE REGIONAL LANDFILL NEW RECYCLING CENTER

May, 2009

DRAWING INDEX

Sheet No.	Title
1	Cover Sheet
2	Site Plan
3	Sections & Details
4	Gate Detail
5	Electrical Site Plan & Power One Line
6	Electrical Details & Panel Schedule
7	Electrical Details



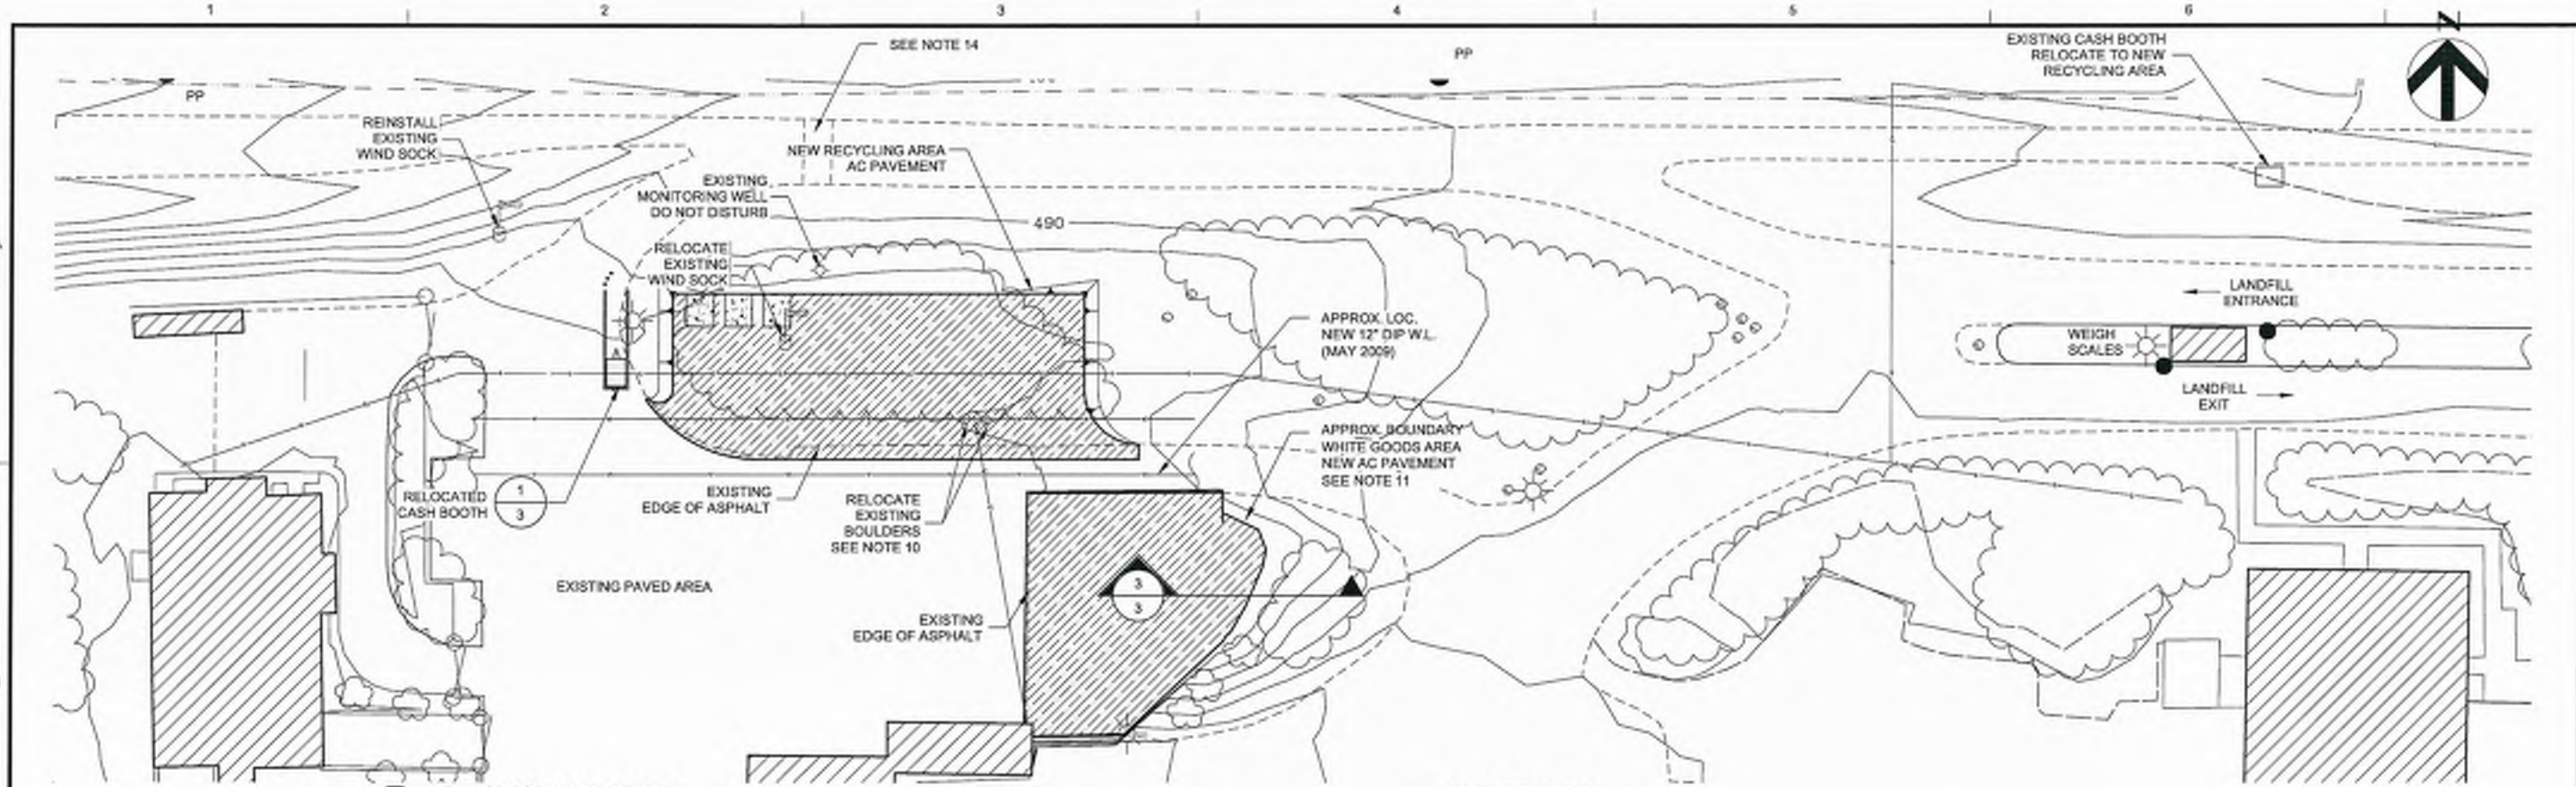

NOTES:

- CONTRACTOR TO MATCH EXISTING DRAINAGE PATTERNS ON NEW SURFACES, EXCEPT WHERE NOTED TO IMPROVE.
- CONTRACTOR SHALL COORDINATE ALL WORK WITH OWNER TO ENSURE THAT LANDFILL OPERATIONS ARE NOT INTERRUPTED.
- ALL SITE WORK SHALL CONFORM TO APPLICABLE FEDERAL, STATE, AND LOCAL REGULATIONS.
- CONTRACTOR IS RESPONSIBLE FOR SAFETY AND TRAFFIC CONTROL WITHIN THE AREAS OF WORK SHOWN.
- THE CONTRACTOR SHALL REPAIR OR REPLACE ALL DAMAGED ITEMS TO EXISTING CONDITIONS AT NO COST TO THE OWNER.
- TRANSPORT EXCAVATED MATERIAL TO ON SITE AREA DESIGNATED BY THE OWNER.
- PRIOR TO PLACEMENT OF PERMANENT PAVING, EXISTING PAVEMENT SHALL BE SAW CUT OR WHEEL CUT THROUGH INTACT ASPHALT IN A NEAT STRAIGHT LINE. CRACKED PAVEMENT OUTSIDE THE LIMITS OF CUTTING WHICH RESULT FROM THE CONTRACTORS WORK SHALL BE REMOVED AND REPLACED AT NO ADDITIONAL COST.
- TACK COAT ALL ASPHALT EDGE CUTS PRIOR TO PAVING ACTIVITY.
- SURVEY CONTROL IS PER ANCHORAGE REGIONAL LANDFILL GRID. SEE SPECIFICATIONS FOR CONTROL DATA.
- RELOCATE EXISTING BOULDERS TO LOCATION DESIGNATED BY OWNER. LOCATION NOT TO OBSTRUCT OR INTERFERE WITH SNOW REMOVAL.
- PAVE WHITE GOODS AREA TO LIMITS DETERMINED BY THE FIELD ENGINEER. SLOPE TO DRAIN.
- SCHEDULE PAVING WORK WITH AWWU WATERLINE PROJECT UNDER CONSTRUCTION MAY 2009.
- TOP OF CONCRETE PADS TO MATCH TOP OF A.C. PAVEMENT. PADS TO BE 6" THICK, 3000 PSI CONCRETE REINFORCED WITH #4 BARS @ 12" O.C. REINFORCEMENT SHALL HAVE 2" MIN COVER ON ALL SIDES. 3/4" ANCHOR BOLTS SHALL BE CORROSION RESISTANT, EXTENDED THROUGH FULL PAD THICKNESS AND LOCATED PER MANUFACTURERS REQUIREMENTS.
- CUT & PATCH EXISTING PAVEMENT AS REQUIRED FOR ELECTRICAL SERVICE.

VERIFY SCALE		RECORD DRAWING	
DATE	BY	DATE	BY
BASE		CONTRACTOR	
TOPOGRAPHY		BY:	TITLE:
PROFILE		DATE:	
SANITARY SEWER		DATA TRANSFERRED BY:	
STORM SEWER		COMPANY:	
WATER		DATE:	
GAS			
PLAN CHECK		REVISIONS	

RECORD DRAWING Note: To be filled out on original drawings upon project completion.

1. DATA PROVIDED BY: _____
 This will serve to certify that these Record Drawings are a true and accurate representation of the project as constructed.

CONTRACTOR: _____
 BY: _____ TITLE: _____
 DATE: _____

2. DATA TRANSFERRED BY: _____
 COMPANY: _____
 DATE: _____

3. Based on periodic field observations by the Engineer (or an individual under his/her direct supervision), the Contractor-provided data appears to represent the project as constructed.

DATA TRANSFER CHECKED BY: _____
 COMPANY: _____
 BY: _____ TITLE: _____
 DATE: _____


REUSE OF DOCUMENTS

THIS DOCUMENT AND THE IDEAS INCORPORATED HEREIN, AS AN INSTRUMENT OF PROFESSIONAL SERVICE, IS THE PROPERTY OF HDR AND IS NOT TO BE USED, IN WHOLE OR IN PART, FOR ANY OTHER PROJECT WITHOUT WRITTEN AUTHORIZATION OF HDR.


 HDR Alaska, Inc. CONSULTANT	 W. E. Harty 7/14/09 SEAL	 SWS MUNICIPALITY OF ANCHORAGE SOLID WASTE SERVICES SEAL	MUNICIPALITY OF ANCHORAGE SOLID WASTE SERVICES ANCHORAGE REGIONAL LANDFILL NEW RECYCLING AREA SITE PLAN
			HORIZ. SCALE: AS SHOWN VERT. SCALE: AS SHOWN DATE: MAY 2009 GRID: NAD 83 PROJ. ID: 000006XXXX (SWS)

SHEET 2 OF 7


User: C:\ANALOG May 26, 2009 - 9:21 am
 Drawing: C:\PROJECTS\ANCHORAGE\LANDFILL\ALC\DWG\DWG_01.dwg
 Title: SWS_Plan_02041500.dwg, 1:300 BASE DWG - 11.mxd

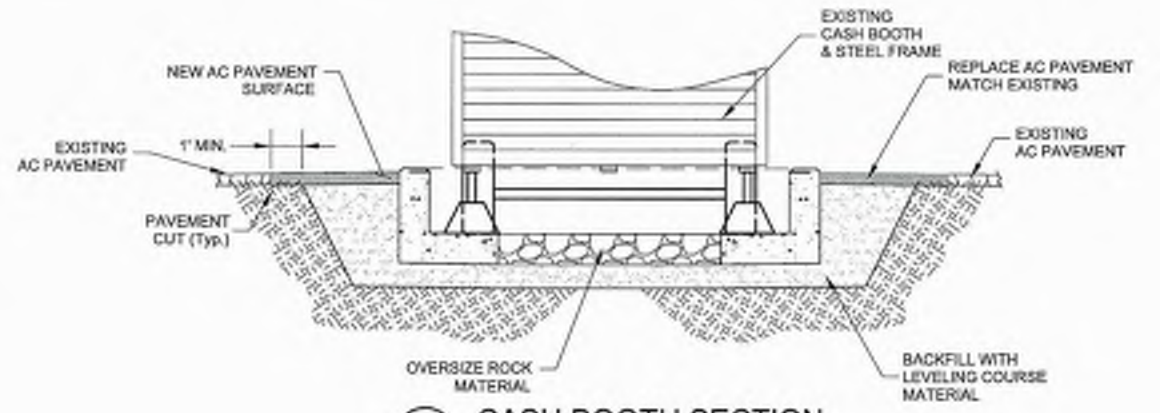


A CASH BOOTH SECTION
1/2" = 1'-0"

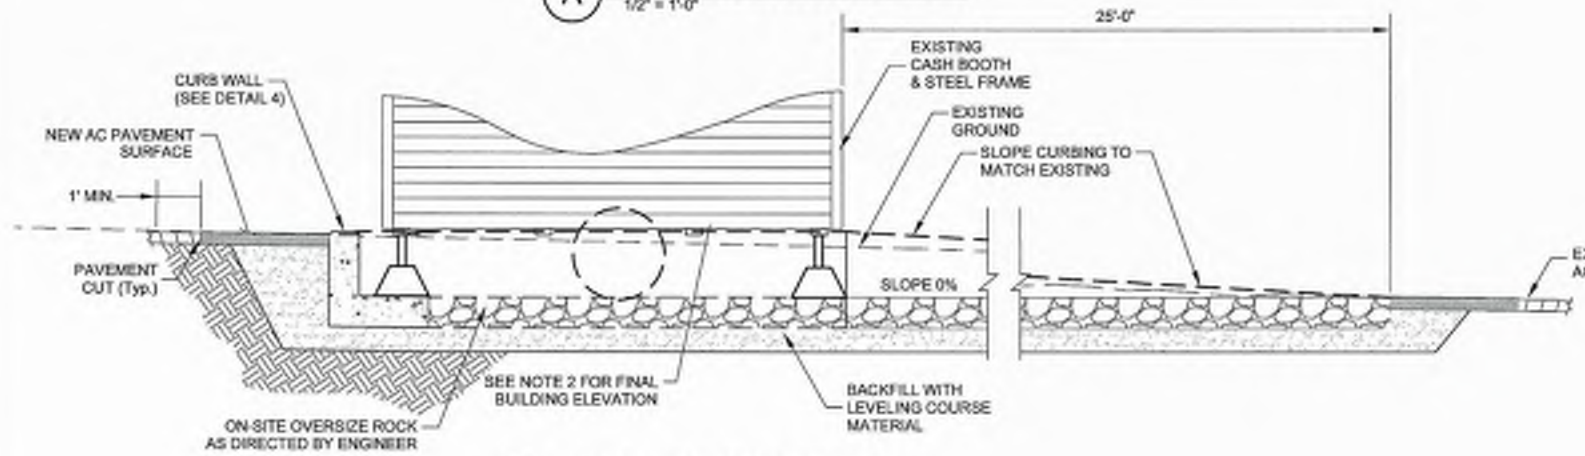


B CASH BOOTH SECTION
1/2" = 1'-0"

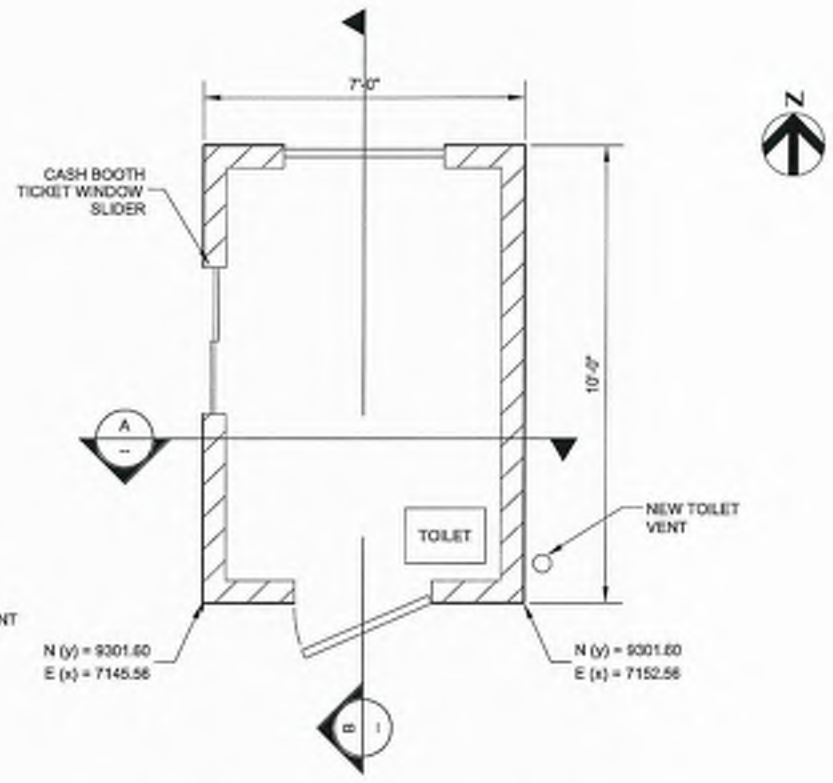


1 RELOCATED CASH BOOTH LAYOUT
2 NOT TO SCALE

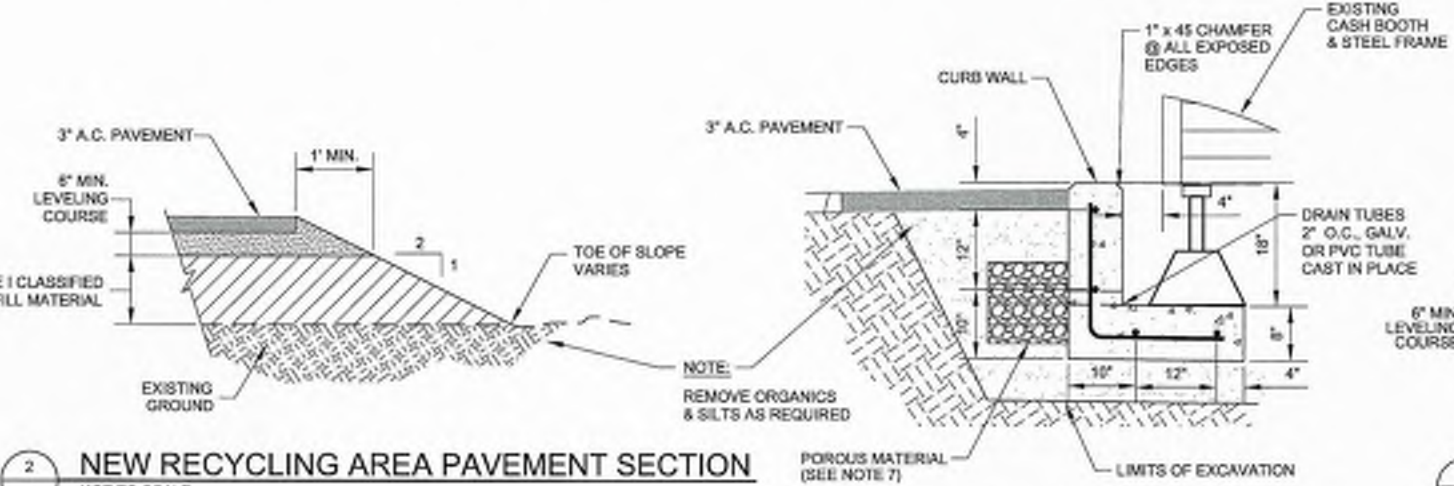

2 NEW RECYCLING AREA PAVEMENT SECTION
2 NOT TO SCALE

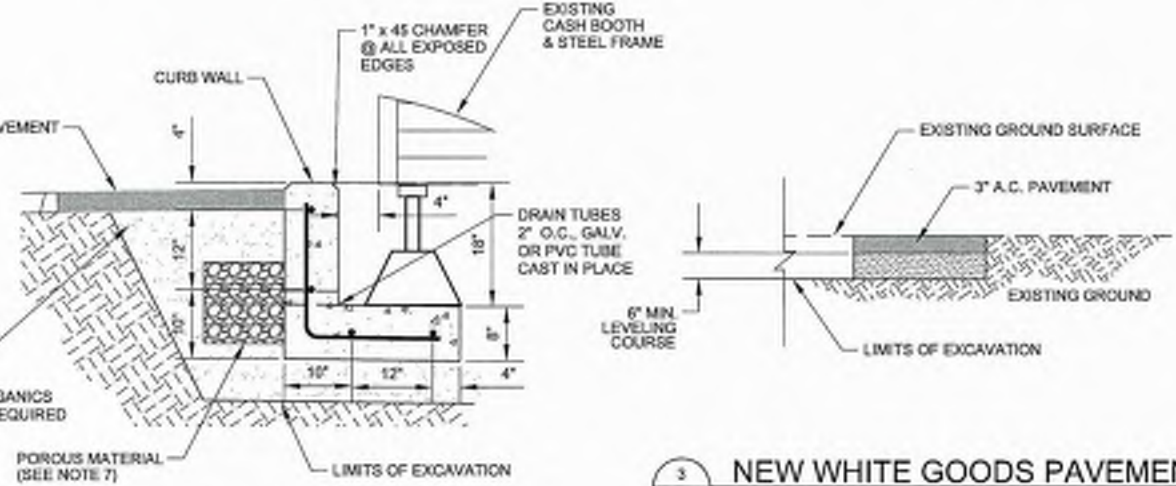

4 CURB WALL DETAIL
NOT TO SCALE

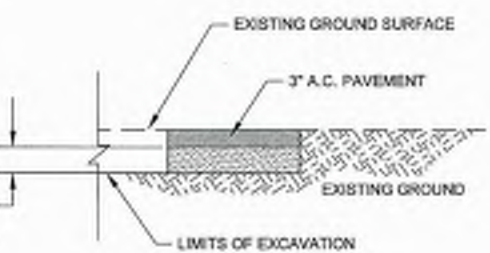

3 NEW WHITE GOODS PAVEMENT SECTION
2 NOT TO SCALE

- NOTES:**
1. VERIFY CASH BOOTH DIMENSIONS PRIOR TO FOUNDATION WORK.
 2. CUT AND REPLACE EXISTING PAVEMENT AND SET CASH BOOTH SUCH THAT SIDE WINDOW SILL IS -42" FROM NEW ASPHALT SURFACE.
 3. SLOPE NEW ASPHALT TO DRAIN NORTH @ 1% MINIMUM SLOPE.
 4. COMPACT BACKFILL TO 95% DRY DENSITY.
 5. LEVEL CASH BOOTH WITH CONCRETE PIERS AS REQUIRED.
 6. INSTALL INCINERATING TOILET WITH PRIVACY CURTAIN IN CASH BOOTH. TOILET TO BE VENTED PER MANUFACTURER'S REQUIREMENTS. INCINOLET MODEL RV OR APPROVED EQUAL. REMOVE CABINETS IN CASH BOOTH ABOVE NEW TOILET.
 7. PLACE ONE CUBIC FOOT OF POROUS BACKFILL MATERIAL AROUND WEEP HOLE AS SHOWN.

DATE: 05/20/2008 10:22AM
DRAWING: C:\PROJECTS\ANCHORAGE REGIONAL LANDFILL\NEW RECYCLING AREA\NEW RECYCLING AREA.DWG
USER: HDR\JL\JL

VERIFY SCALE		RECORD DRAWING	
DATA	DATE	BY	DESCRIPTION
BASE			
TOPOGRAPHY			
PROFILE			
SANITARY SEWER			
STORM SEWER			
WATER			
GRS			

RECORD DRAWING Note: To be filled out on original drawings upon project completion.

1. DATA PROVIDED BY: _____
This will serve to certify that these Record Drawings are a true and accurate representation of the project as constructed.
CONTRACTOR: _____
BY: _____ TITLE: _____
DATE: _____

2. DATA TRANSFERRED BY: _____
COMPANY: _____
DATE: _____

3. Based on periodic field observations by the Engineer (or an individual under his/her direct supervision), the Contractor-provided data appears to represent the project as constructed.
DATA TRANSFER CHECKED BY: _____
BY: _____ TITLE: _____
DATE: _____

REUSE OF DOCUMENTS


THIS DOCUMENT AND THE IDEAS INCORPORATED HEREIN, AS AN INSTRUMENT OF PROFESSIONAL SERVICE, IS THE PROPERTY OF HDR AND IS NOT TO BE USED, IN WHOLE OR IN PART, FOR ANY OTHER PROJECT WITHOUT WRITTEN AUTHORIZATION OF HDR.

HDR
HDR Alaska, Inc.
CONSULTANT


STATE OF ALASKA
49th
WILLIAM I. HARELY
REGISTERED PROFESSIONAL ENGINEER
21974
SEAL

SWS
MUNICIPALITY OF ANCHORAGE
SOLID WASTE SERVICES
SEAL

MUNICIPALITY OF ANCHORAGE SOLID WASTE SERVICES ANCHORAGE REGIONAL LANDFILL NEW RECYCLING AREA			
SECTIONS & DETAILS			
HORIZ. SCALE: AS SHOWN	DATE: MAY 2008	DRW: MCM/MCM	SHEET 3 7
VERT. SCALE: AS SHOWN		MSD/MCM	
PROJECT ID: 00000XKXKX (SWS)			

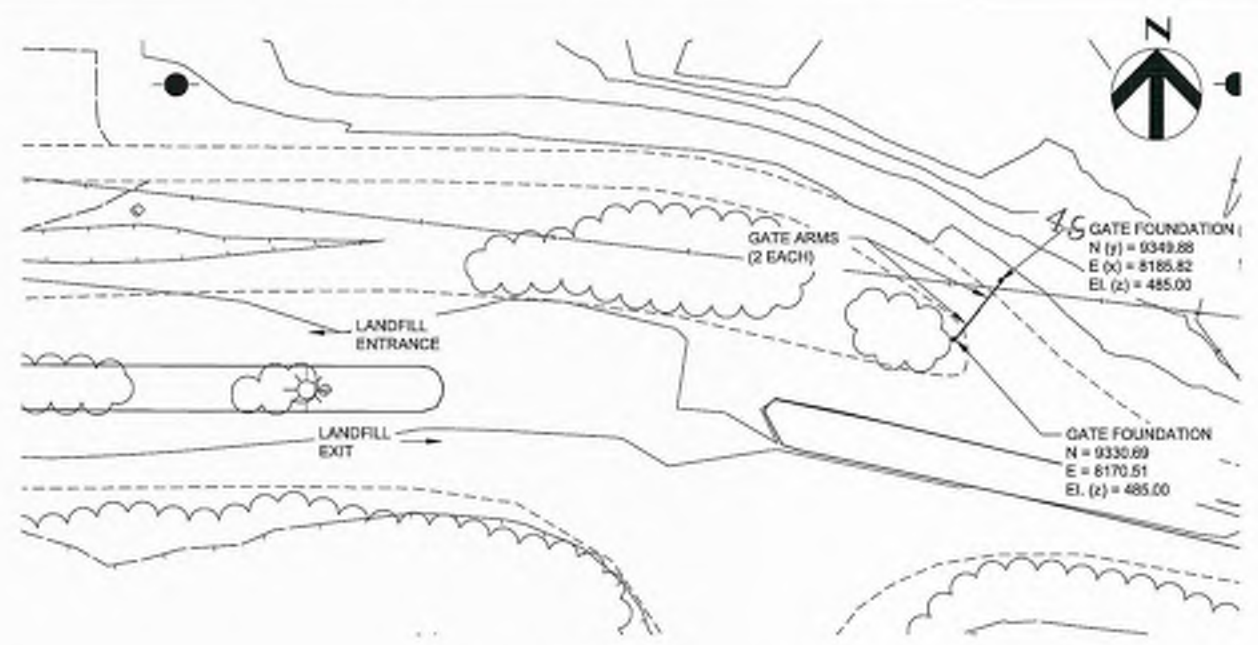

1 PROPOSED PIPE GATE
N.T.S.

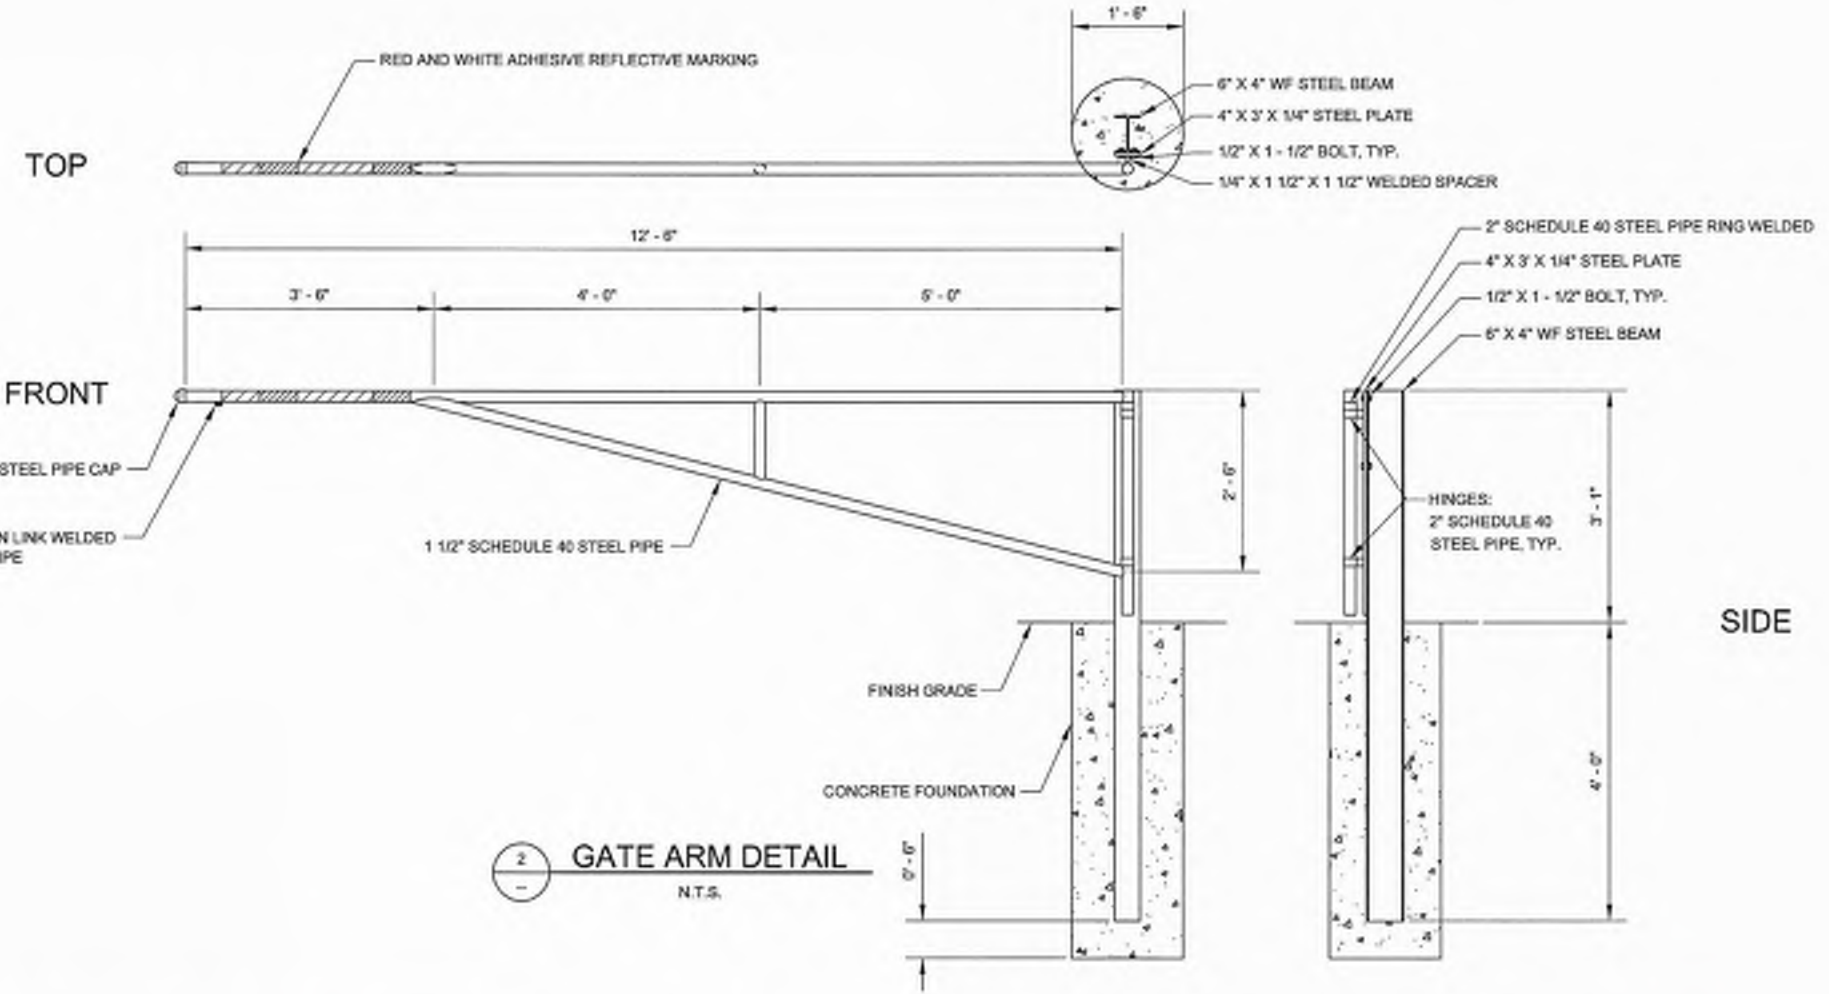

2 GATE ARM DETAIL
N.T.S.

Date: 05/14/2009 10:20:13 AM
 Drawing: C:\WORK\ANCHORAGE\REGIONAL LANDFILL\NEW RECYCLING AREA\LANDFILL\GATE\GATE.DWG
 User: ERL_P\JULIENNE.DUCHEMIN


VERIFY SCALE		THIS BAR REPRESENTS ONE INCH ON ORIGINAL DRAWING.		IF BAR IS NOT ONE INCH, ADJUST DRAWING SCALE ACCORDINGLY.		FULL SIZE SCALE	
DATA	DATE	BY	DATE	BY	DATE	DESCRIPTION	BY
BASE							
TOPOGRAPHY							
PROFILE							
SANITARY SEWER							
STORM SEWER							
WATER							
GAS							
PLAN CHECK		DATE		BY		REVISIONS	

RECORD DRAWING		Note: To be filled out on original drawings upon project completion.	
1. DATA PROVIDED BY: _____			
This will serve to certify that these Record Drawings are a true and accurate representation of the project as constructed.			
CONTRACTOR: _____			
BY: _____ TITLE: _____			
DATE: _____			
2. DATA TRANSFERRED BY: _____			
COMPANY: _____			
DATE: _____			
3. Based on periodic field observations by the Engineer (or an individual under his/her direct supervision), the Contractor-provided data appears to represent the project as constructed.			
DATA TRANSFER CHECKED BY: _____			
BY: _____ TITLE: _____			
COMPANY: _____			
DATE: _____			

REUSE OF DOCUMENTS
THIS DOCUMENT AND THE IDEAS INCORPORATED HEREIN, AS AN INSTRUMENT OF PROFESSIONAL SERVICE, IS THE PROPERTY OF SWS AND IS NOT TO BE USED, IN WHOLE OR IN PART, FOR ANY OTHER PROJECT WITHOUT WRITTEN AUTHORIZATION OF SWS.




MUNICIPALITY OF ANCHORAGE SOLID WASTE SERVICES ANCHORAGE REGIONAL LANDFILL NEW RECYCLING AREA			
GATE DETAIL			
HORIZ. SCALE: AS SHOWN	DATE: MAY 2009	GRID: MOM WCA1	SHEET 4
VERT. SCALE: AS SHOWN		MOOR: MOA2	7
PROJECT ID: 0000063000 (SWS)			

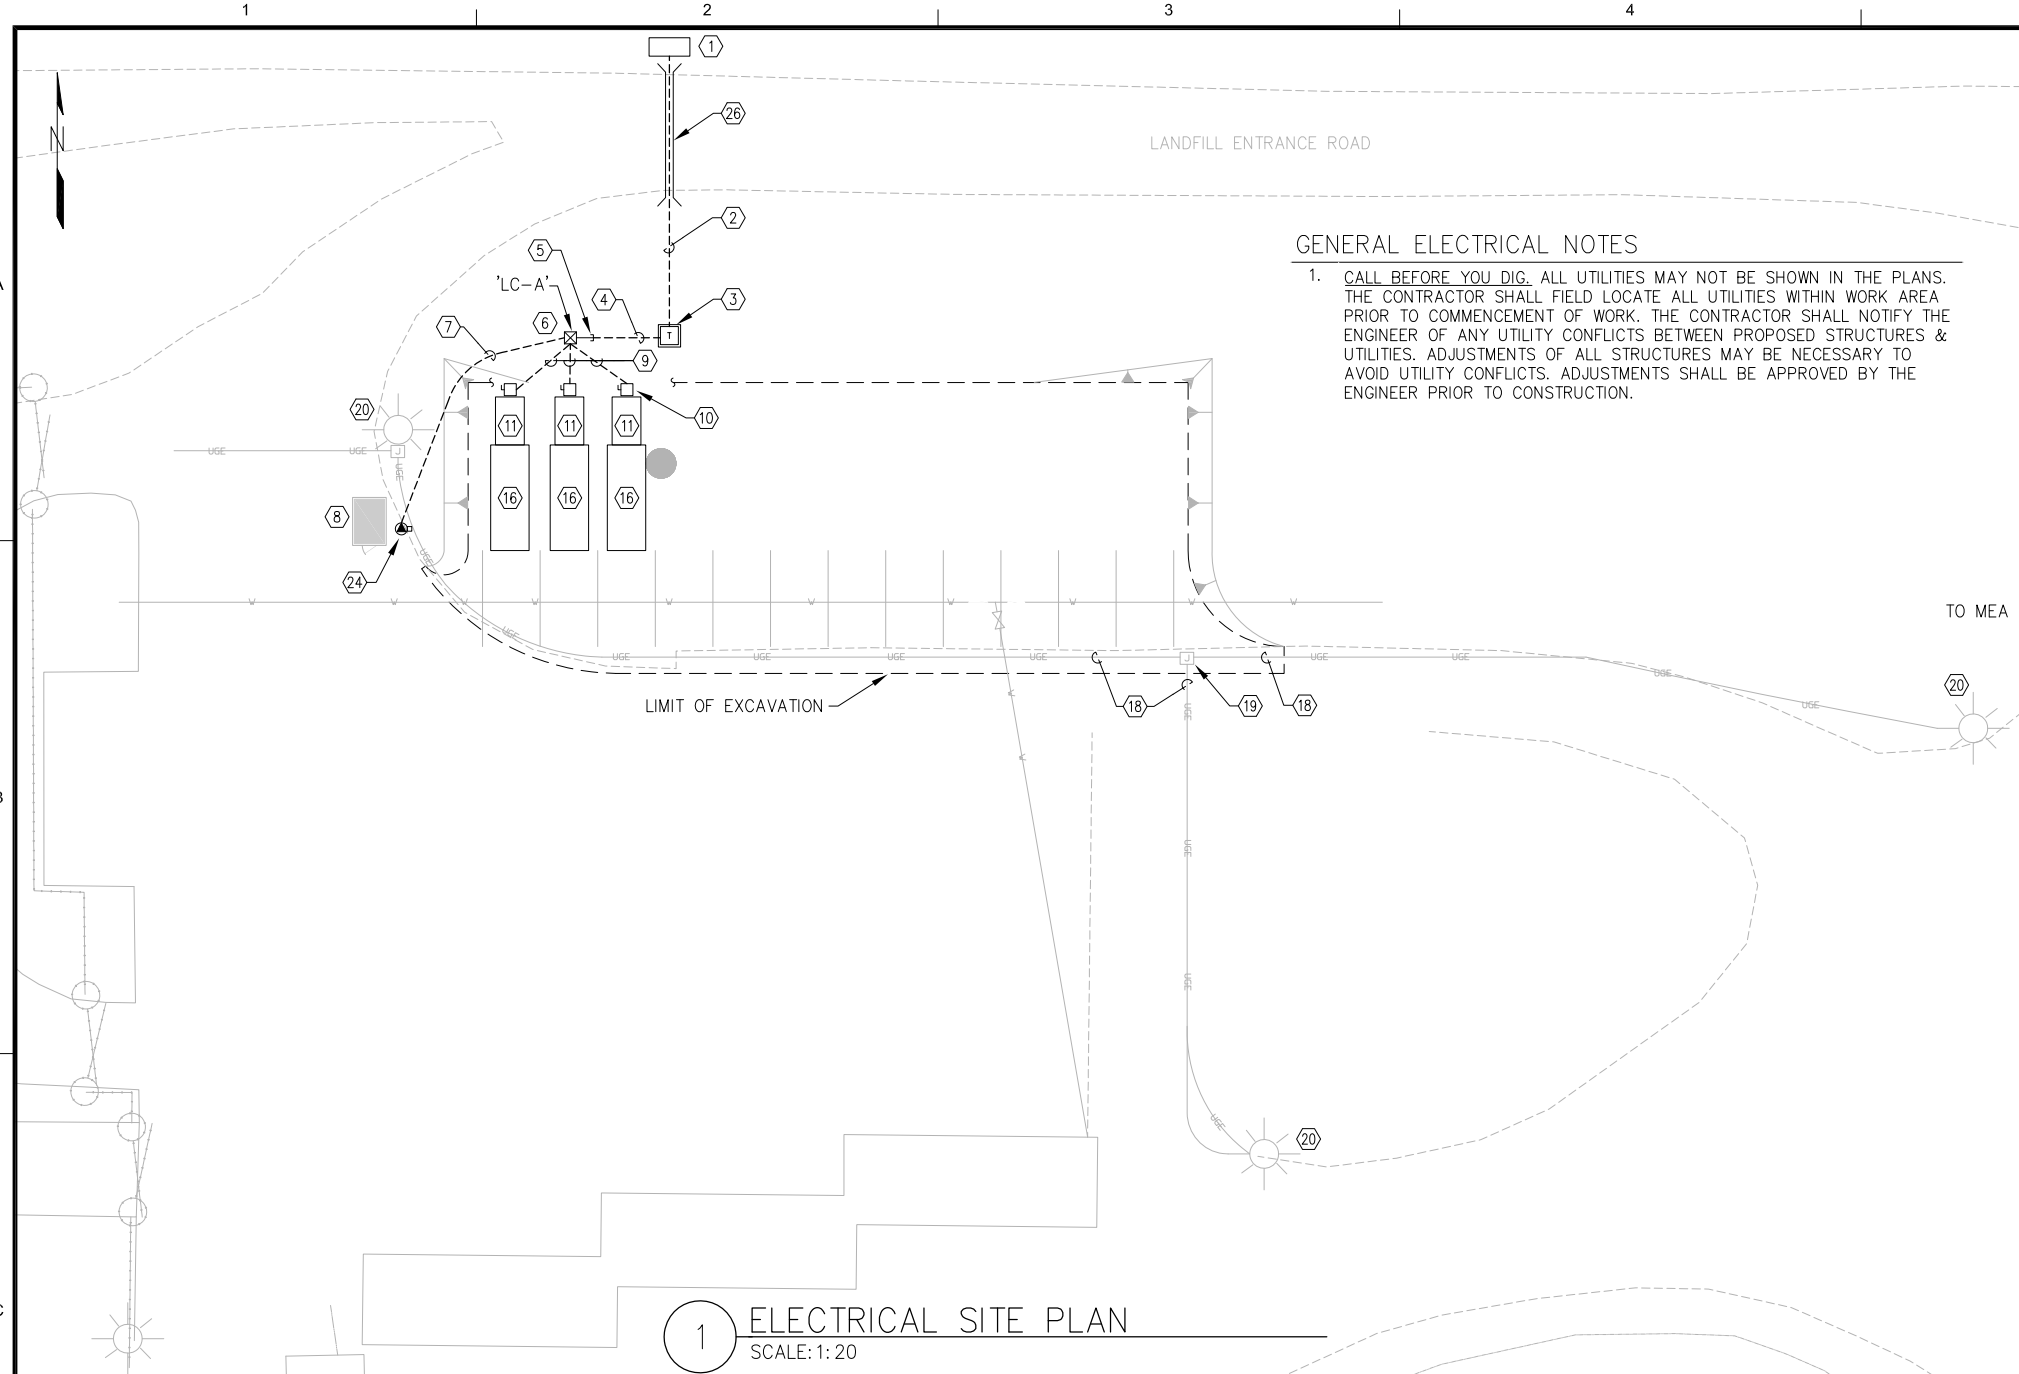

GENERAL ELECTRICAL NOTES

1. CALL BEFORE YOU DIG. ALL UTILITIES MAY NOT BE SHOWN IN THE PLANS. THE CONTRACTOR SHALL FIELD LOCATE ALL UTILITIES WITHIN WORK AREA PRIOR TO COMMENCEMENT OF WORK. THE CONTRACTOR SHALL NOTIFY THE ENGINEER OF ANY UTILITY CONFLICTS BETWEEN PROPOSED STRUCTURES & UTILITIES. ADJUSTMENTS OF ALL STRUCTURES MAY BE NECESSARY TO AVOID UTILITY CONFLICTS. ADJUSTMENTS SHALL BE APPROVED BY THE ENGINEER PRIOR TO CONSTRUCTION.

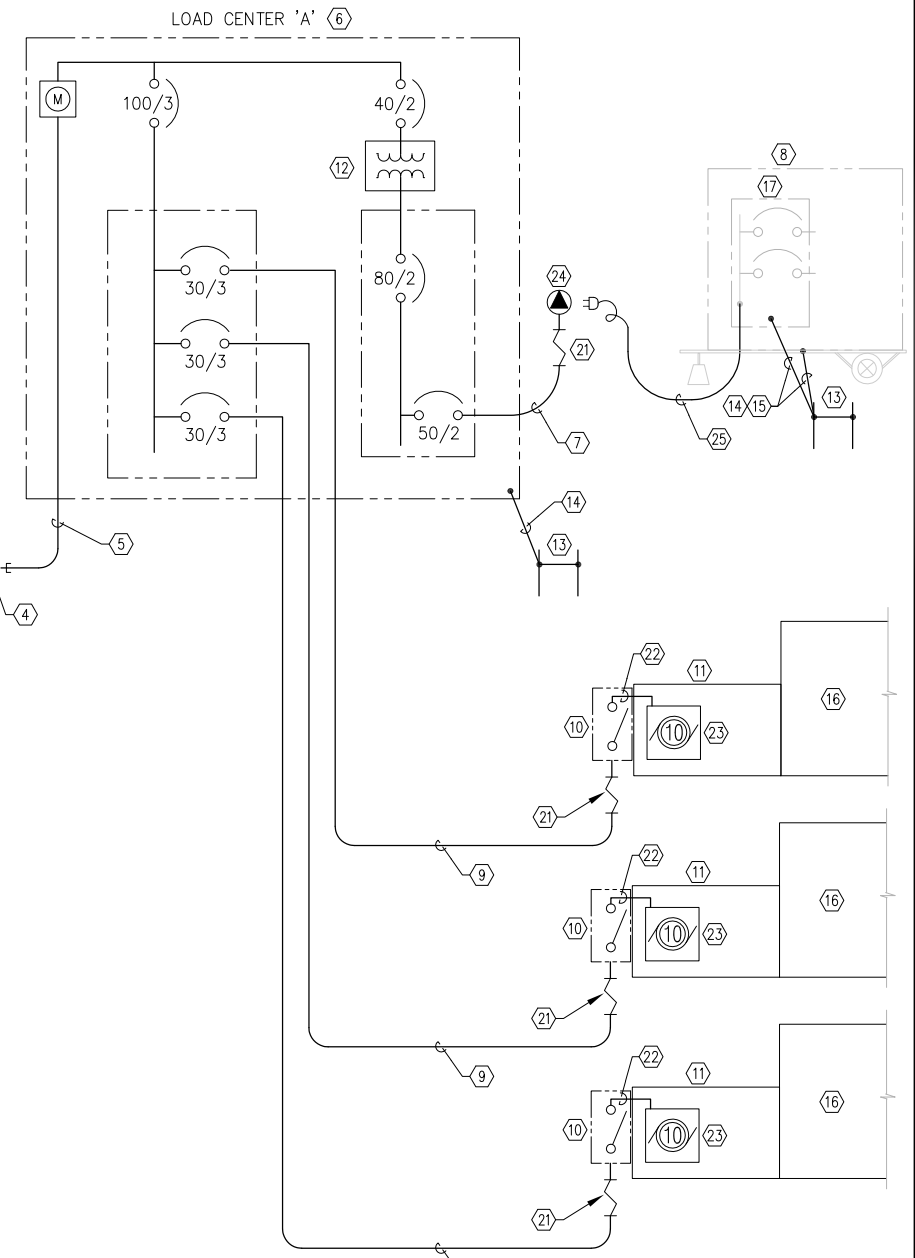

1 ELECTRICAL SITE PLAN
SCALE: 1:20

2 POWER ONE-LINE
SCALE: NTS

SHEET NOTES

- ① EXISTING MEA PRIMARY JUNCTION BOX #AER2020.
- ② PRIMARY UNDERGROUND 3Ø LINE EXTENSION BY MEA.
- ③ 12,470:480V, 3Ø PAD MOUNT TRANSFORMER BY MEA.
- ④ SERVICE LATERALS BY MEA.
- ⑤ 4" GRC CONDUIT STUB-OUT FOR SERVICE LATERALS. COORDINATE W/ MEA. MEA CONTACT: BILL WEST (907)761-9302.
- ⑥ 200A, 480V, 3Ø, TYPE 1 LOAD CENTER.
- ⑦ 1" C, 3#8 (2H,N) & 1#10 (G).
- ⑧ RE-LOCATED CASH BOOTH, SEE DETAIL SHEET 7.
- ⑨ 1" C, 5#10 (3H,N,G).
- ⑩ 30A, 480V, 3-POLE, NEMA 3R DISCONNECT SWITCH, SQUARE D CAT# HU361RB OR EQUAL. MOUNT TO SIDE OF COMPACTOR.

- ⑪ STATIONARY, 480V, 10HP, 3Ø COMPACTOR.
- ⑫ 480V:120/240V, 1Ø, 15kVA TRANSFORMER.
- ⑬ GROUNDING SYSTEM. (2) 3/4"x10' COPPER CLAD STEEL GROUND RODS SEPARATED 10' MIN, IMBEDDED A MINIMUM OF 12" BELOW GRADE AND INTERCONNECTED W/ 2/0 BCU BURIED A MINIMUM OF 30". ALL BELOW GRADE CONNECTIONS SHALL BE EXTOTHERMICALLY WELDED.
- ⑭ #6 BCU.
- ⑮ BOND TO GROUND BUS IN CASH BOOTH PANELBOARD AND TO CASH BOOTH METAL FRAME.
- ⑯ REMOVABLE RECYCLING CONTAINER.
- ⑰ CASH BOOTH PANELBOARD. REMOVE ANY BONDS BETWEEN THE NEUTRAL AND GROUND BUSES.
- ⑱ EXISTING AREA LIGHTING CIRCUIT. REMOVE CONDUIT WITHIN THE LIMITS OF EXCAVATION. REMOVE CONDUCTORS BACK TO THE NEAREST LIGHTING FIXTURE. AFTER EXCAVATION IS COMPLETE, RE-INSTALL 2" CONDUIT AND PULL IN NEW 3C#6 CONDUCTORS TO RE-CONNECT THE EXISTING LIGHTS.
- ⑲ EXISTING JUNCTION BOX TO BE REMOVED AND REPLACED.

- ⑳ EXISTING AREA LIGHTING FIXTURE.
- ㉑ PROVIDE SECTION OF LTF ABOVE GRADE TO ALLOW FOR MOVEMENT.
- ㉒ 3/4" LTF, 5#10 (3H,N,G). CONNECT TO COMPACTOR'S POWER UNIT.
- ㉓ COMPACTOR POWER UNIT.
- ㉔ POST MOUNTED RECEPTACLE FOR CASH BOOTH. SEE DETAIL ON SHEET 7.
- ㉕ HEAVY DUTY, ARCTIC GRADE, TYPE SOOW CORD, 3C#8 W/ GROUND. PROVIDE W/ STRAIN RELIEF AT CONNECTION TO CASH BOOTH PANELBOARD.
- ㉖ 6" SCHEDULE 40 PVC OR HDPE CONDUIT TO BE PLACED UNDER ROADWAY TO FACILITATE INSTALLATION OF MEA LINE EXTENSION CONDUCTORS. CONDUIT SHALL BE BURIED A MINIMUM OF 48". ENDS SHALL BE CAPPED AND LOCATIONS MARKED WITH AN ABOVE GRADE MARKER POST.

May 27, 2009 - 3:41 PM
 Drawing: C:\PROJECTS\HDR\ARL\DRWG\SELE01.DWG - Layout: E1
 Xrefs: SWS_FLN2234.DWG TOPO BASE.DWG - Images

VERIFY SCALE		THIS BAR REPRESENTS ONE INCH ON ORIGINAL DRAWING.		0" — 1"	IF BAR IS NOT ONE INCH, ADJUST DRAWING SCALE ACCORDINGLY.	FULL SIZE SCALE HORZ.: NA VERT.: NA			
DATA	DRAWN BY	CHECKED BY	DATA	DRAWN BY	CHECKED BY	REV	DATE	DESCRIPTION	BY
BASE TOPOGRAPHY			TELEPHONE						
PROFILE			ELECTRIC						
SANITARY SEWER			CABLE TV						
STORM SEWER			TRAFFIC SIGNAL						
DESIGN			DESIGN						
WATER			QUANTITIES						
GAS			MUN. FINAL CHECK						
PLAN CHECK					REVISIONS				

RECORD DRAWING Note: To be filled out on original drawings upon project completion.


1. DATA PROVIDED BY: _____
 This will serve to certify that these Record Drawings are a true and accurate representation of the project as constructed.
 CONTRACTOR: _____
 BY: _____ TITLE: _____
 DATE: _____

2. DATA TRANSFERRED BY: _____
 COMPANY: _____
 DATE: _____

3. Based on periodic field observations by the Engineer (or an Individual under his/her direct supervision), the Contractor-provided data appears to represent the project as constructed.
 DATA TRANSFER CHECKED BY: _____
 COMPANY: _____
 BY: _____ TITLE: _____
 DATE: _____

REUSE OF DOCUMENTS


THIS DOCUMENT AND THE IDEAS INCORPORATED HEREIN, AS AN INSTRUMENT OF PROFESSIONAL SERVICE, IS THE PROPERTY OF SWS AND IS NOT TO BE USED, IN WHOLE OR IN PART, FOR ANY OTHER PROJECT WITHOUT WRITTEN AUTHORIZATION OF SWS.

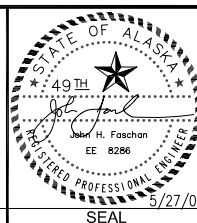


MUNICIPALITY OF ANCHORAGE
 SOLID WASTE SERVICES
 ANCHORAGE REGIONAL LANDFILL
 NEW RECYCLING AREA

ELECTRICAL SITE PLAN & POWER ONE-LINE


HORIZ SCALE: AS SHOWN DATE: MAY, 2009 GRID: MOA4 MOA1 MOA3 MOA2
 VERT SCALE: AS SHOWN
 PROJ. ID. 00000XXXX (SWS) SHEET 5 of 7

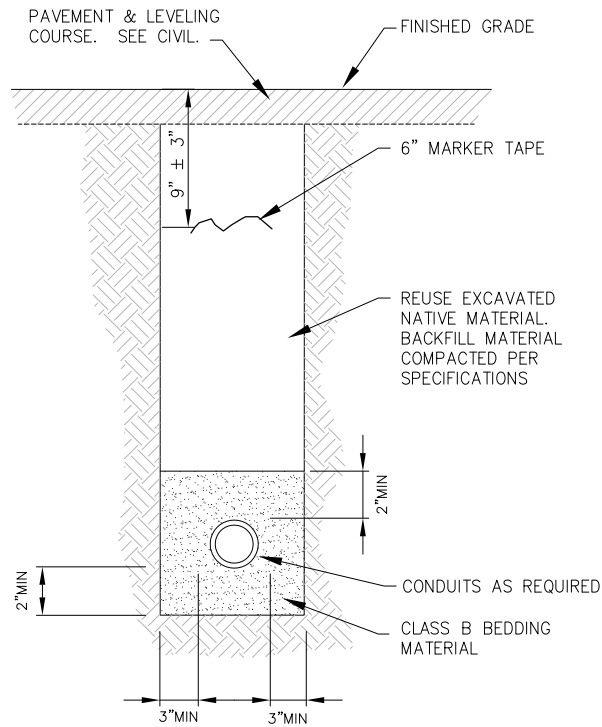

1 CONDUIT BURIAL SECTION
SCALE: NTS

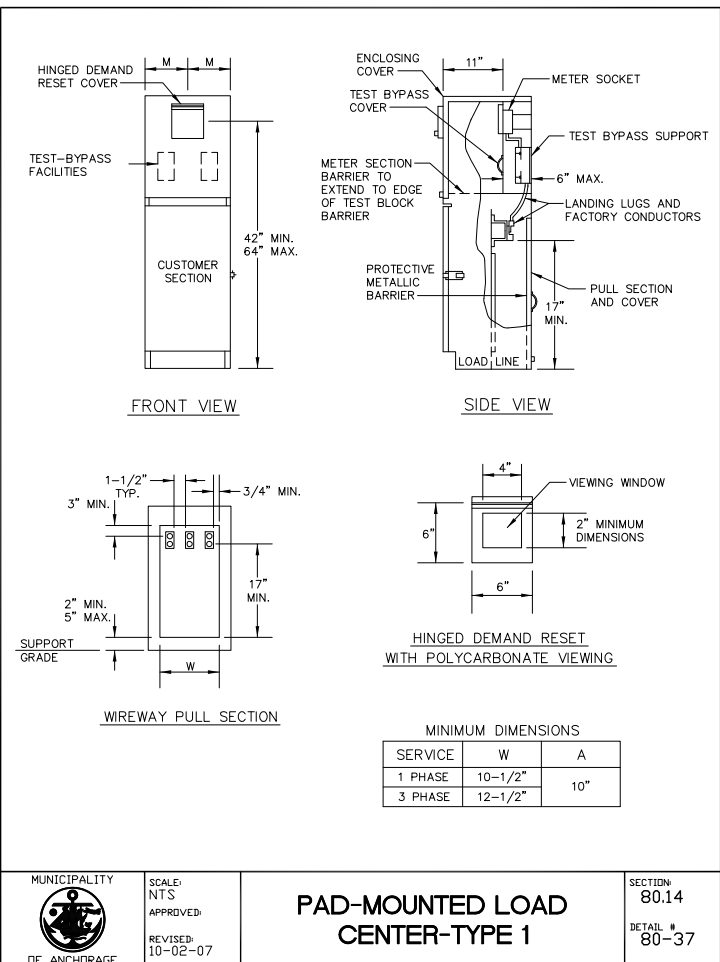


PAD-MOUNTED LOAD CENTER-TYPE 1

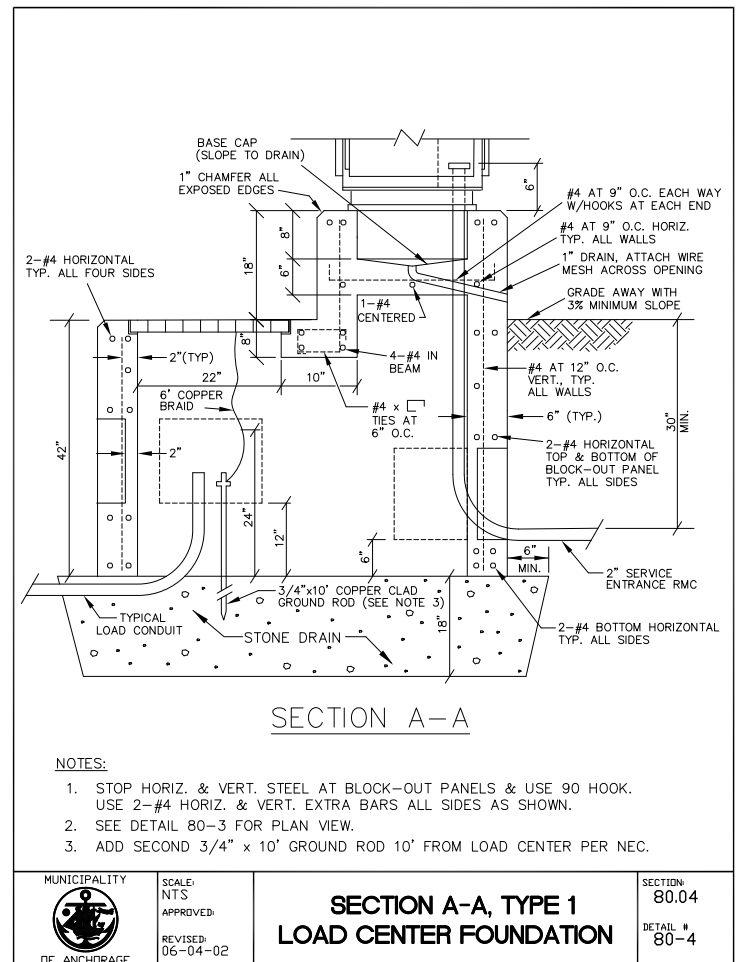

NOTES:

- STOP HORIZ. & VERT. STEEL AT BLOCK-OUT PANELS & USE 90 HOOK. USE 2-#4 HORIZ. & VERT. EXTRA BARS ALL SIDES AS SHOWN.
- SEE DETAIL 80-3 FOR PLAN VIEW.
- ADD SECOND 3/4" x 10" GROUND ROD 10' FROM LOAD CENTER PER NEC.

SECTION A-A, TYPE 1 LOAD CENTER FOUNDATION

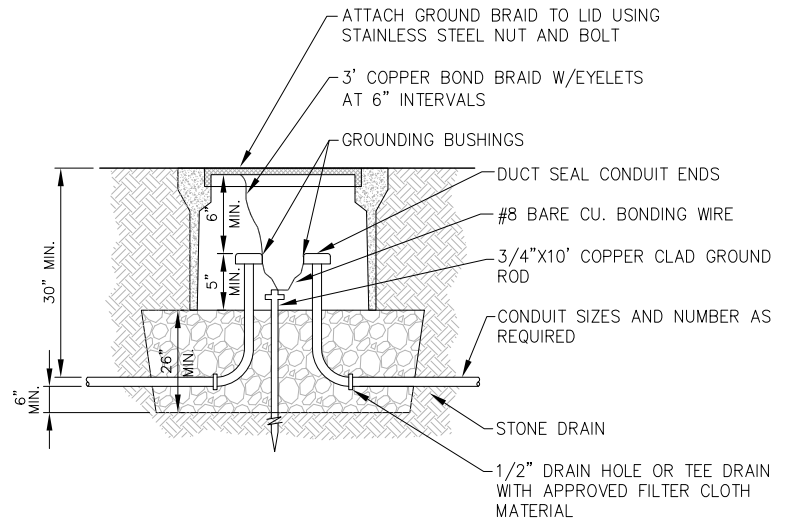

2 TYPE 1A JUNCTION BOX DETAIL
SCALE: NTS

LOAD CENTER "A" SUMMARY: TYPE 1 INSTALLATION										
Load Center Location: STA "XX" xx+xx Offset xx.x'						Power Source: MEA				
Service: Three Phase, 4 Wire, 277/480V W/Gnd Neutral						Meter Socket Req'd: Y				
LOAD	Main Breakers	Contactor	Contactor Control	P. E. Control location:						
A	480 Volt 3 Poles 100 Amps			None						
B	480 Volt 2 Poles 40 Amps									
PANEL A - 277/480V										
Pole	Amp/Trip	Description	kVA	AØ	BØ	CØ	kVA	Description	Amp/Trip	Pole
1	40/2	480:240V Transformer	0.0	3.7			3.7	Compactor #2	40/3	2
3			0.0		3.7		3.7		4	
5			0.0			3.7	3.7		6	
7	40/3	Compactor #1	3.7	7.4			3.7	Compactor #3	40/3	8
9			3.7		7.4		3.7		10	
11			3.7			7.4	3.7		12	
13			0.0	0.0			0.0			14
15			0.0		0.0		0.0			16
17			0.0			0.0	0.0			18
			11.1	11.1	11.1					
PANEL B - 120/240V										
Pole	Amp/Trip	Description	kVA	AØ	BØ	CØ	kVA	Description	Amp/Trip	Pole
1	80/2	Main Circuit Breaker	0.0	2.9			2.9	Cash Booth	50/2	2
3			0.0		2.9		2.9		4	
5			0.0	0.0			0.0			6
7			0.0		0.0		0.0			8
9			0.0	0.0			0.0			10
11			0.0		0.0		0.0			12
13			0.0	0.0			0.0			14
15			0.0		0.0		0.0			16
17			0.0	0.0			0.0			18
19			0.0		0.0		0.0			20
			2.9	2.9						
Total kVA=								39.1		
Amps=								147.1		

May 27, 2009 - 3:43pm
 Drawing: C:\PROJECTS\HDR\ARLDR\MS\LELE01.DWG - Layout: E2
 Xrefs: SWS_FLN2234.DWG TOPO BASE.DWG - Images

VERIFY SCALE		THIS BAR REPRESENTS ONE INCH ON ORIGINAL DRAWING.		0" = 1"		IF BAR IS NOT ONE INCH, ADJUST DRAWING SCALE ACCORDINGLY.		FULL SIZE SCALE	
DATA	DRAWN BY	CHECKED BY	DATE	REV	DATE	DESCRIPTION	BY	DATE	DESCRIPTION
BASE									
TOPOGRAPHY									
PROFILE									
SANITARY SEWER									
STORM SEWER									
WATER									
GAS									
PLAN CHECK					REVISIONS				

RECORD DRAWING Note: To be filled out on original drawings upon project completion.

1. DATA PROVIDED BY: _____

This will serve to certify that these Record Drawings are a true and accurate representation of the project as constructed.

CONTRACTOR: _____

BY: _____ TITLE: _____

DATE: _____

2. DATA TRANSFERRED BY: _____

COMPANY: _____

DATE: _____

3. Based on periodic field observations by the Engineer (or an Individual under his/her direct supervision), the Contractor-provided data appears to represent the project as constructed.

DATA TRANSFER CHECKED BY: _____

COMPANY: _____

BY: _____ TITLE: _____

DATE: _____

REUSE OF DOCUMENTS

THIS DOCUMENT AND THE IDEAS INCORPORATED HEREIN, AS AN INSTRUMENT OF PROFESSIONAL SERVICE, IS THE PROPERTY OF SWS AND IS NOT TO BE USED, IN WHOLE OR IN PART, FOR ANY OTHER PROJECT WITHOUT WRITTEN AUTHORIZATION OF SWS.

EDC, INC.
 213 W. FIREWEED LANE
 ANCHORAGE, AK 99503
 (907) 276-7933
 CONSULTANT

STATE OF ALASKA
 49th
 John H. Faschan
 EE 8286
 REGISTERED PROFESSIONAL ENGINEER
 3/27/09
 SEAL

MUNICIPALITY OF ANCHORAGE
 SOLID WASTE SERVICES

MUNICIPALITY OF ANCHORAGE
 SOLID WASTE SERVICES
 ANCHORAGE REGIONAL LANDFILL
 NEW RECYCLING AREA


ELECTRICAL DETAILS AND PANEL SCHEDULE

HORIZ SCALE: AS SHOWN DATE: MAY, 2009 GRID: MOA4 MOA1 MOA3 MOA2
 VERT SCALE: AS SHOWN
 PROJ. ID. 00000XXXX (SWS)


SHEET 6 of 7

SHEET NOTES

- ① EXISTING CASH BOOTH 120/240V, SQUARE D PANELBOARD 'A'. PROVIDE NEW 20A SINGLE POLE CIRCUIT BREAKER IN AVAILABLE SPACE FOR THE NEW INCINERATING TOILET.
- ② REMOVE EXISTING CORD AND PLUG FEEDING THE CASH BOOTH PANELBOARD AND REPLACE W/ NEW CORD AND PLUG AS SHOWN ON THE ONE-LINE ON SHEET 5. PROVIDE LARGER PENETRATION FOR THE NEW CORD THROUGH THE FLOOR AS NECESSARY. SEAL AROUND FLOOR PENETRATION AND PROPERLY SECURE CORD.
- ③ EXISTING RECEPTACLE TO BE REMOVED. SPLICE TOGETHER CONDUCTORS TO MAINTAIN CIRCUIT FEEDING DOWNSTREAM RECEPTACLES. PROVIDE BLANK COVER FOR OUTLET BOX.
- ④ PROVIDE NEW 20A, 120V, GFCI RECEPTACLE FOR NEW INCINERATING TOILET. RECEPTACLE SHALL BE ON IT'S OWN DEDICATED CIRCUIT. CIRCUIT MAY BE RUN IN SURFACE MOUNTED EMT IN CHASE BEHIND PANELBOARD 'A'.
- ⑤ 1/2" C, 3#12 (H,N,G).

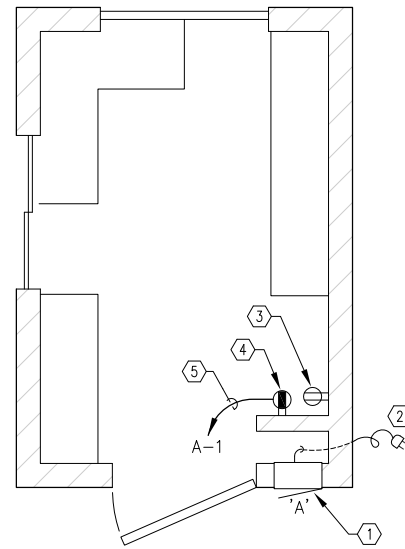

1 CASH BOOTH ELECTRICAL PLAN
SCALE: NTS

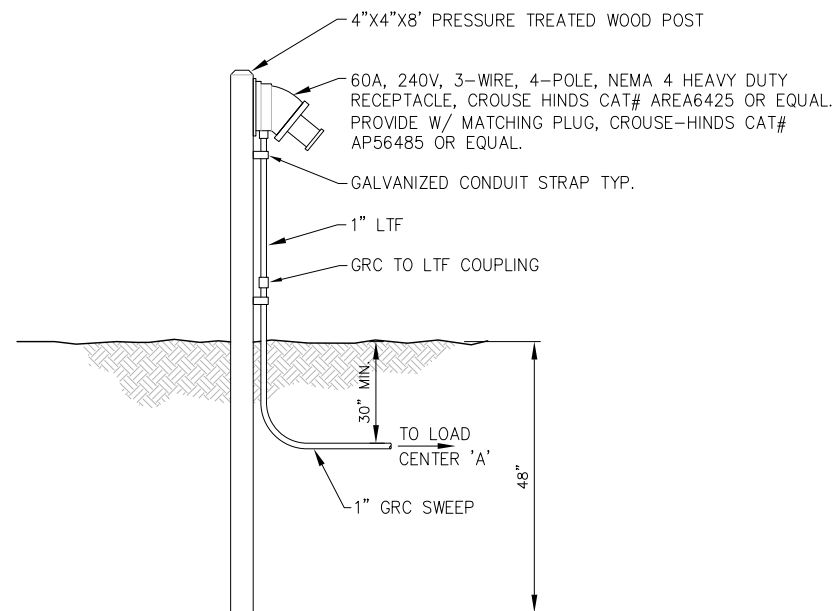

2 CASH BOOTH RECEPTACLE POST DETAIL
SCALE: NTS

May 27, 2009 - 3:42pm
 Drawing: C:\PROJECTS\HDR\ALASKA\DRM\CS\ELE01.DWG - Layout: E3
 Xrefs: SWS_PLN22X34.DWG TOPO BASE.DWG - Inlogis

VERIFY SCALE		THIS BAR REPRESENTS ONE INCH ON ORIGINAL DRAWING.		0" 1"	IF BAR IS NOT ONE INCH, ADJUST DRAWING SCALE ACCORDINGLY.	FULL SIZE SCALE HORZ.: NA VERT.: NA			
DATA	DRAWN BY	CHECKED BY	DATA	DRAWN BY	CHECKED BY	REV	DATE	DESCRIPTION	BY
BASE			TELEPHONE						
TOPOGRAPHY			ELECTRIC						
PROFILE			CABLE TV						
SANITARY SEWER			TRAFFIC SIGNAL						
STORM SEWER			DESIGN						
WATER			QUANTITIES						
GAS			MUN. FINAL CHECK						
PLAN CHECK					REVISIONS				

RECORD DRAWING		Note: To be filled out on original drawings upon project completion.
1. DATA PROVIDED BY:	_____	3. Based on periodic field observations by the Engineer (or an individual under his/her direct supervision), the Contractor-provided data appears to represent the project as constructed.
This will serve to certify that these Record Drawings are a true and accurate representation of the project as constructed.		
CONTRACTOR:	_____	DATA TRANSFER CHECKED BY: _____
BY: _____	TITLE: _____	COMPANY: _____
DATE: _____		BY: _____
		DATE: _____
2. DATA TRANSFERRED BY: _____		
COMPANY: _____		
DATE: _____		

REUSE OF DOCUMENTS

THIS DOCUMENT AND THE IDEAS INCORPORATED HEREIN, AS AN INSTRUMENT OF PROFESSIONAL SERVICE, IS THE PROPERTY OF SWS AND IS NOT TO BE USED, IN WHOLE OR IN PART, FOR ANY OTHER PROJECT WITHOUT WRITTEN AUTHORIZATION OF SWS.

EDC, INC.
213 W. FIREWEED LANE
ANCHORAGE, AK 99503
(907) 276-7933
CONSULTANT

MUNICIPALITY OF ANCHORAGE
SOLID WASTE SERVICES
ANCHORAGE REGIONAL LANDFILL
NEW RECYCLING AREA

ELECTRICAL DETAILS

HORZ SCALE: AS SHOWN	DATE: MAY, 2009	GRID: MOA4 MOA1 MOA3 MOA2	SHEET 7 of 7
PROJ. ID. 00000XXXX (SWS)			